



**SPECIAL PROVISION(DURABLE 4 INCH WHITE LINE, POLYUREA)(28 MILS)**  
W 11+00 TO W 16+67 SOLID LT  
W 11+00 TO W 22+00 SOLID RT  
W 16+98 TO W 22+00 SOLID LT

**TEMPORARY 4 INCH WHITE LINE, PAINT**  
W 11+00 TO W 16+45 SOLID LT  
W 11+00 TO W 22+00 SOLID RT  
W 17+22 TO W 22+00 SOLID LT

**SPECIAL PROVISION(DURABLE 4 INCH YELLOW LINE, POLYUREA)(28 MILS)**  
W 11+00 TO W 16+64 SOLID LT & RT  
W 16+84 DOUBLE SOLID LT (TH 51)  
W 17+04 TO W 22+00 SOLID LT & RT

**TEMPORARY 4 INCH YELLOW LINE, PAINT**  
W 11+00 TO W 16+64 SOLID LT & RT  
W 16+84 DOUBLE SOLID LT (TH 51)  
W 17+04 TO W 22+00 SOLID LT & RT

**MILLED RUMBLE STRIPS (CENTERLINE)**  
W 11+00 TO W 16+64 CL  
W 17+04 TO W 22+00 CL

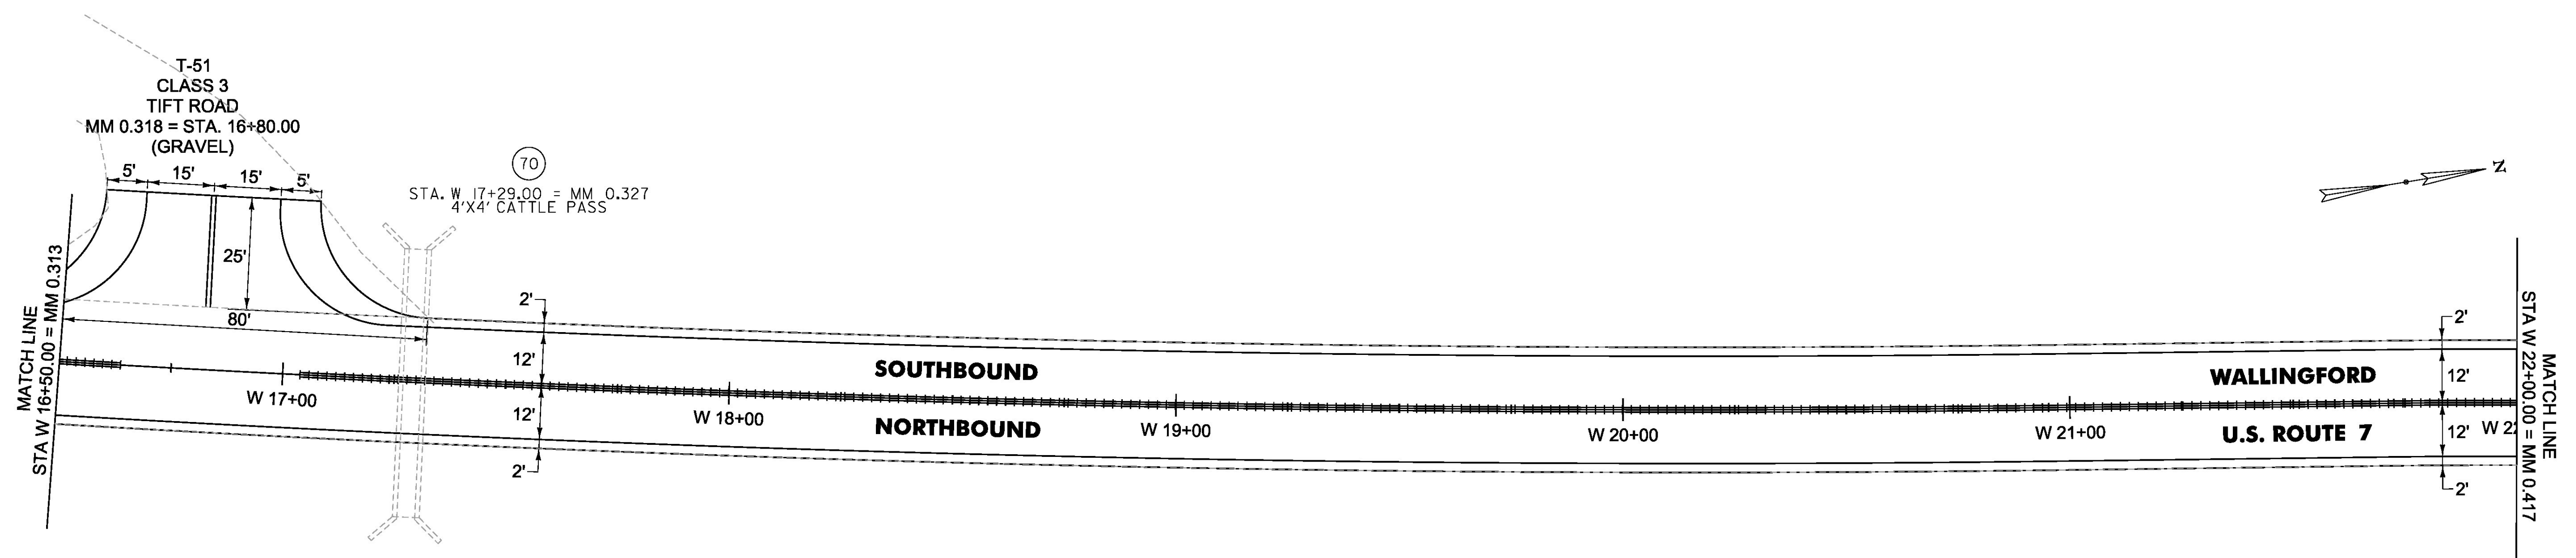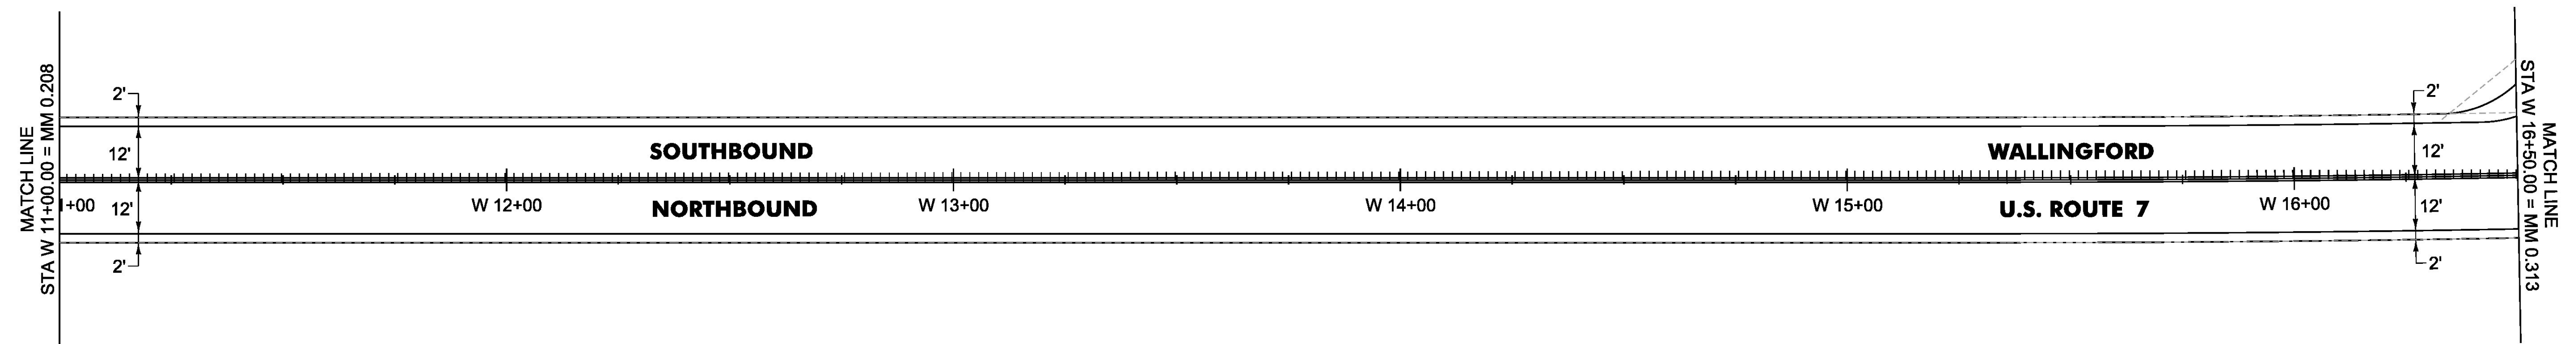

**NOT TO SCALE**

PROJECT NAME:	MANCHESTER-RUTLAND TOWN
PROJECT NUMBER:	NH SURF(50)
FILE NAME: layout15.dgn	PLOT DATE: 1/14/2016
PROJECT LEADER: M. FOWLER	DRAWN BY: B. KIPP
DESIGNED BY: B. KIPP	CHECKED BY: M. FOWLER
PLAN SHEET 15	SHEET 29 OF 105