



SPECIAL PROVISION(DURABLE 4 INCH WHITE LINE,  
POLYUREA)(28 MILS)  
W 44+00 TO W 55+00 SOLID LT & RT

TEMPORARY 4 INCH WHITE LINE, PAINT  
W 44+00 TO W 55+00 SOLID LT & RT

SPECIAL PROVISION(DURABLE 4 INCH YELLOW LINE,  
POLYUREA)(28 MILS)  
W 44+00 TO W 55+00 SOLID LT & RT

TEMPORARY 4 INCH YELLOW LINE, PAINT  
W 44+00 TO W 55+00 SOLID LT & RT

MILLED RUMBLE STRIPS (CENTERLINE)  
W 44+00 TO W 51+50 CL

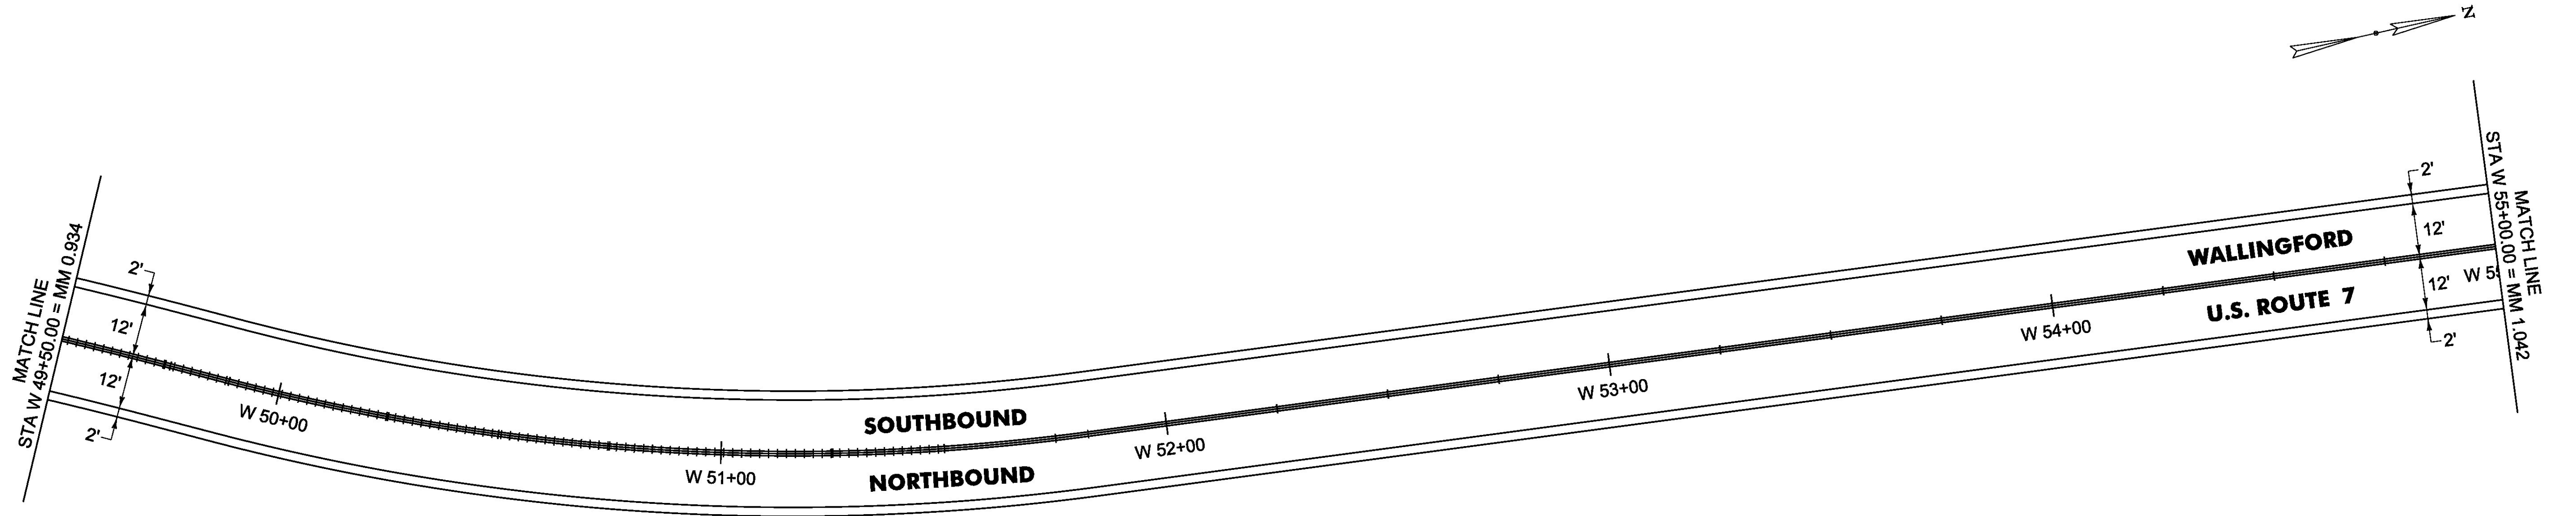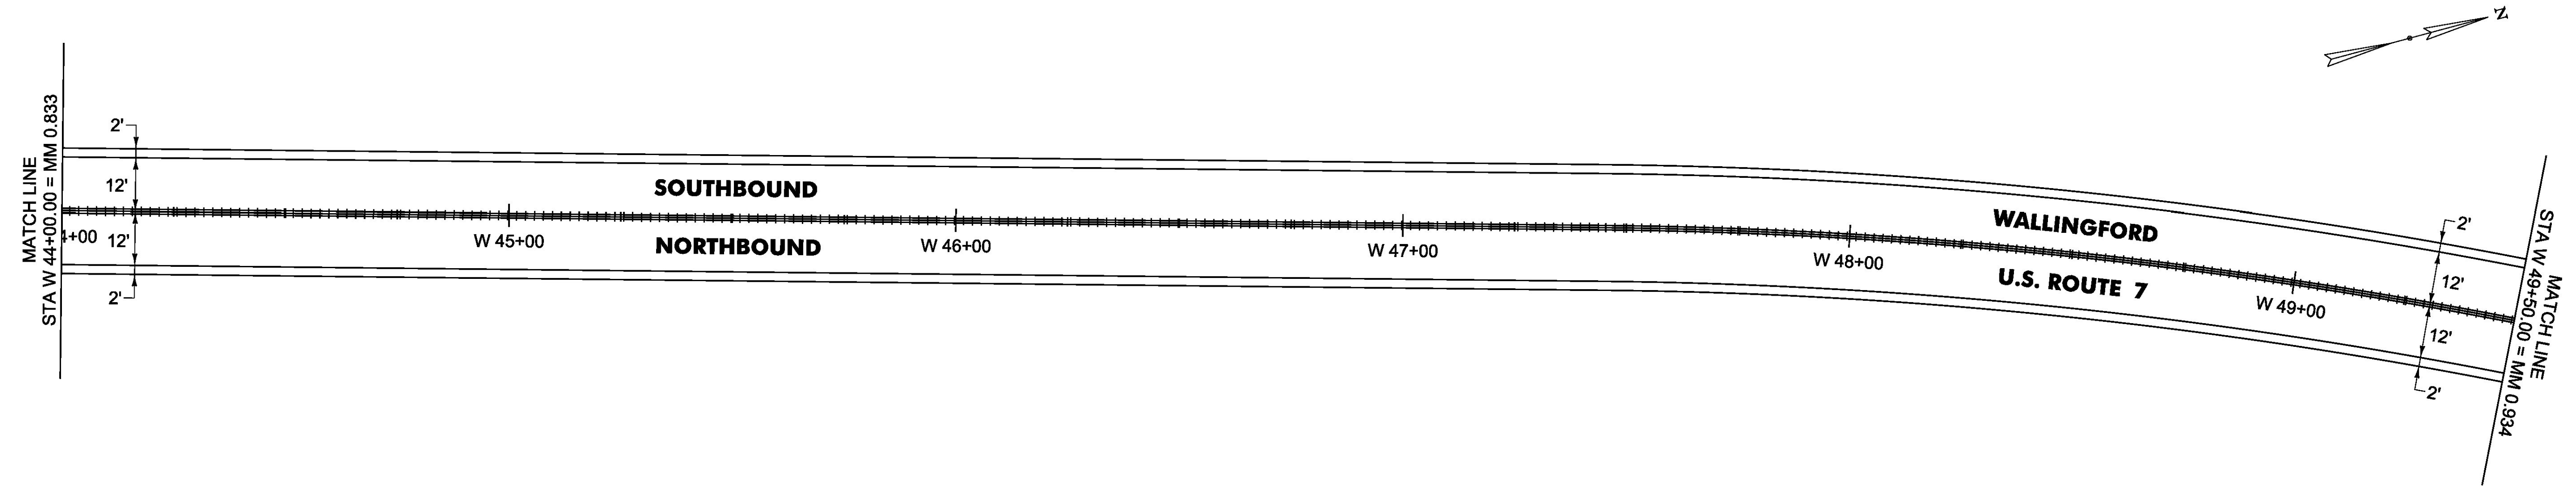

NOT TO SCALE

PROJECT NAME:	MANCHESTER-RUTLAND TOWN
PROJECT NUMBER:	NH SURF(50)
FILE NAME:	layout18.dgn
PROJECT LEADER:	M. FOWLER
DESIGNED BY:	B. KIPP
PLAN SHEET 18	
PLOT DATE:	1/14/2016
DRAWN BY:	B. KIPP
CHECKED BY:	M. FOWLER
SHEET 32	OF 105