
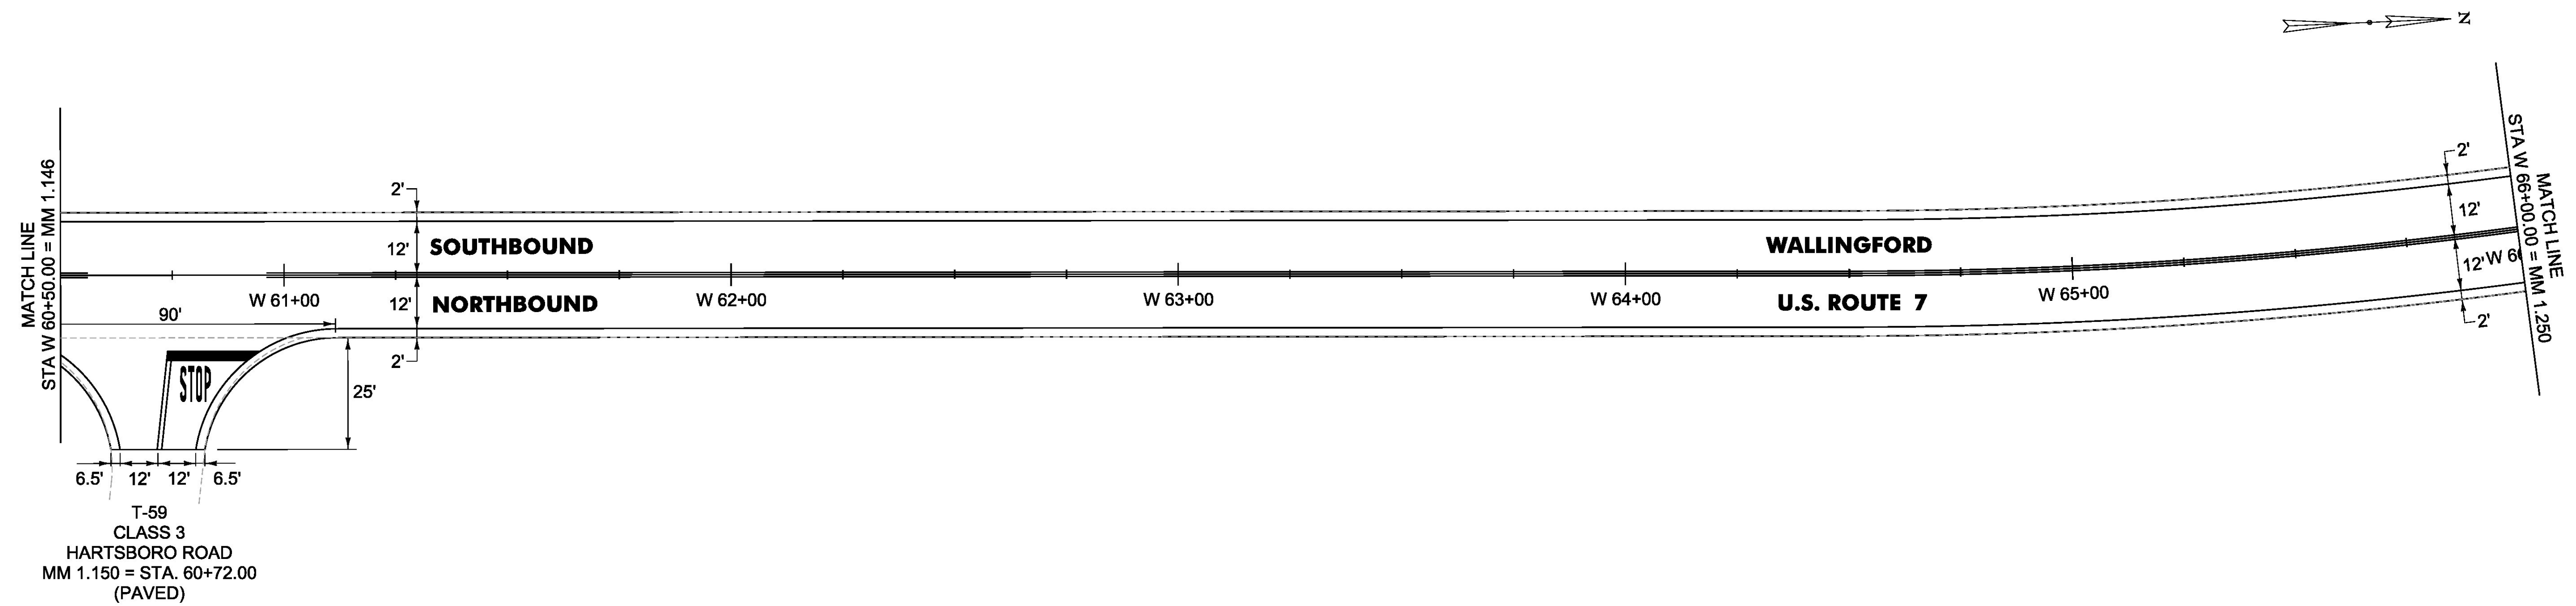


SPECIAL PROVISION(DURABLE 4 INCH WHITE LINE, POLYUREA)(28 MILS)  
 W 55+00 TO W 66+00 SOLID LT  
 W 55+00 TO W 66+63 SOLID RT  
 W 60+80 TO W 66+00 SOLID RT  
 TEMPORARY 4 INCH WHITE LINE, PAINT  
 W 55+00 TO W 66+00 SOLID LT  
 W 55+00 TO W 66+63 SOLID RT  
 W 60+80 TO W 66+00 SOLID RT

SPECIAL PROVISION(DURABLE 4 INCH YELLOW LINE, POLYUREA)(28 MILS)  
 W 55+00 TO W 60+56 SOLID LT & RT  
 W 60+76 DOUBLE SOLID RT (TH 59)  
 W 60+96 TO W 66+00 SOLID LT & RT  
 TEMPORARY 4 INCH YELLOW LINE, PAINT  
 W 55+00 TO W 60+56 SOLID LT & RT  
 W 60+76 DOUBLE SOLID RT (TH 59)  
 W 60+96 TO W 66+00 SOLID LT & RT

SPECIAL PROVISION(DURABLE 24 INCH STOP BAR, POLYUREA)(28 MILS)  
 W 60+76 TO W 60+75 RT (TH 59)  
 TEMPORARY 24 INCH STOP BAR, PAINT  
 W 60+76 TO W 60+75 RT (TH 59)

SPECIAL PROVISION(DURABLE LETTER OR SYMBOL, POLYUREA)(28 MILS)  
 W 60+80 RT "STOP" (TH 59) (4 EA)  
 TEMPORARY LETTER OR SYMBOL, PAINT  
 W 60+80 RT "STOP" (TH 59) (4 EA)

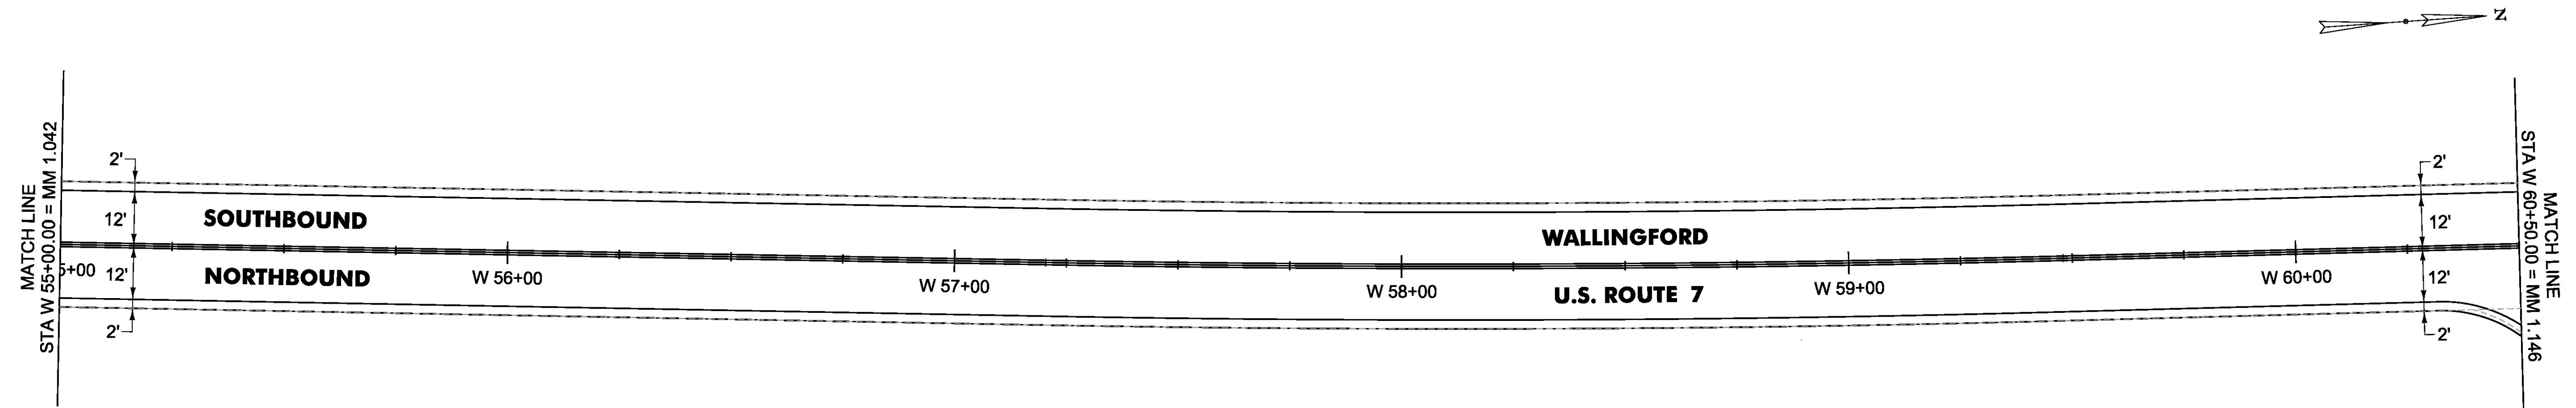

T-59  
 CLASS 3  
 HARTSBORO ROAD  
 MM 1.150 = STA. 60+72.00  
 (PAVED)

NOT TO SCALE

PROJECT NAME:	MANCHESTER-RUTLAND TOWN
PROJECT NUMBER:	NH SURF(50)
FILE NAME:	layout19.dgn
PROJECT LEADER:	M. FOWLER
DESIGNED BY:	B. KIPP
PLAN SHEET 19	
PLOT DATE:	1/14/2016
DRAWN BY:	B. KIPP
CHECKED BY:	M. FOWLER
SHEET 33	OF 105