

SPECIAL PROVISION(DURABLE 4 INCH WHITE LINE, POLYUREA)(28 MILS)
W 66+00 TO W 68+70 SOLID LT
W 66+00 TO W 77+00 SOLID RT
W 68+80 TO W 77+00 SOLID RT

TEMPORARY 4 INCH WHITE LINE, PAINT
W 66+00 TO W 68+70 SOLID LT
W 66+00 TO W 77+00 SOLID RT
W 68+80 TO W 77+00 SOLID RT

SPECIAL PROVISION(DURABLE 4 INCH YELLOW LINE, POLYUREA)(28 MILS)
W 66+00 TO W 68+30 SOLID LT & RT
W 68+50 TO W 68+75 DOUBLE SOLID LT (TH 48)
W 68+70 TO W 77+00 SOLID LT & RT


TEMPORARY 4 INCH YELLOW LINE, PAINT
W 66+00 TO W 68+30 SOLID LT & RT
W 68+50 TO W 68+75 DOUBLE SOLID LT (TH 48)
W 68+70 TO W 77+00 SOLID LT & RT

SPECIAL PROVISION(DURABLE 24 INCH STOP BAR, POLYUREA)(28 MILS)
W 68+16 TO W 60+51 LT (TH 48)

TEMPORARY 24 INCH STOP BAR, PAINT
W 68+16 TO W 60+51 LT (TH 48)

SPECIAL PROVISION(DURABLE LETTER OR SYMBOL, POLYUREA)(28 MILS)
W 68+43 LT "STOP" (TH 48) (4 EA)

TEMPORARY LETTER OR SYMBOL, PAINT
W 68+43 LT "STOP" (TH 48) (4 EA)

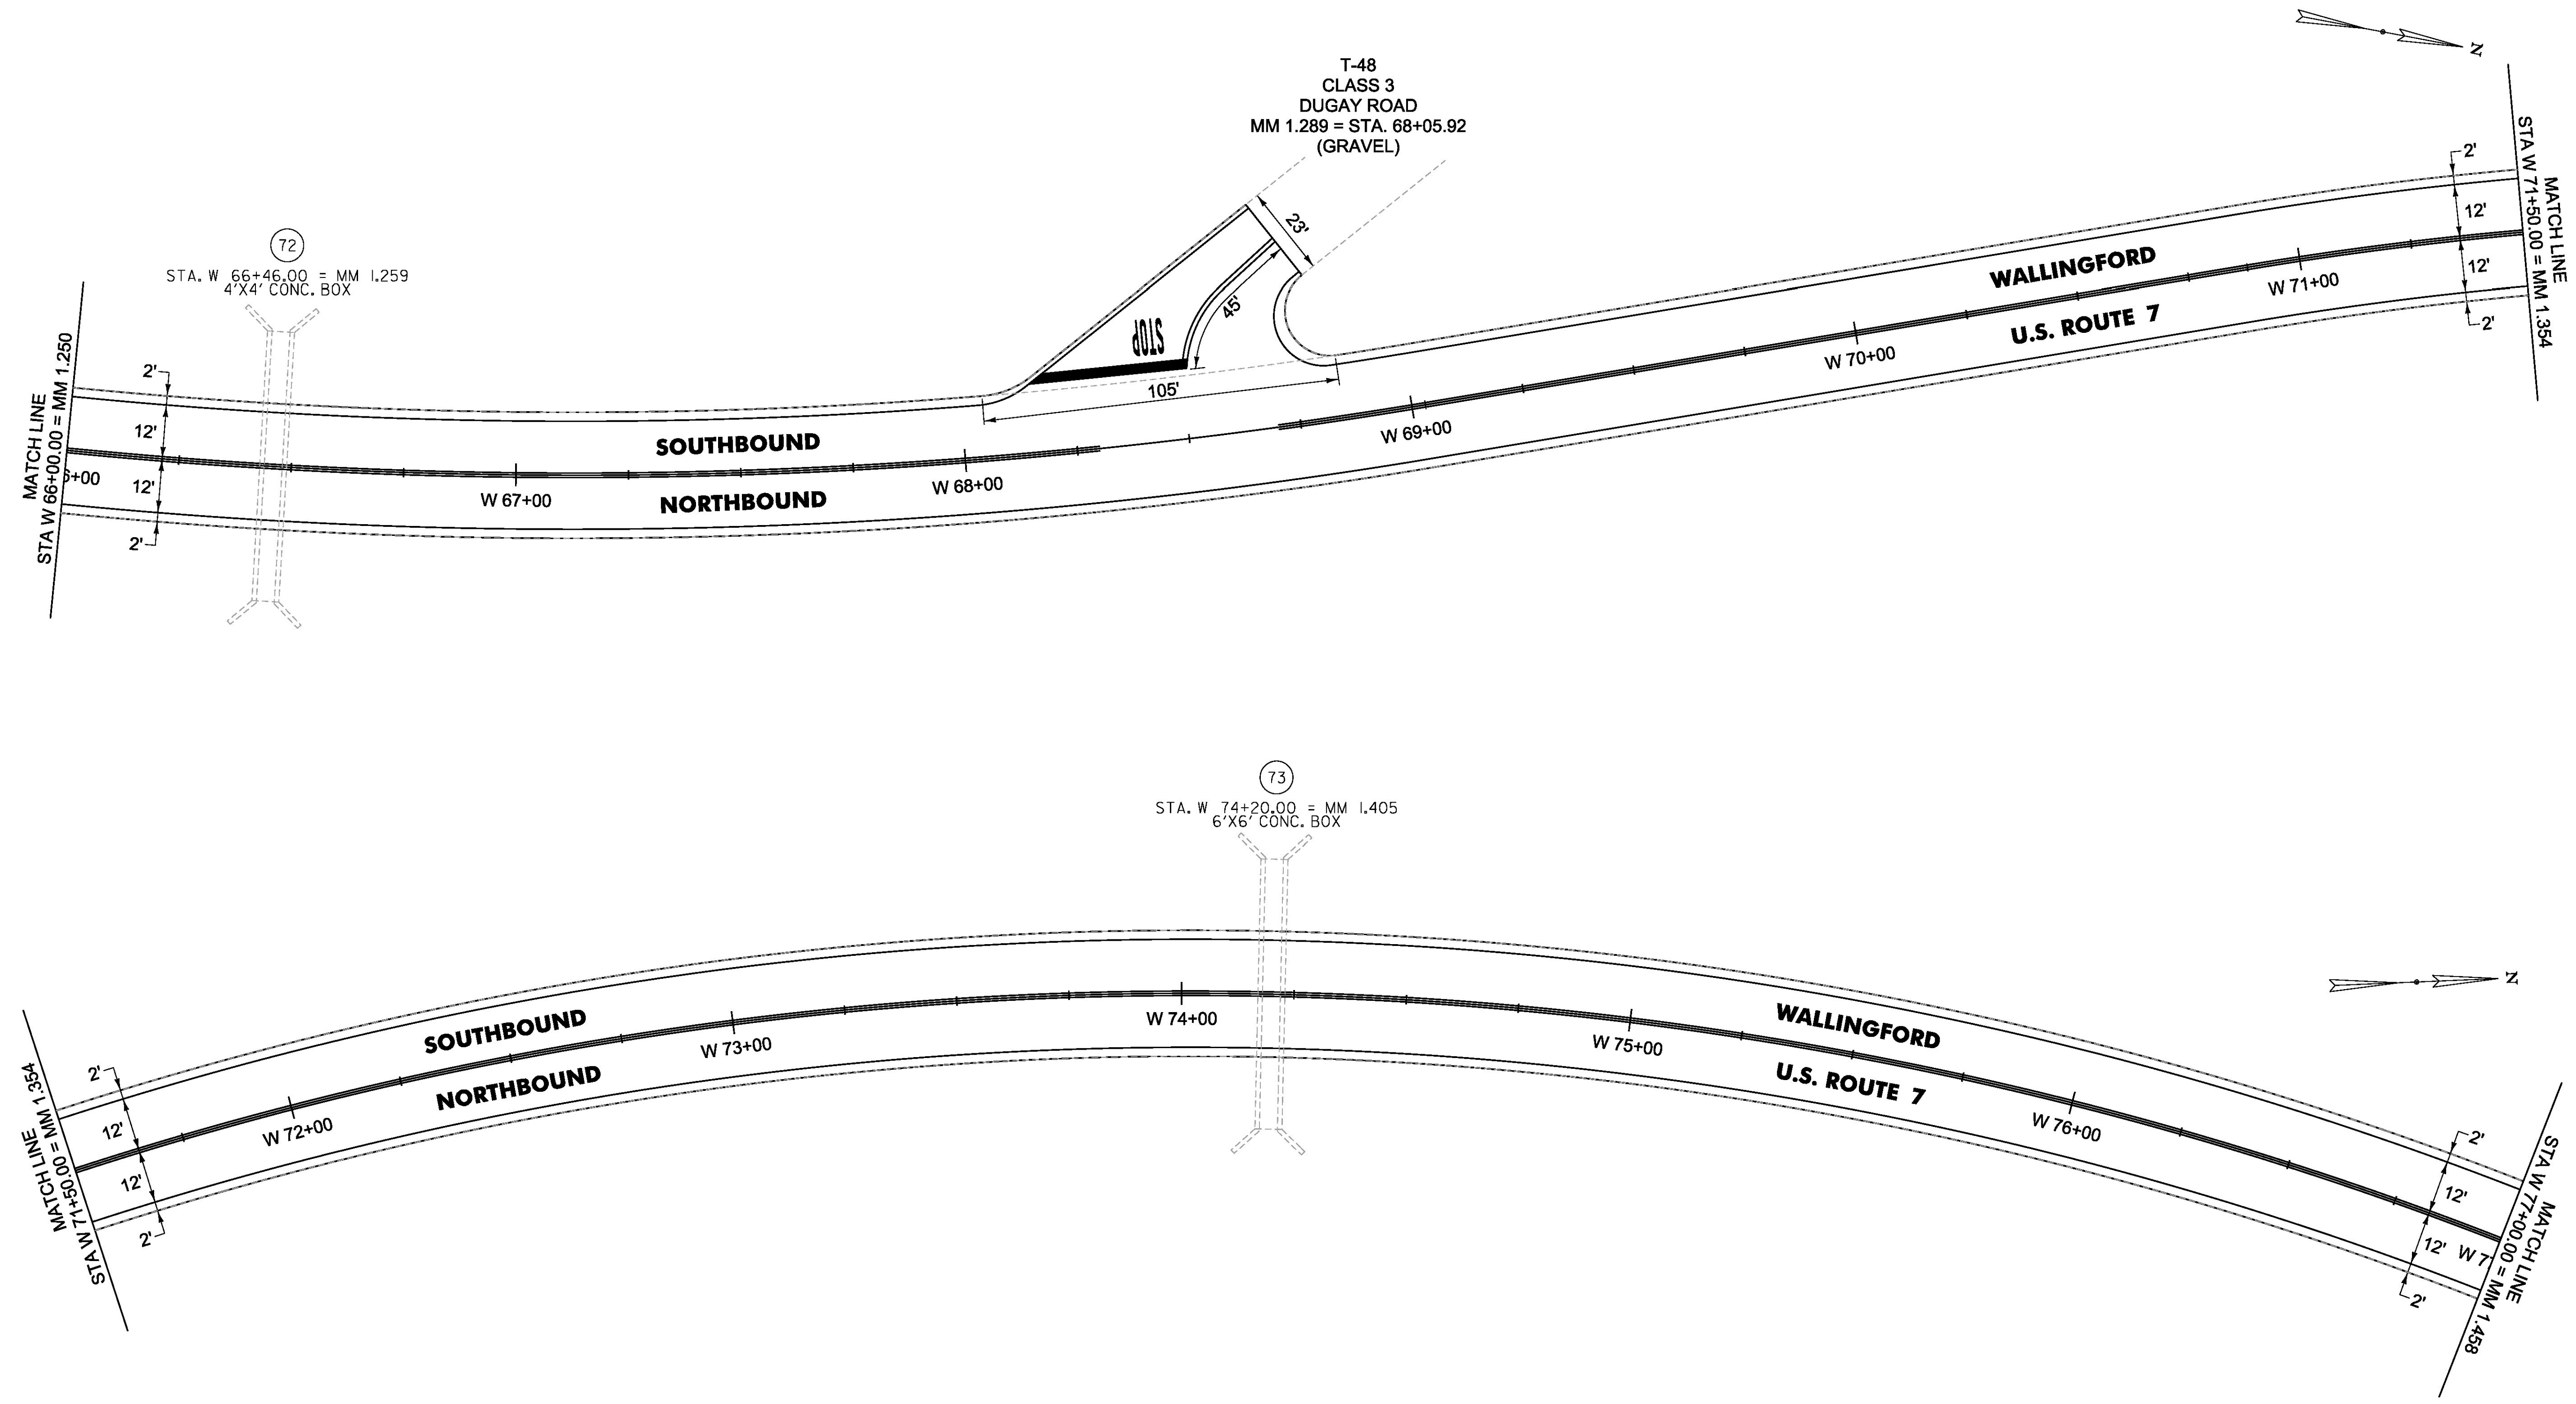

NOT TO SCALE

PROJECT NAME:	MANCHESTER-RUTLAND TOWN
PROJECT NUMBER:	NH SURF(50)
FILE NAME:	layout20.dgn
PROJECT LEADER:	M. FOWLER
DESIGNED BY:	B. KIPP
PLAN SHEET 20	
PLOT DATE:	1/14/2016
DRAWN BY:	B. KIPP
CHECKED BY:	M. FOWLER
SHEET 34	OF 105