



SPECIAL PROVISION(DURABLE 4 INCH WHITE LINE, POLYUREA)(28 MILS)
 W 77+00 TO W 79+70 SOLID LT
 W 77+00 TO W 83+12 SOLID RT
 W 80+61 TO W 88+00 SOLID LT
 W 83+55 TO W 88+00 SOLID RT

TEMPORARY 4 INCH WHITE LINE, PAINT
 W 77+00 TO W 79+70 SOLID LT
 W 77+00 TO W 83+12 SOLID RT
 W 80+61 TO W 88+00 SOLID LT
 W 83+55 TO W 88+00 SOLID RT

SPECIAL PROVISION(DURABLE 4 INCH YELLOW LINE, POLYUREA)(28 MILS)
 W 77+00 TO 80+05 SOLID LT & RT
 W 80+45 TO 83+11 SOLID LT & RT
 W 83+51 TO 88+00 SOLID LT & RT

TEMPORARY 4 INCH YELLOW LINE, PAINT
 W 77+00 TO 80+05 SOLID LT & RT
 W 80+45 TO 83+11 SOLID LT & RT
 W 83+51 TO 88+00 SOLID LT & RT

MILLED RUMBLE STRIPS (CENTERLINE)
 W 84+00 TO W 88+00 CL

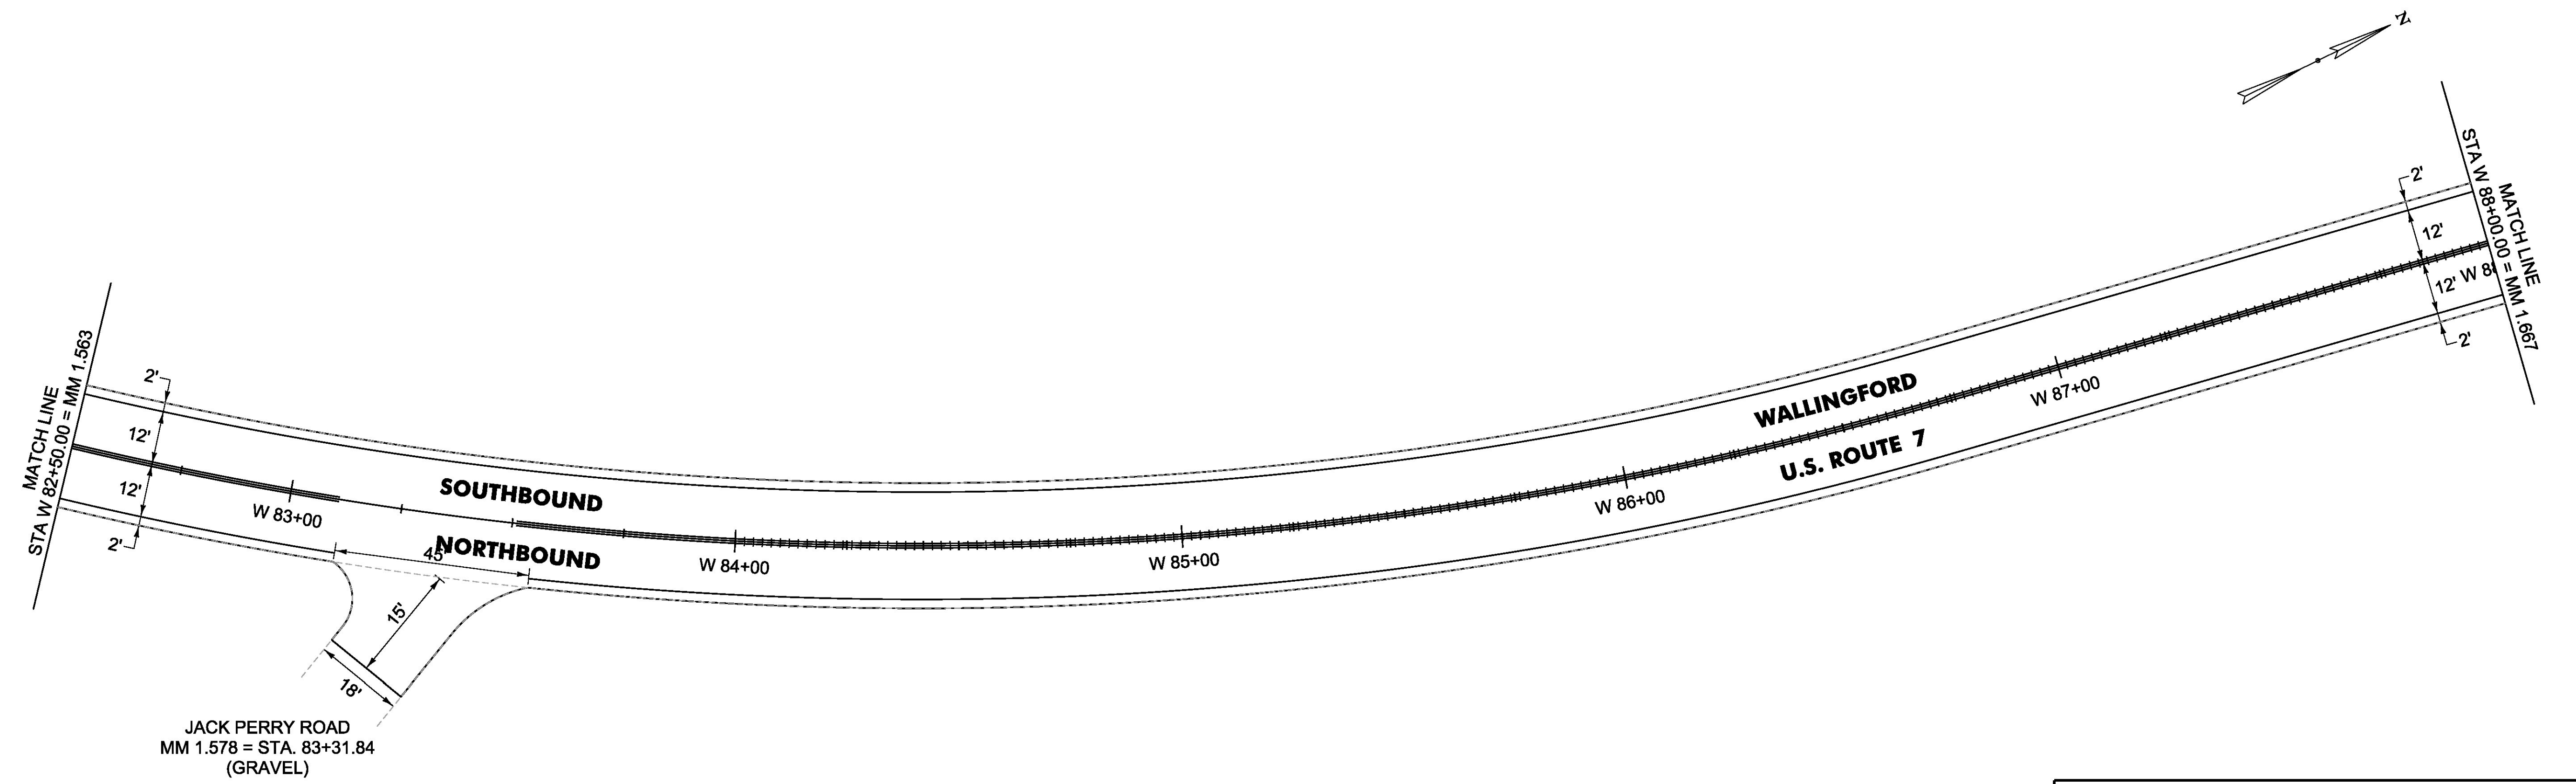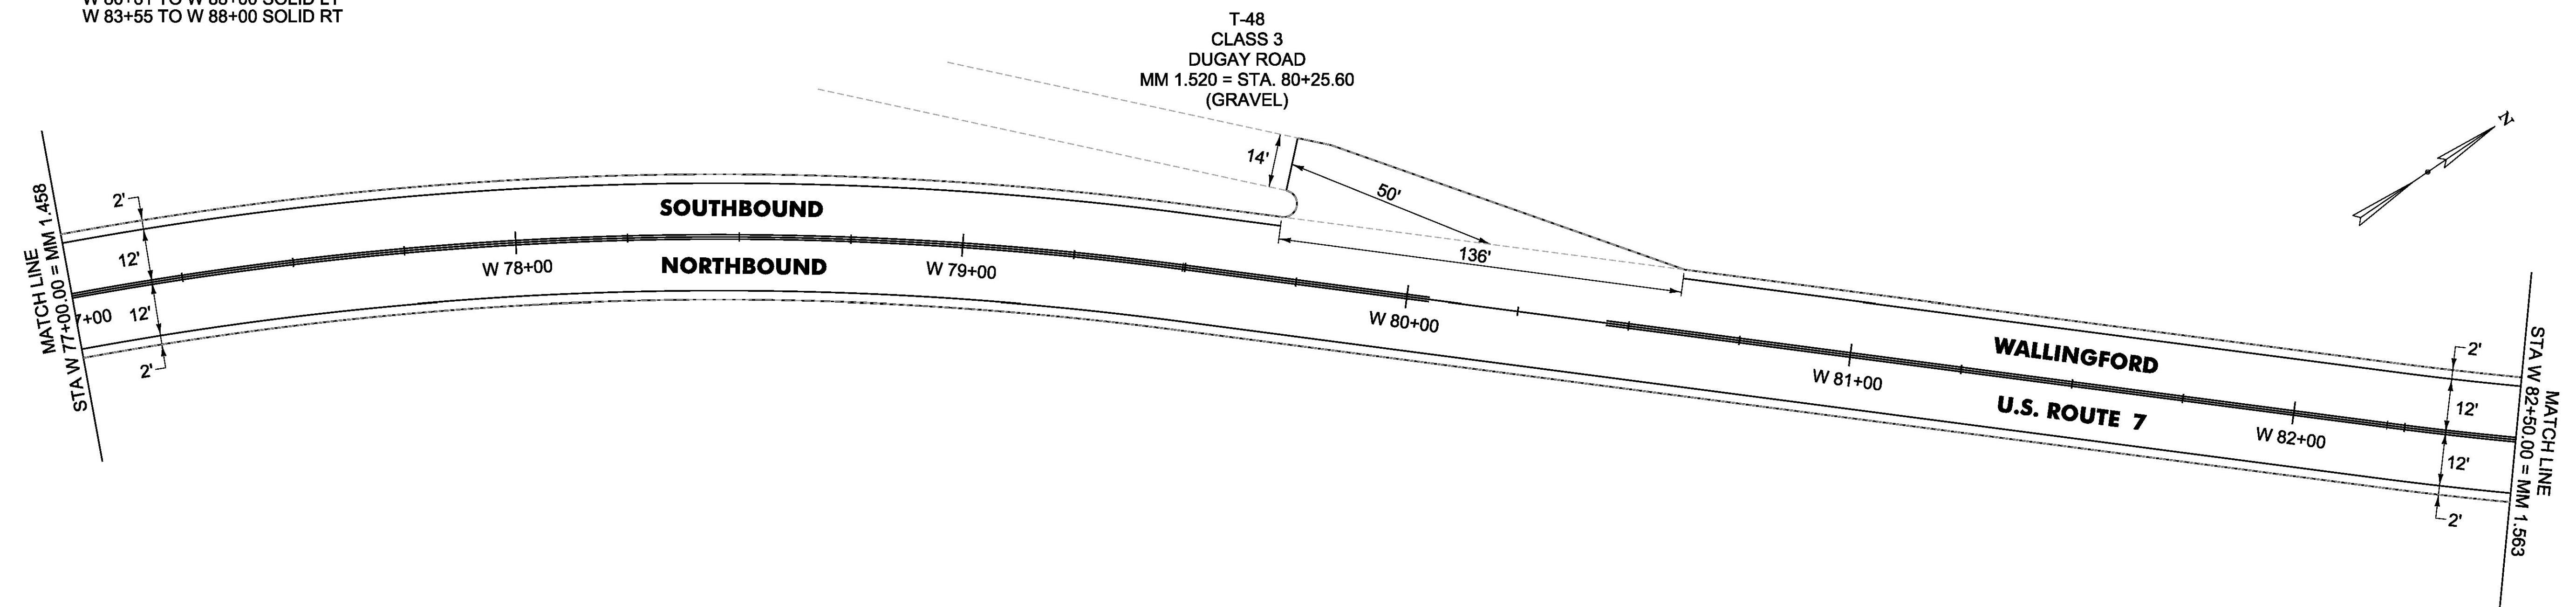

NOT TO SCALE

PROJECT NAME:	MANCHESTER-RUTLAND TOWN
PROJECT NUMBER:	NH SURF(50)
FILE NAME:	layout21.dgn
PROJECT LEADER:	M. FOWLER
DESIGNED BY:	B. KIPP
PLAN SHEET 21	
PLOT DATE:	1/14/2016
DRAWN BY:	B. KIPP
CHECKED BY:	M. FOWLER
SHEET	35 OF 105