



SPECIAL PROVISION(DURABLE 4 INCH WHITE LINE,
POLYUREA)(28 MILS)
W 88+00 TO W 99+00 SOLID LT & RT

SPECIAL PROVISION(DURABLE 4 INCH YELLOW LINE,
POLYUREA)(28 MILS)
W 88+00 TO W 99+00 SOLID LT & RT

MILLED RUMBLE STRIPS (CENTERLINE)
W 88+00 TO W 99+00 CL

TEMPORARY 4 INCH WHITE LINE, PAINT
W 88+00 TO W 99+00 SOLID LT & RT

TEMPORARY 4 INCH YELLOW LINE, PAINT
W 88+00 TO W 99+00 SOLID LT & RT

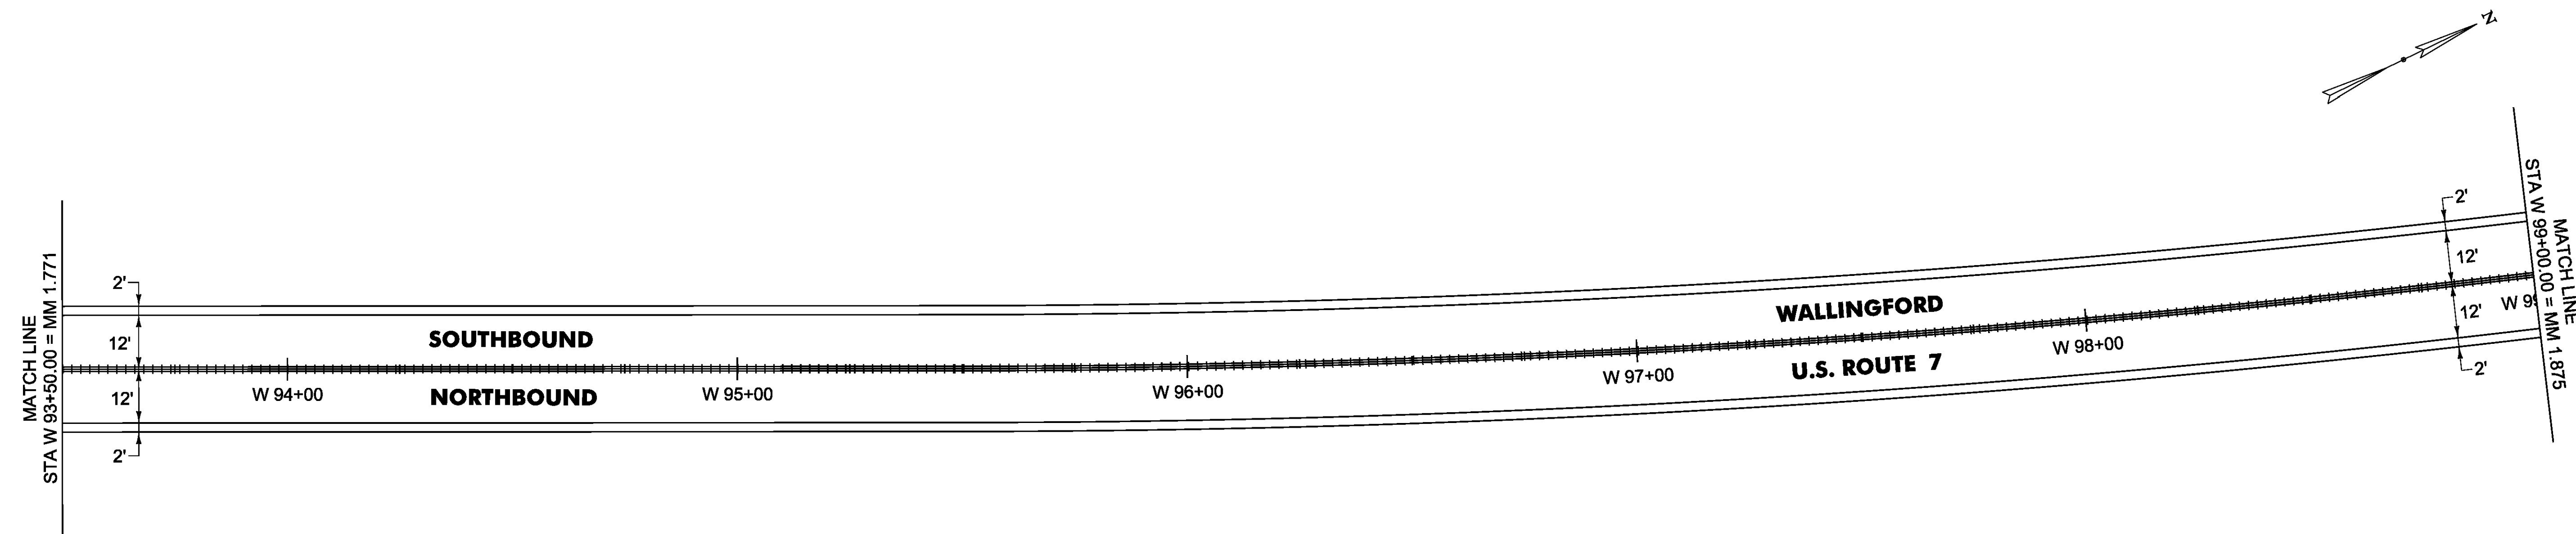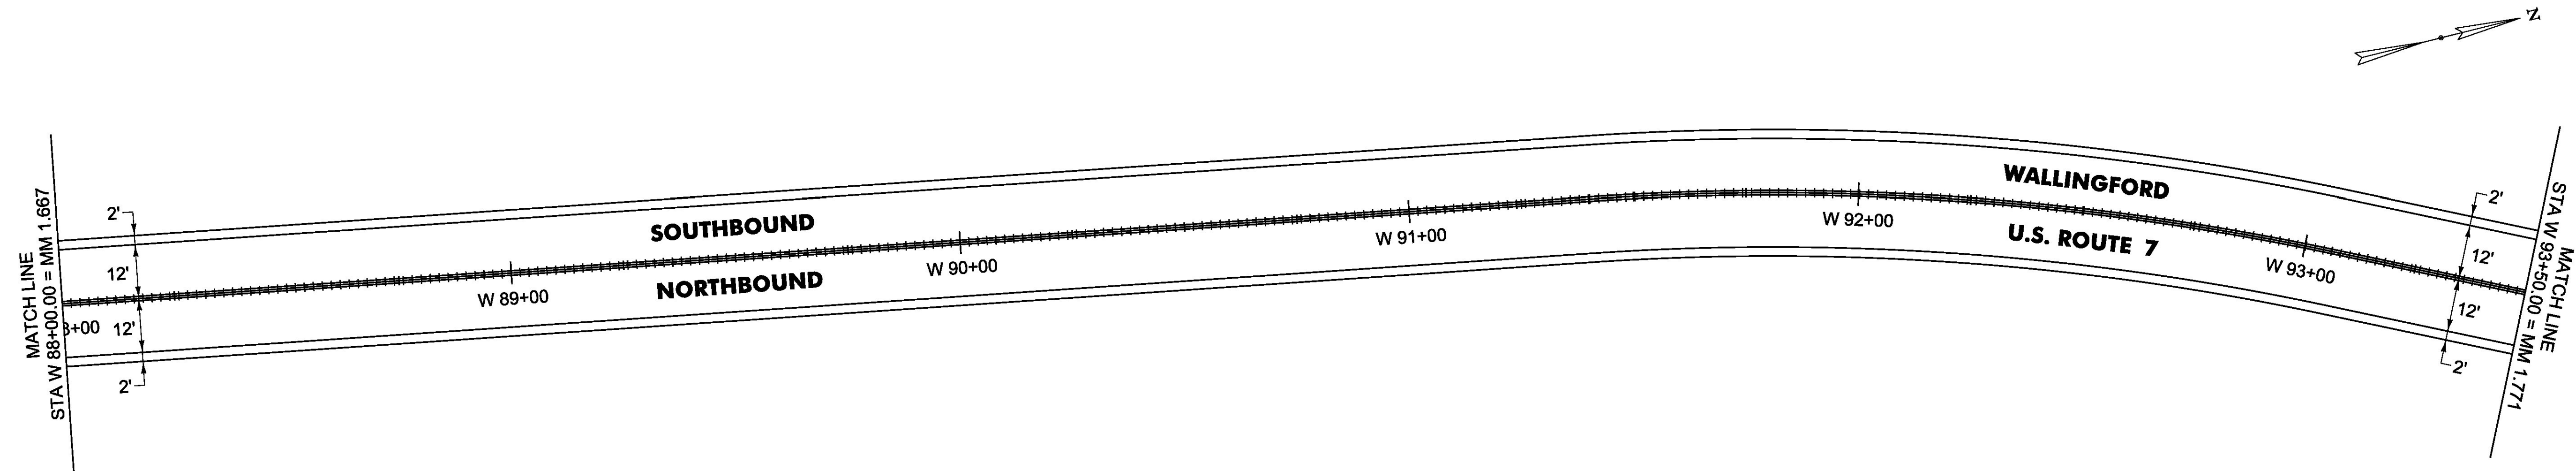

NOT TO SCALE

PROJECT NAME:	MANCHESTER-RUTLAND TOWN
PROJECT NUMBER:	NH SURF(50)
FILE NAME:	layout22.dgn
PROJECT LEADER:	M. FOWLER
DESIGNED BY:	B. KIPP
PLAN SHEET 22	
PLOT DATE:	1/14/2016
DRAWN BY:	B. KIPP
CHECKED BY:	M. FOWLER
SHEET 36	OF 105