



SPECIAL PROVISION(DURABLE 4 INCH WHITE LINE,  
POLYUREA)(28 MILS)  
W 99+00 TO W 110+00 SOLID LT & RT

TEMPORARY 4 INCH WHITE LINE, PAINT  
W 99+00 TO W 110+00 SOLID LT & RT

SPECIAL PROVISION(DURABLE 4 INCH YELLOW LINE,  
POLYUREA)(28 MILS)  
W 99+00 TO W 110+00 SOLID LT & RT

TEMPORARY 4 INCH YELLOW LINE, PAINT  
W 99+00 TO W 110+00 SOLID LT & RT

MILLED RUMBLE STRIPS (CENTERLINE)  
W 99+00 TO W 110+00 CL

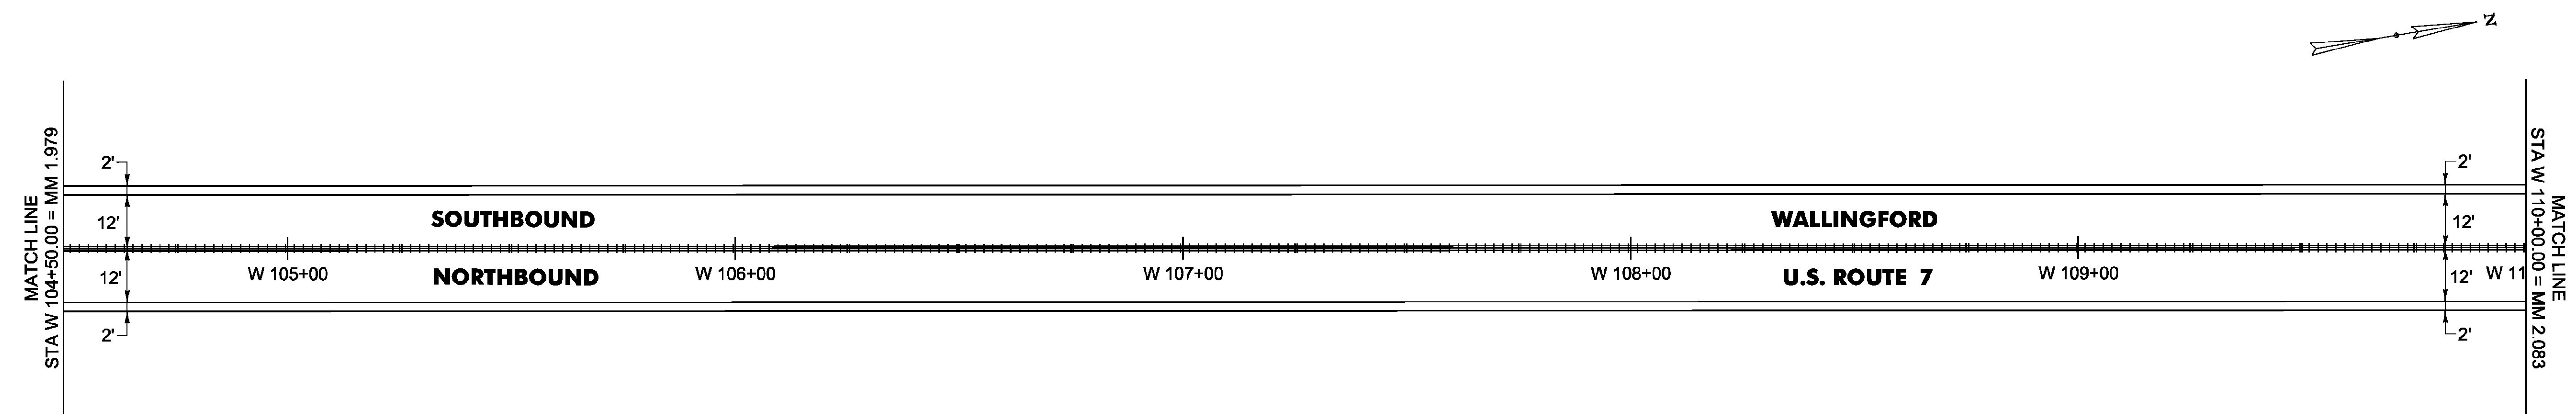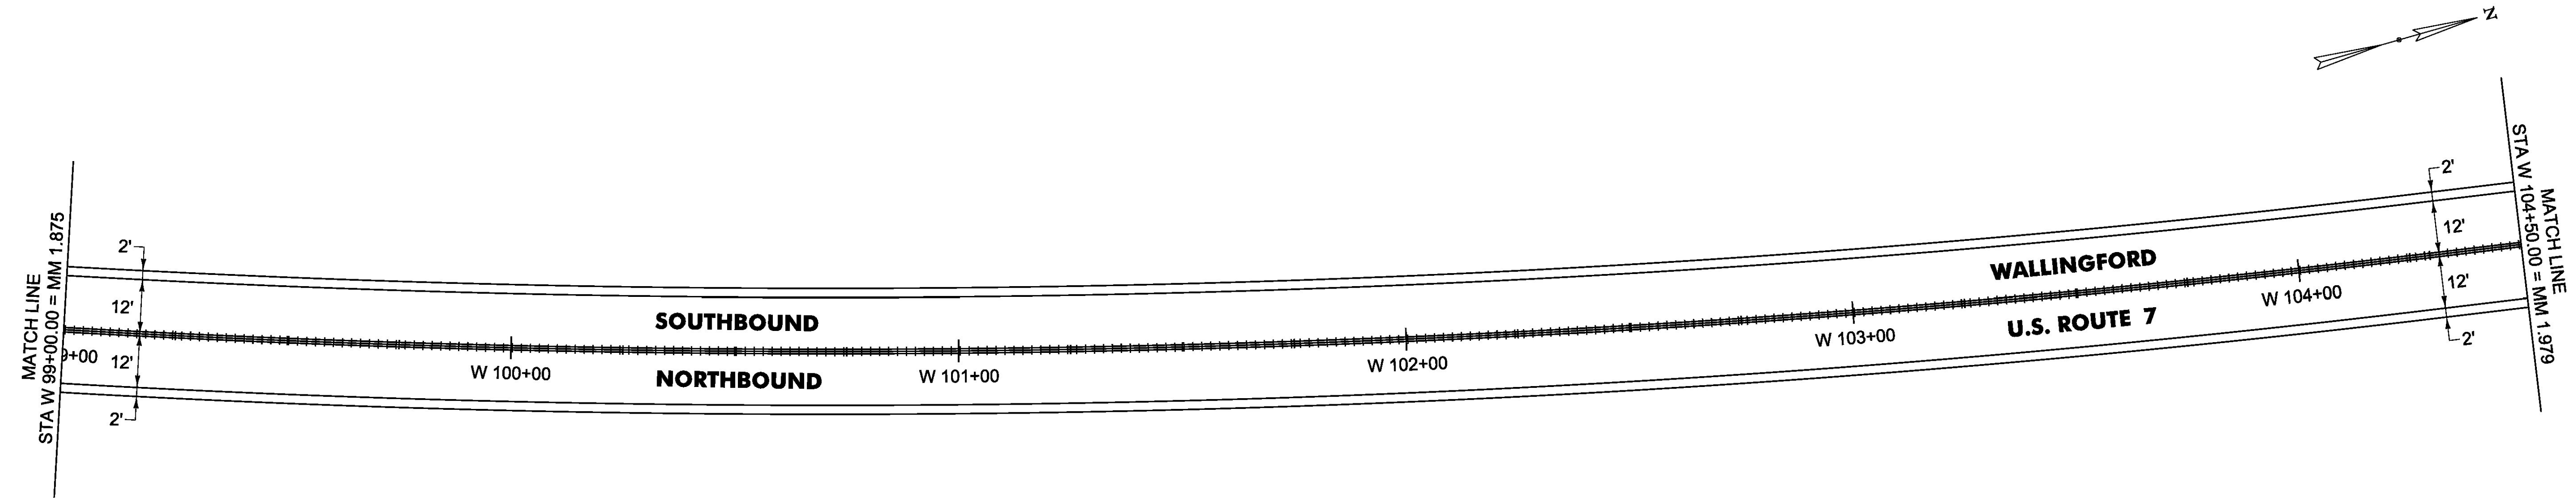

**NOT TO SCALE**

|                 |                         |
|-----------------|-------------------------|
| PROJECT NAME:   | MANCHESTER-RUTLAND TOWN |
| PROJECT NUMBER: | NH SURF(50)             |
| FILE NAME:      | layout23.dgn            |
| PROJECT LEADER: | M. FOWLER               |
| DESIGNED BY:    | B. KIPP                 |
| PLAN SHEET 23   |                         |
| PLOT DATE:      | 1/14/2016               |
| DRAWN BY:       | B. KIPP                 |
| CHECKED BY:     | M. FOWLER               |
| SHEET 37        | OF 105                  |