


SPECIAL PROVISION(DURABLE 4 INCH WHITE LINE,
POLYUREA)(28 MILS)
W 110+00 TO W 121+00 SOLID LT & RT

TEMPORARY 4 INCH WHITE LINE, PAINT
W 110+00 TO W 121+00 SOLID LT & RT


SPECIAL PROVISION(DURABLE 4 INCH YELLOW LINE,
POLYUREA)(28 MILS)
W 110+00 TO W 121+00 SOLID LT & RT

TEMPORARY 4 INCH YELLOW LINE, PAINT
W 110+00 TO W 121+00 SOLID LT & RT

MILLED RUMBLE STRIPS (CENTERLINE)
W 110+00 TO W 120+00 CL
W 120+50 TO W 121+00 CL

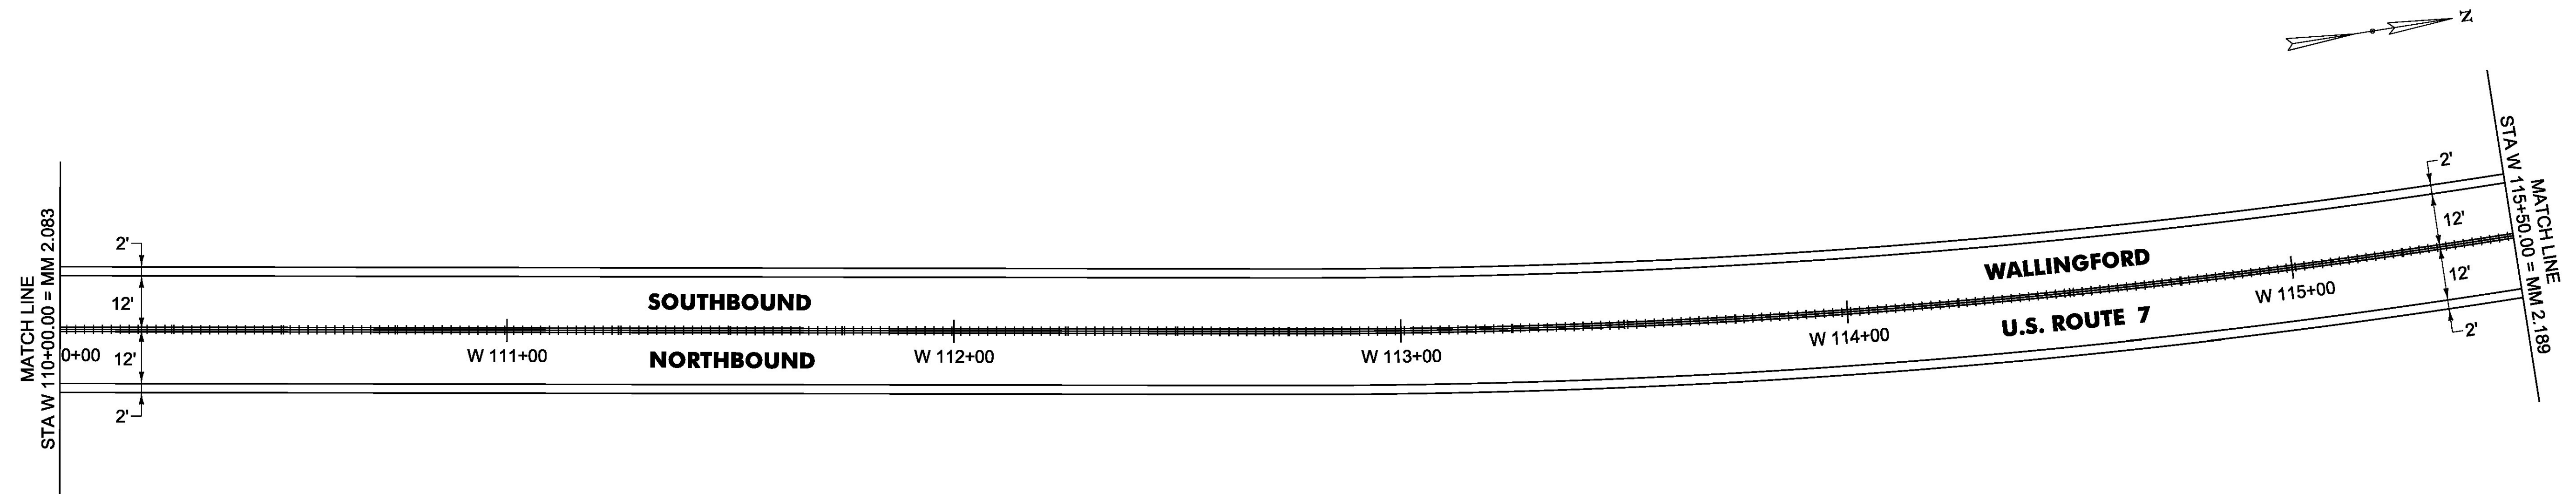

900.540 Supplemental Agreement
(Centerline Rumble Strip Removal)
Station 118+97 - 120+03 and
120+49 - 121+00: Removed due
to change in design criteria

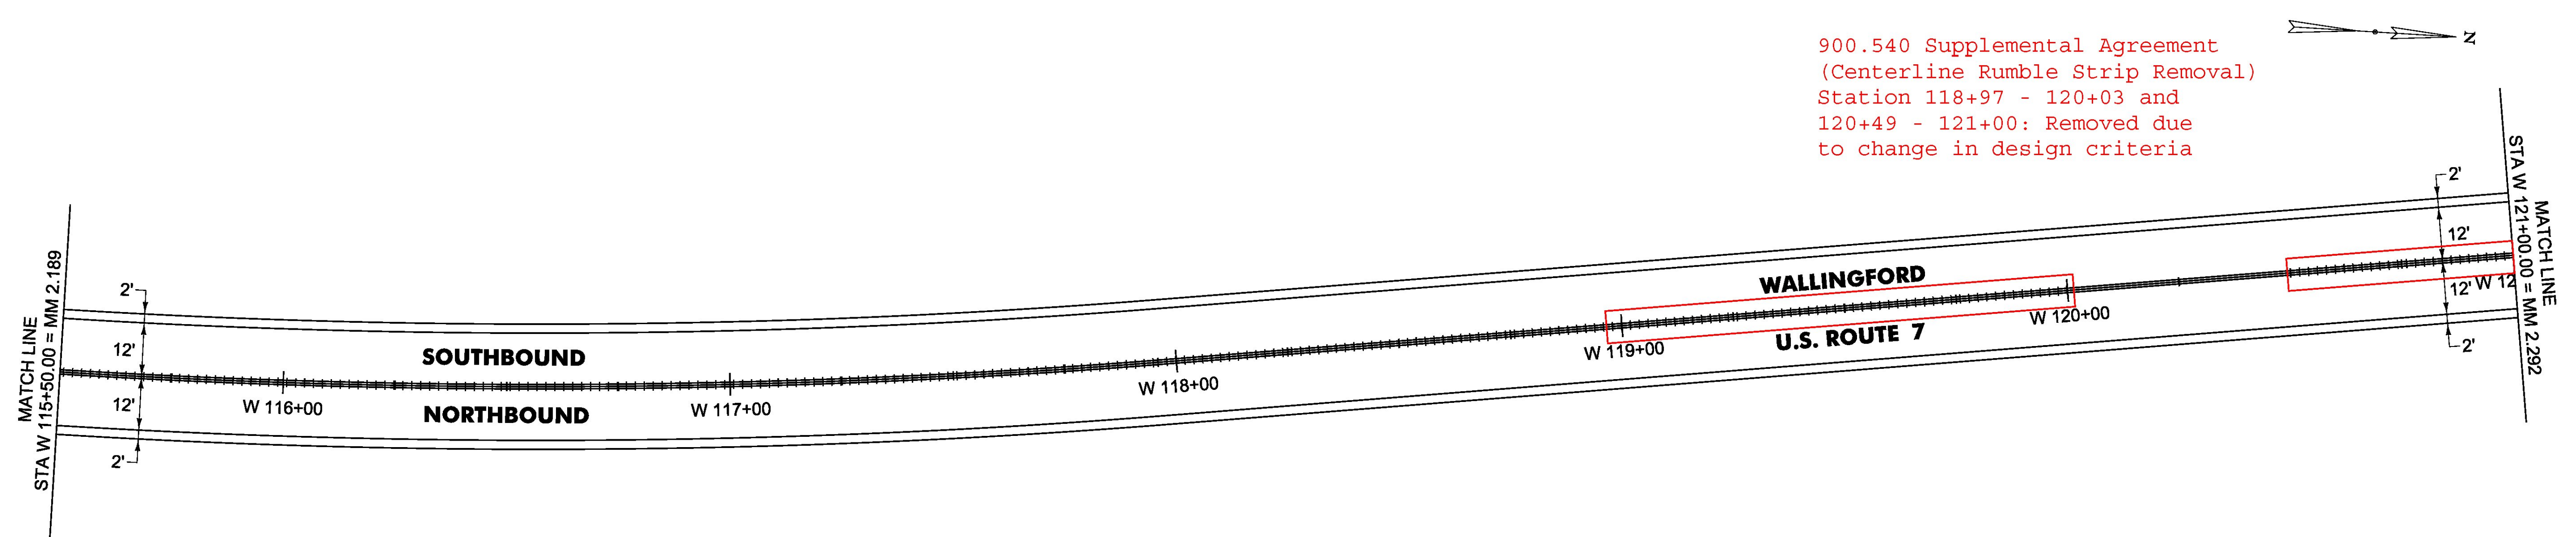

NOT TO SCALE

PROJECT NAME:	MANCHESTER-RUTLAND TOWN
PROJECT NUMBER:	NH SURF(50)
FILE NAME: layout24.dgn	PLOT DATE: 1/14/2016
PROJECT LEADER: M. FOWLER	DRAWN BY: B. KIPP
DESIGNED BY: B. KIPP	CHECKED BY: M. FOWLER
PLAN SHEET 24	SHEET 38 OF 105