


SPECIAL PROVISION(DURABLE 4 INCH WHITE LINE,
POLYUREA)(28 MILS)
W 121+00 TO W 132+00 SOLID LT & RT

TEMPORARY 4 INCH WHITE LINE, PAINT
W 121+00 TO W 132+00 SOLID LT & RT


SPECIAL PROVISION(DURABLE 4 INCH YELLOW LINE,
POLYUREA)(28 MILS)
W 121+00 TO W 132+00 SOLID LT & RT

TEMPORARY 4 INCH YELLOW LINE, PAINT
W 121+00 TO W 132+00 SOLID LT & RT

MILLED RUMBLE STRIPS (CENTERLINE)
W 121+00 TO W 132+00 CL

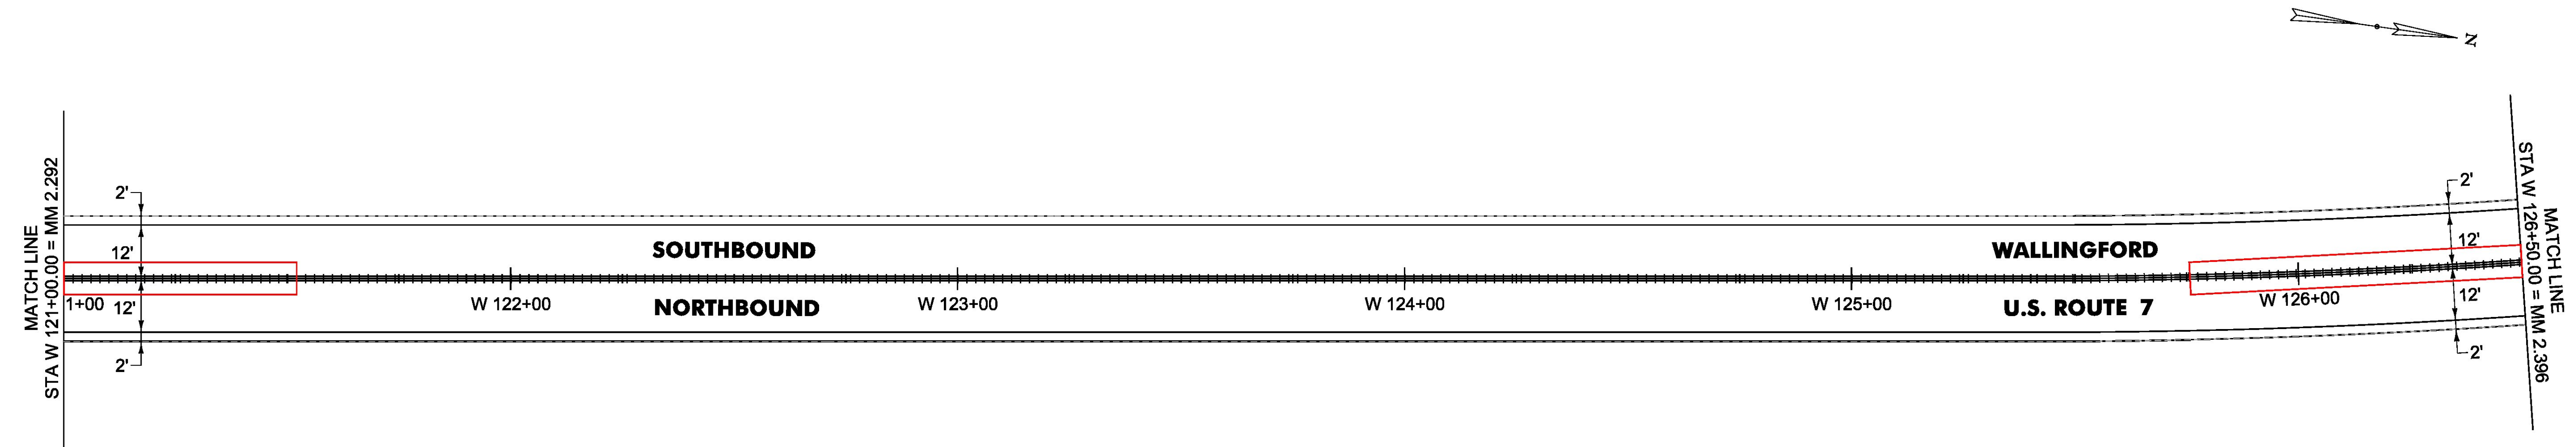

900.540 Supplemental Agreement
(Centerline Rumble Strip Removal)
Station 121+00 - 121+52 and
125+77 - 128+74: Removed due
to change in design criteria

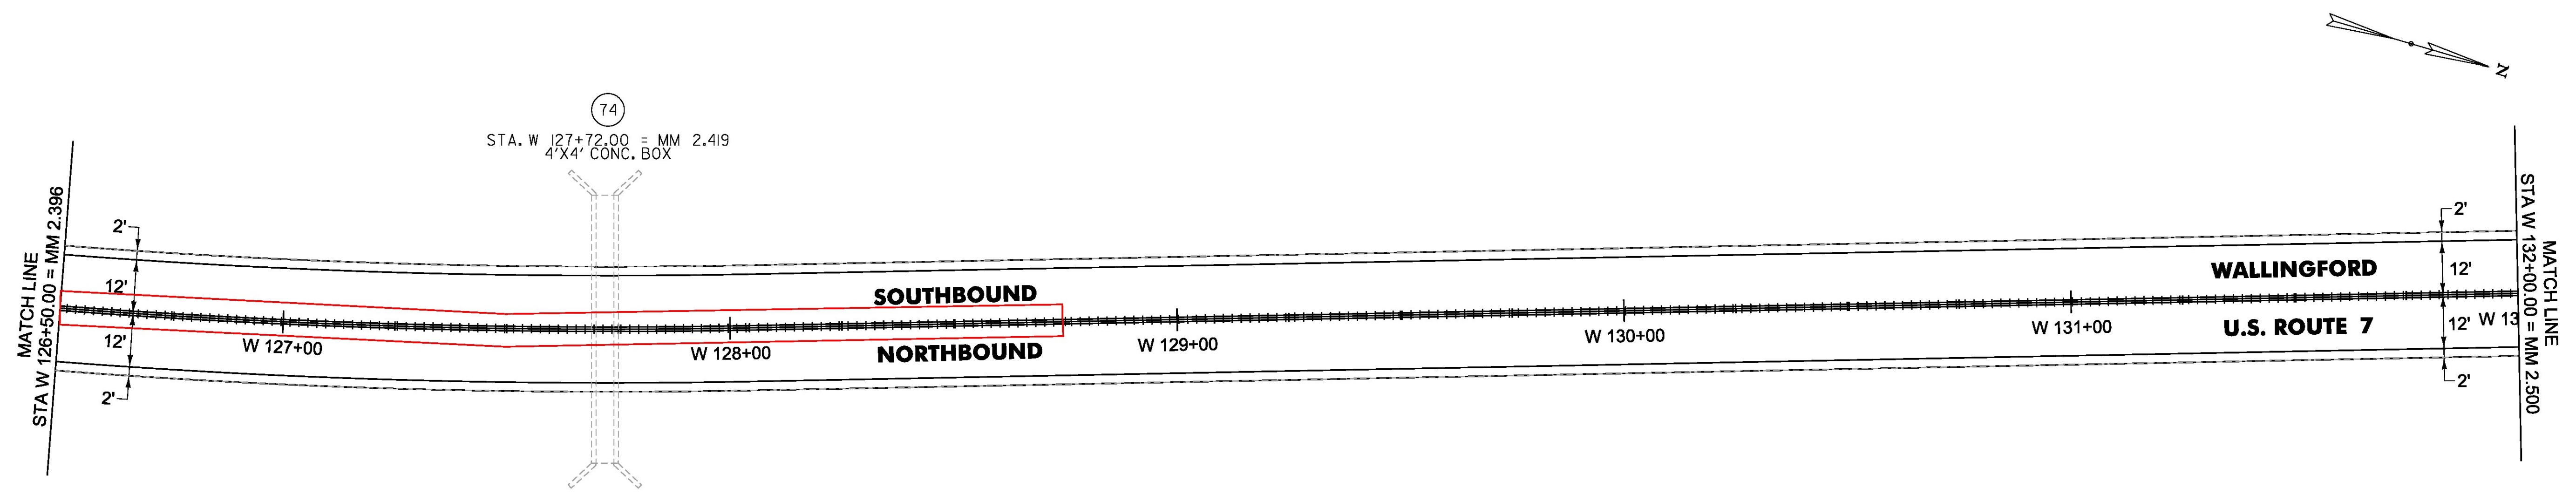

NOT TO SCALE

PROJECT NAME:	MANCHESTER-RUTLAND TOWN
PROJECT NUMBER:	NH SURF(50)
FILE NAME:	layout25.dgn
PROJECT LEADER:	M. FOWLER
DESIGNED BY:	B. KIPP
PLAN SHEET 25	
PLOT DATE:	1/14/2016
DRAWN BY:	B. KIPP
CHECKED BY:	M. FOWLER
SHEET 39	OF 105