


SPECIAL PROVISION(DURABLE 4 INCH WHITE LINE,
POLYUREA)(28 MILS)
W 132+00 TO W 143+00 SOLID LT & RT

TEMPORARY 4 INCH WHITE LINE, PAINT
W 132+00 TO W 143+00 SOLID LT & RT


SPECIAL PROVISION(DURABLE 4 INCH YELLOW LINE,
POLYUREA)(28 MILS)
W 132+00 TO W 143+00 SOLID LT & RT

TEMPORARY 4 INCH YELLOW LINE, PAINT
W 132+00 TO W 143+00 SOLID LT & RT

MILLED RUMBLE STRIPS (CENTERLINE)
W 132+00 TO W 135+93 CL
W 141+00 TO W 143+00 CL

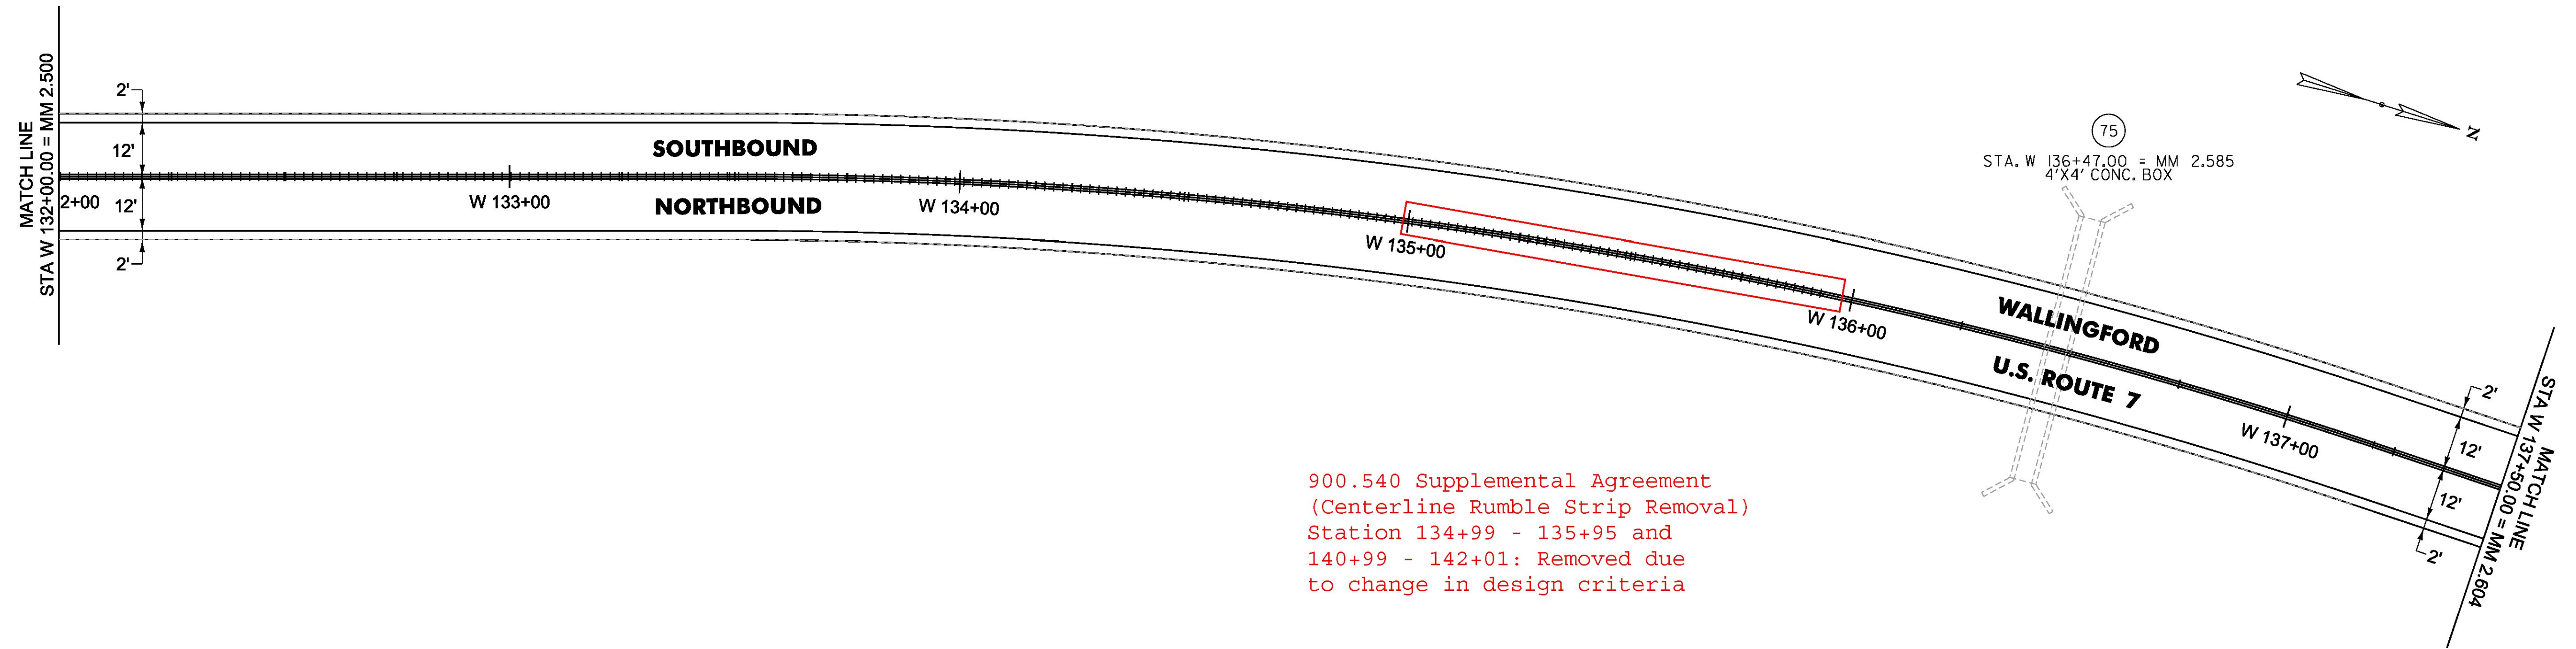

900.540 Supplemental Agreement
(Centerline Rumble Strip Removal)
Station 134+99 - 135+95 and
140+99 - 142+01: Removed due
to change in design criteria

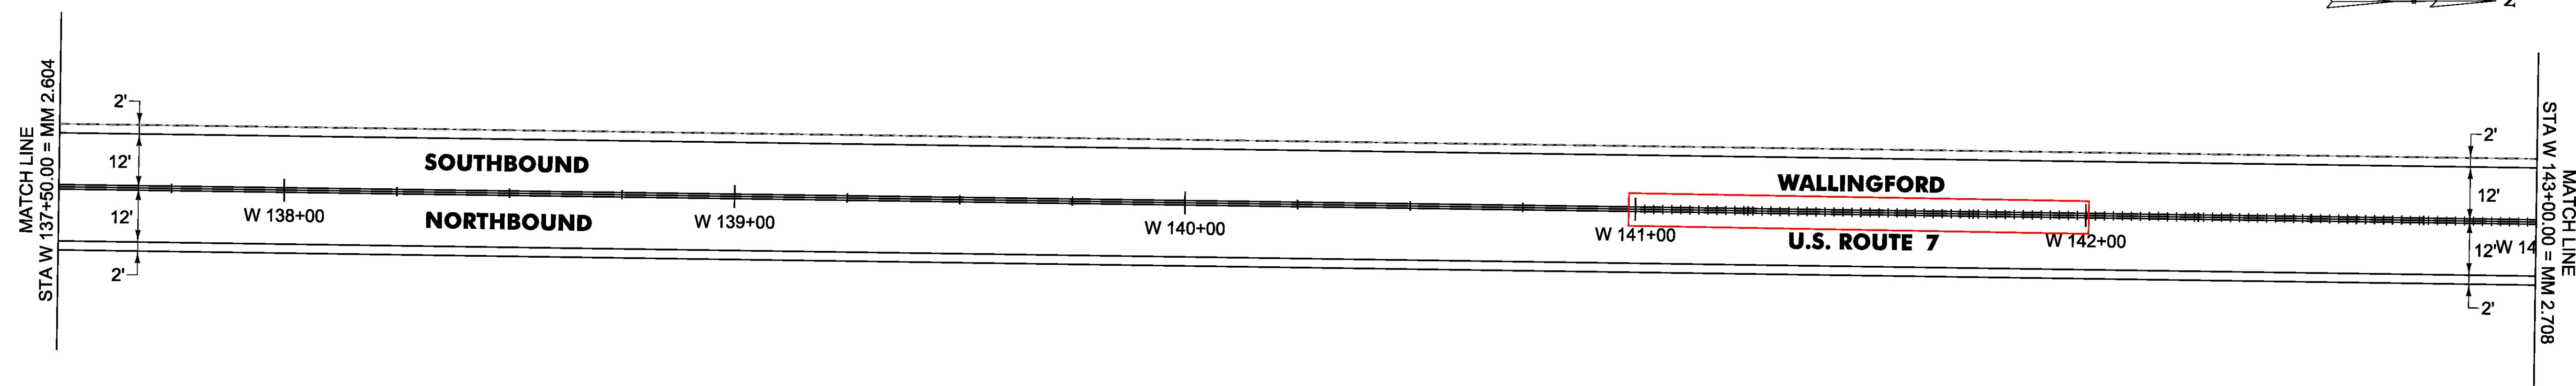

NOT TO SCALE

PROJECT NAME:	MANCHESTER-RUTLAND TOWN
PROJECT NUMBER:	NH SURF(50)
FILE NAME:	layout+26.dgn
PROJECT LEADER:	M. FOWLER
DESIGNED BY:	B. KIPP
PLAN SHEET 26	
PLOT DATE:	1/14/2016
DRAWN BY:	B. KIPP
CHECKED BY:	M. FOWLER
SHEET 40	OF 105