



SPECIAL PROVISION(DURABLE 4 INCH WHITE LINE,
POLYUREA)(28 MILS)
W 198+00 TO W 209+00 SOLID LT & RT

TEMPORARY 4 INCH WHITE LINE, PAINT
W 198+00 TO W 209+00 SOLID LT & RT

SPECIAL PROVISION(DURABLE 4 INCH YELLOW LINE,
POLYUREA)(28 MILS)
W 198+00 TO W 200+00 SOLID LT, DASHED RT
W 200+00 TO W 207+50 DASHED LT, SOLID RT
W 207+50 TO W 209+00 SOLID LT, DASHED RT

TEMPORARY 4 INCH YELLOW LINE, PAINT
W 198+00 TO W 200+00 SOLID LT, DASHED RT
W 200+00 TO W 207+50 DASHED LT, SOLID RT
W 207+50 TO W 209+00 SOLID LT, DASHED RT

MILLED RUMBLE STRIPS (CENTERLINE)
W 198+00 TO W 209+00 CL

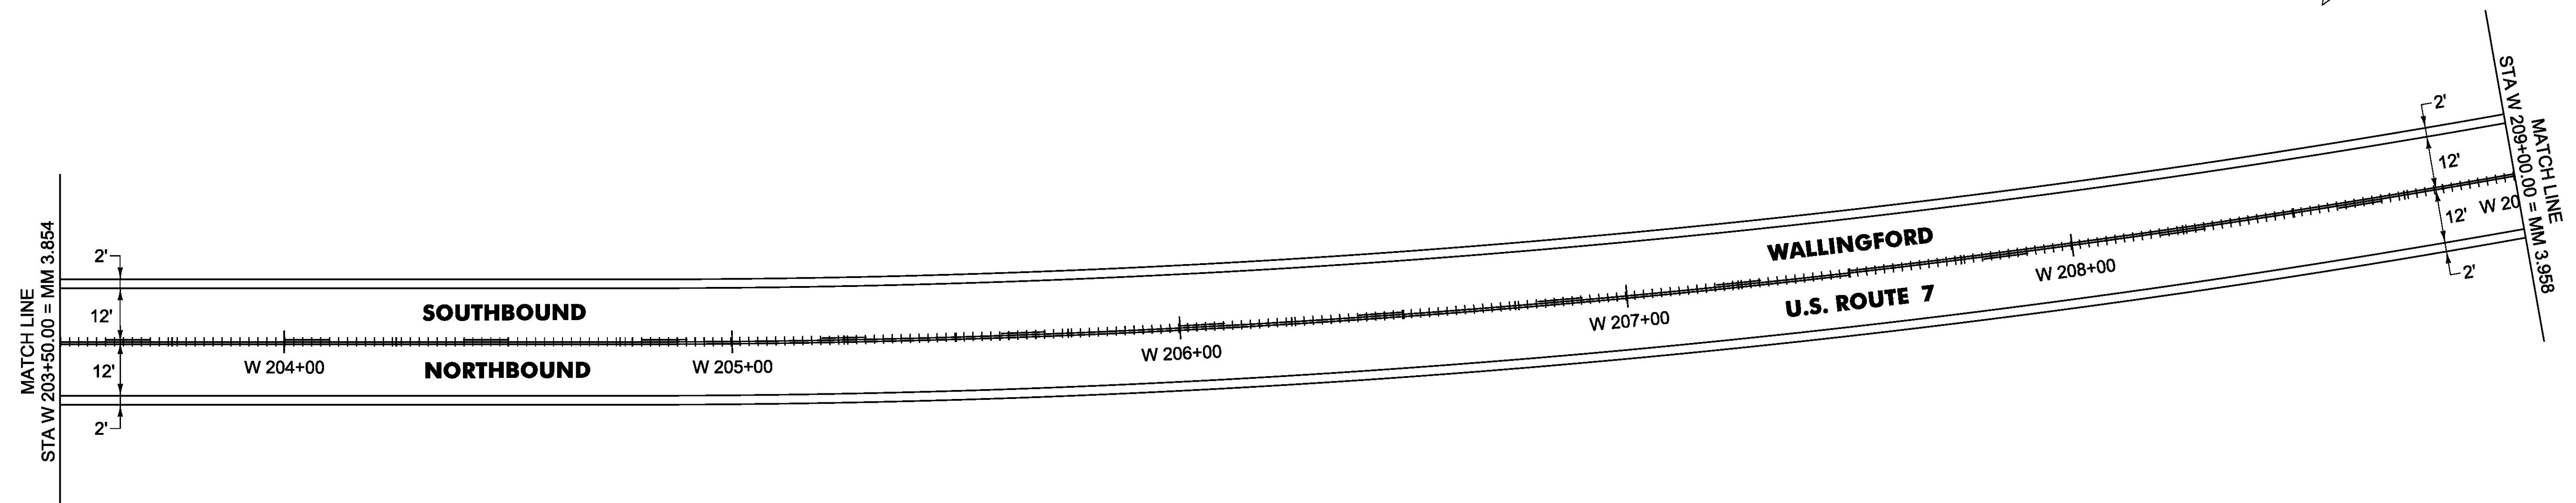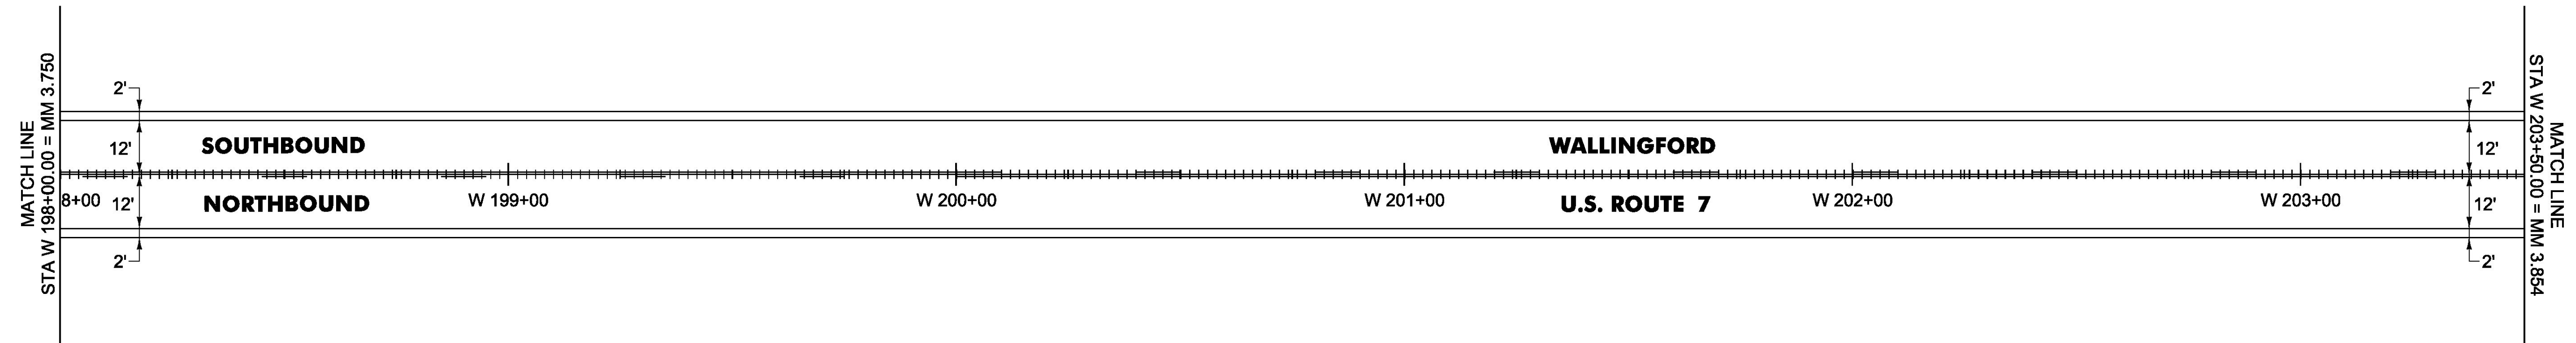

NOT TO SCALE

PROJECT NAME:	MANCHESTER-RUTLAND TOWN
PROJECT NUMBER:	NH SURF(50)
FILE NAME: layout32.dgn	PLOT DATE: 1/14/2016
PROJECT LEADER: M. FOWLER	DRAWN BY: B. KIPP
DESIGNED BY: B. KIPP	CHECKED BY: M. FOWLER
PLAN SHEET 32	SHEET 46 OF 105