


SPECIAL PROVISION(DURABLE 4 INCH WHITE LINE,
POLYUREA)(28 MILS)
W 209+00 TO W 220+00 SOLID LT & RT

SPECIAL PROVISION(DURABLE 4 INCH YELLOW LINE,
POLYUREA)(28 MILS)
W 209+00 TO W 215+15 SOLID LT, DASHED RT
W 215+15 TO W 220+00 DASHED CL


MILLED RUMBLE STRIPS (CENTERLINE)
W 209+00 TO W 212+47 CL
W 213+17 TO W 219+10 CL

TEMPORARY 4 INCH WHITE LINE, PAINT
W 198+00 TO W 209+00 SOLID LT & RT

TEMPORARY 4 INCH YELLOW LINE, PAINT
W 209+00 TO W 215+15 SOLID LT, DASHED RT
W 215+15 TO W 220+00 DASHED CL

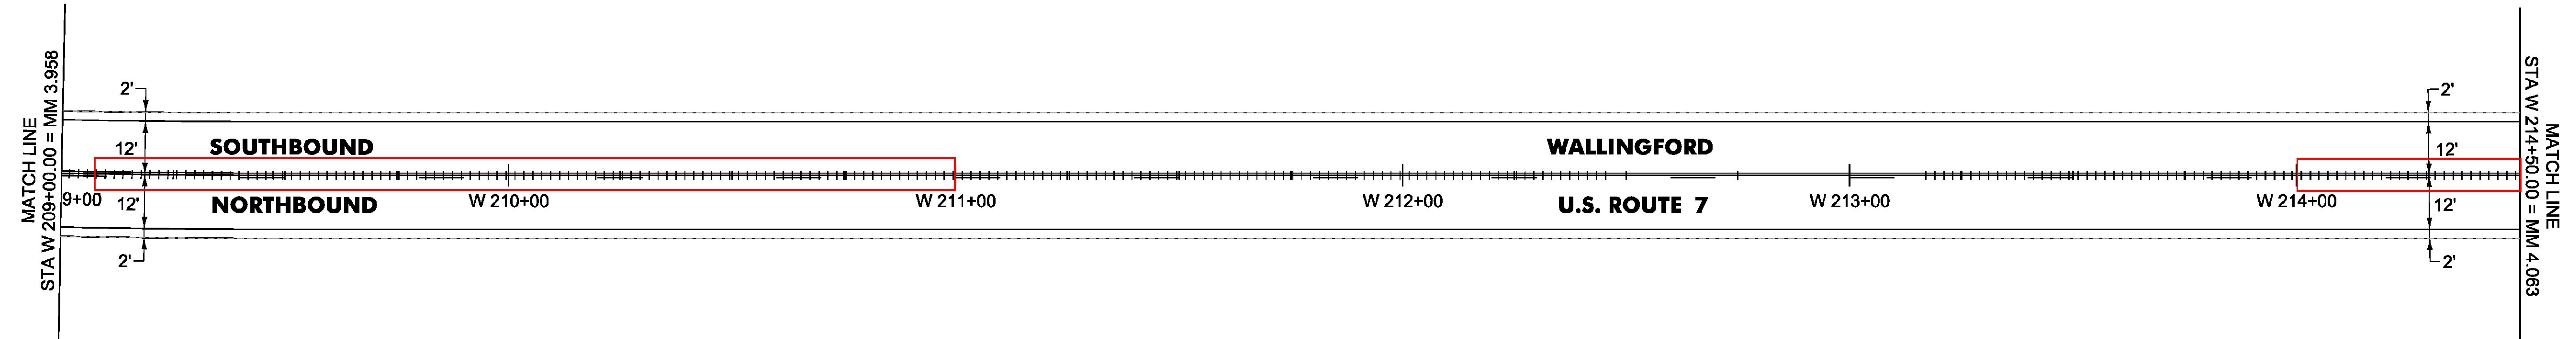

900.540 Supplemental Agreement
(Centerline Rumble Strip Removal)
Station 209+18 - 211+00 and
214+00 - 215+01 and 218+14 - 219+18:
Removed due to change in design criteria

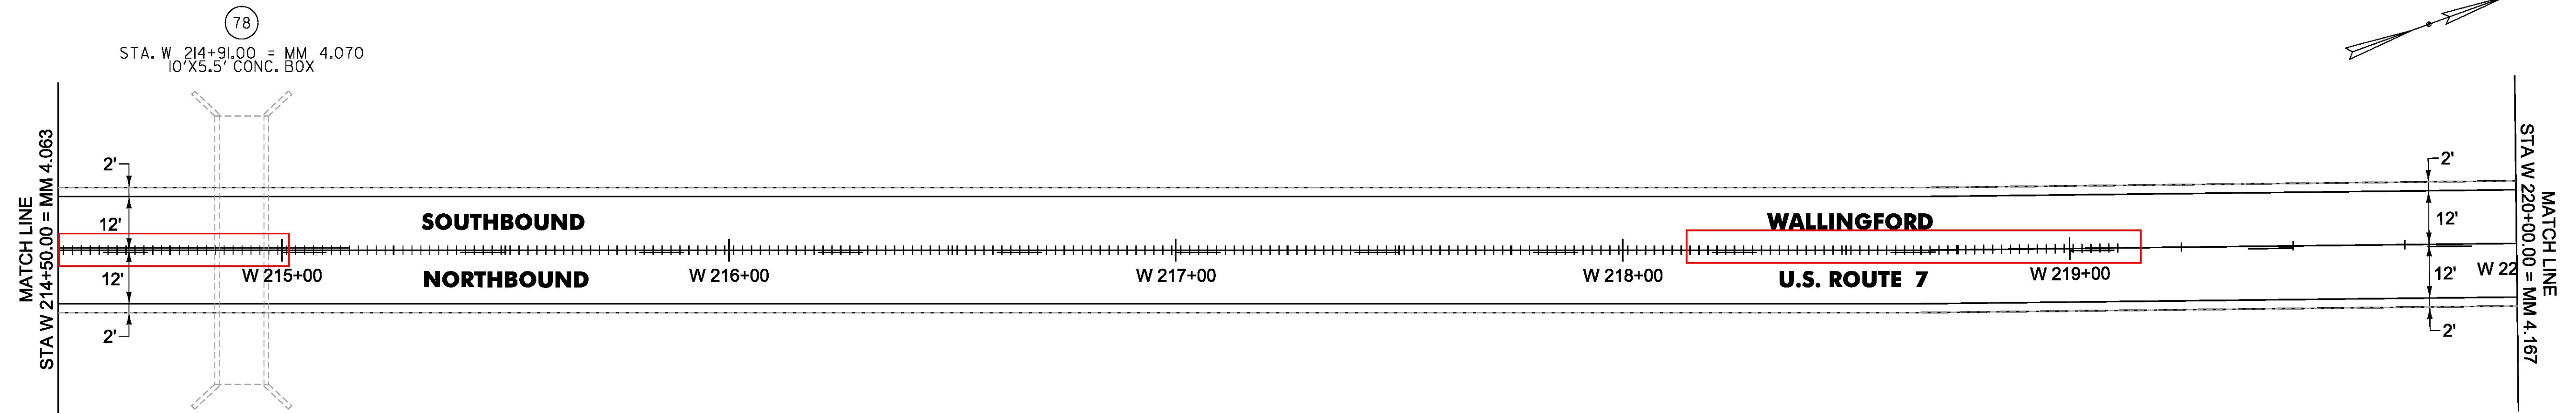

NOT TO SCALE

PROJECT NAME:	MANCHESTER-RUTLAND TOWN
PROJECT NUMBER:	NH SURF(50)
FILE NAME: layout33.dgn	PLOT DATE: 1/14/2016
PROJECT LEADER: M. FOWLER	DRAWN BY: B. KIPP
DESIGNED BY: B. KIPP	CHECKED BY: M. FOWLER
PLAN SHEET 33	SHEET 47 OF 105