
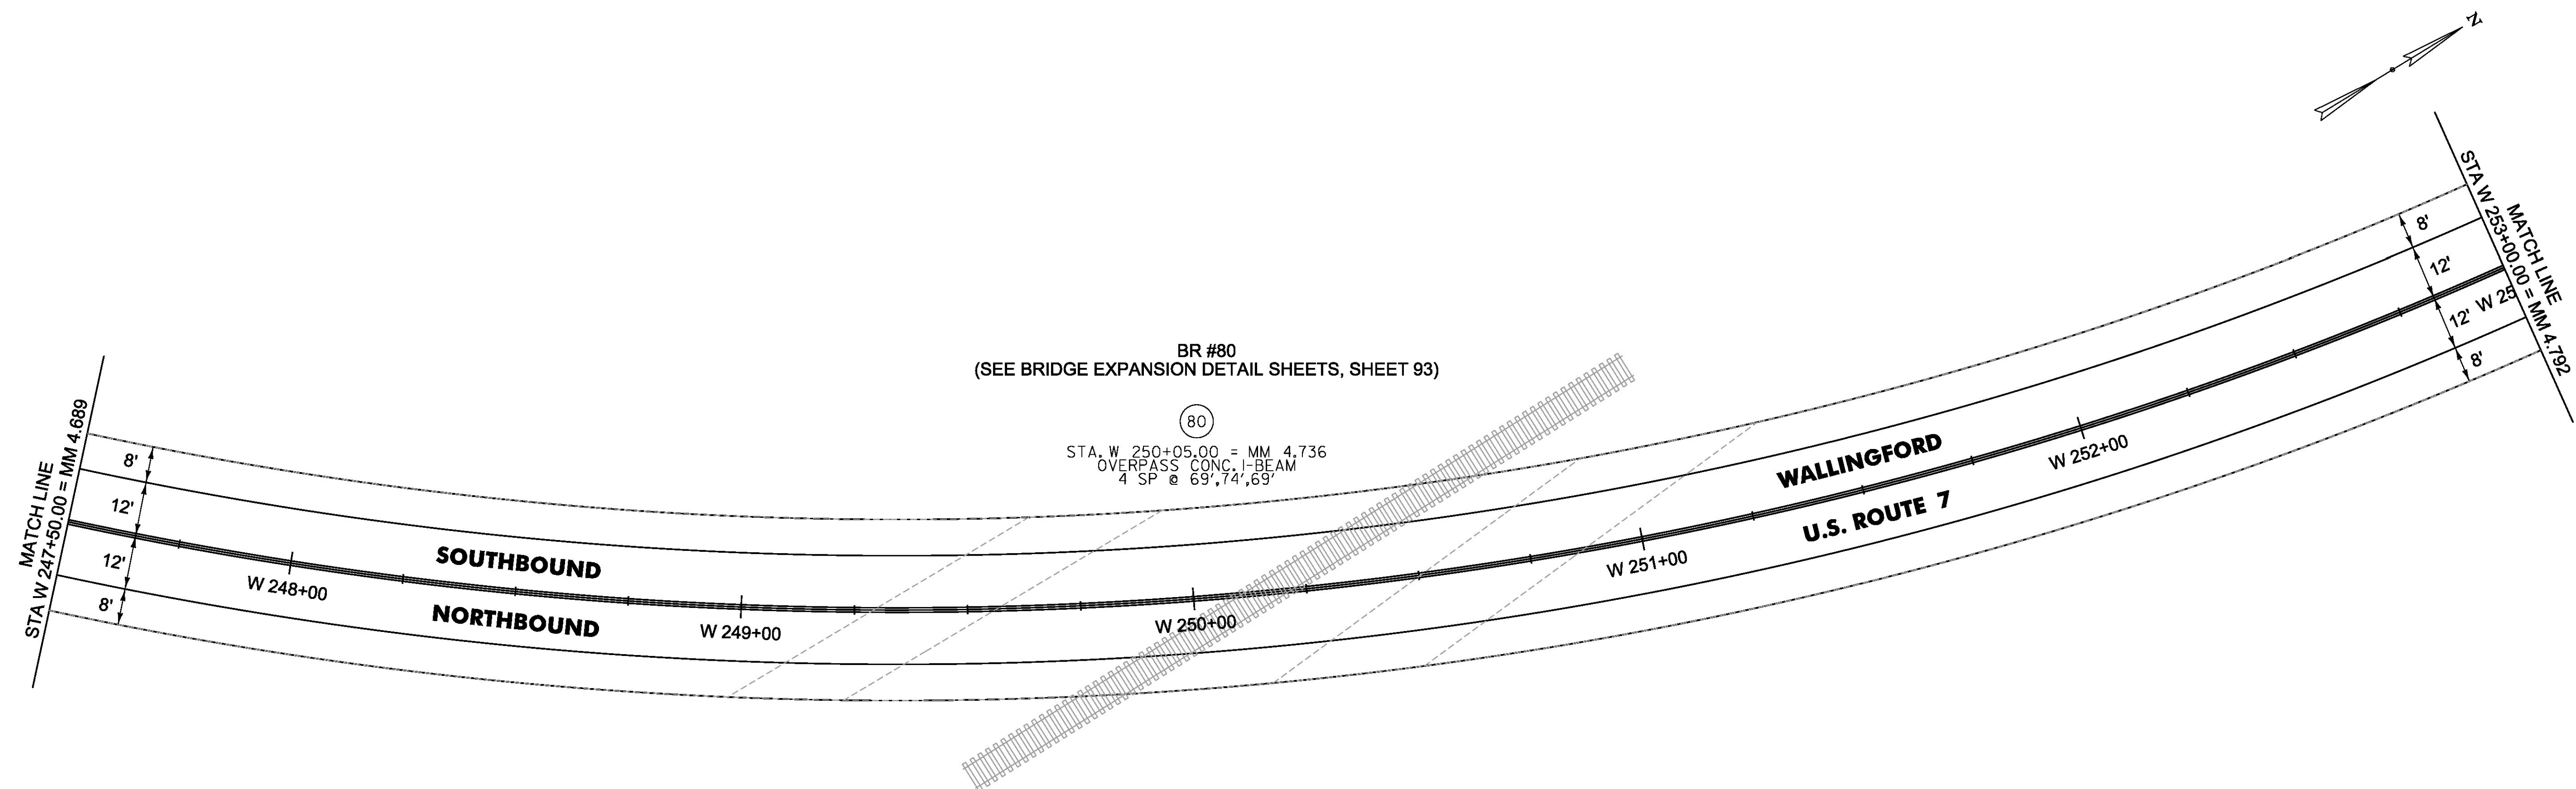


SPECIAL PROVISION(DURABLE 4 INCH WHITE LINE,
POLYUREA)(28 MILS)
W 242+00 TO 253+00 SOLID RT
W 242+09 TO 253+00 SOLID LT

SPECIAL PROVISION(DURABLE 4 INCH YELLOW LINE,
POLYUREA)(28 MILS)
W 242+29 TO W 253+00 SOLID LT & RT

TEMPORARY 4 INCH WHITE LINE, PAINT
W 242+00 TO 253+00 SOLID RT
W 242+09 TO 253+00 SOLID LT

TEMPORARY 4 INCH YELLOW LINE, PAINT
W 242+29 TO W 253+00 SOLID LT & RT

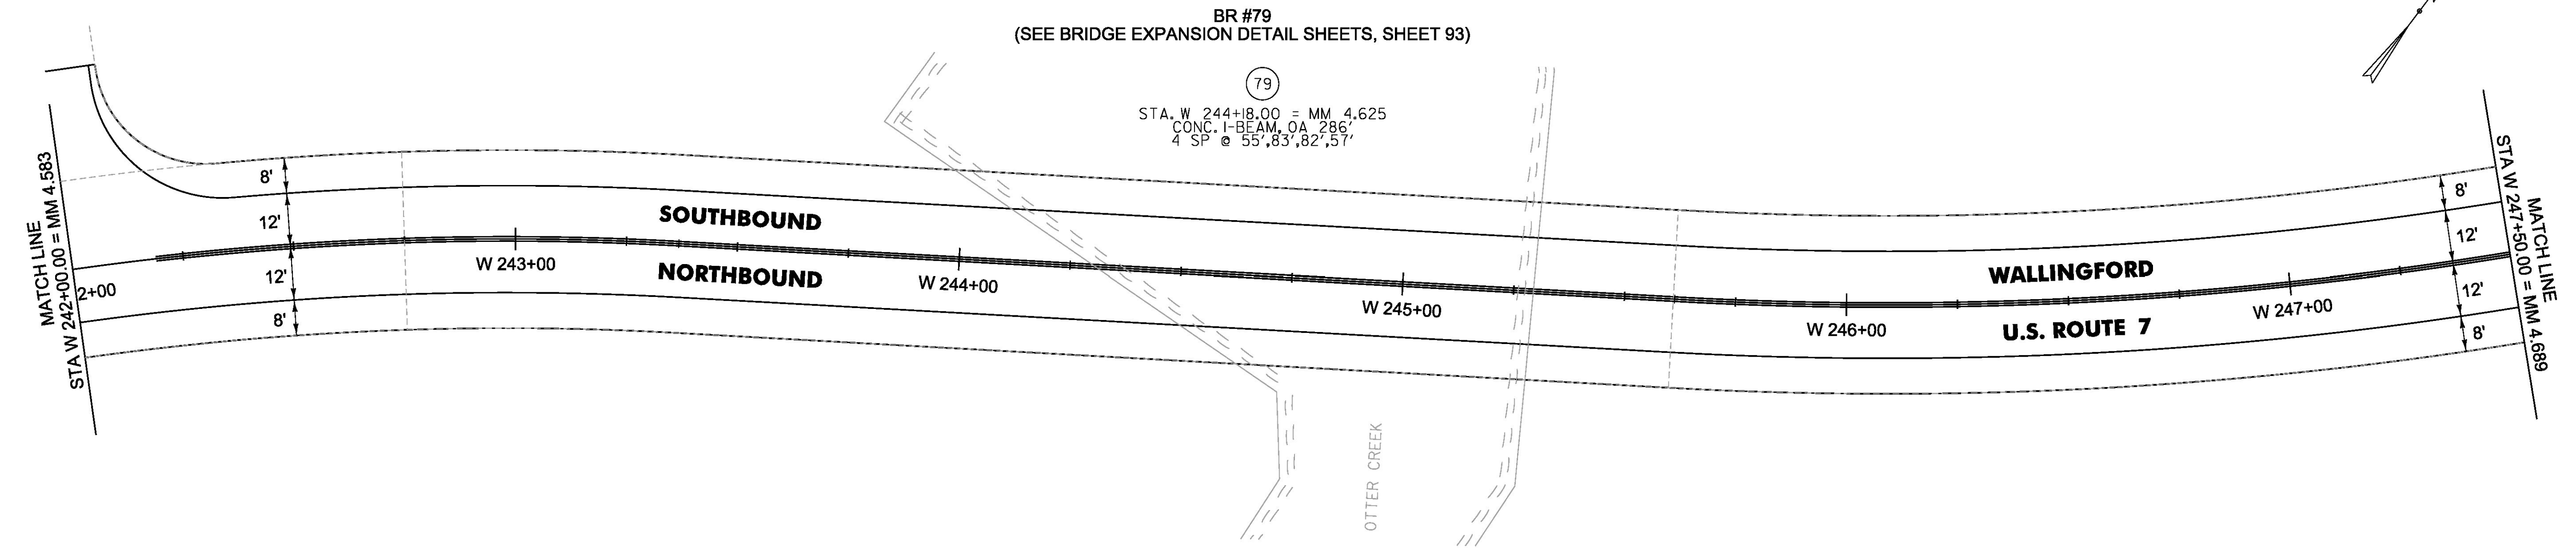

NOT TO SCALE

PROJECT NAME:	MANCHESTER-RUTLAND TOWN
PROJECT NUMBER:	NH SURF(50)
FILE NAME:	layout+36.dgn
PROJECT LEADER:	M. FOWLER
DESIGNED BY:	B. KIPP
PLAN SHEET	36
PLOT DATE:	1/14/2016
DRAWN BY:	B. KIPP
CHECKED BY:	M. FOWLER
SHEET	50 OF 105