

SPECIAL PROVISION(DURABLE 4 INCH WHITE LINE, POLYUREA)(28 MILS)  
W 253+00 TO 264+00 SOLID LT  
W 253+00 TO 257+54 SOLID RT  
W 257+77 TO 264+00 SOLID LT

TEMPORARY 4 INCH WHITE LINE, PAINT  
W 253+00 TO 264+00 SOLID LT  
W 253+00 TO 257+54 SOLID RT  
W 257+77 TO 264+00 SOLID LT

SPECIAL PROVISION(DURABLE 4 INCH YELLOW LINE, POLYUREA)(28 MILS)  
W 253+00 TO W 257+46 SOLID LT & RT  
W 257+66 DOUBLE SOLID RT (TH 68)  
W 257+86 TO W 264+00 SOLID LT & RT



TEMPORARY 4 INCH YELLOW LINE, PAINT  
W 253+00 TO W 257+46 SOLID LT & RT  
W 257+66 DOUBLE SOLID RT (TH 68)  
W 257+86 TO W 264+00 SOLID LT & RT

SPECIAL PROVISION(DURABLE 24 INCH STOP BAR, POLYUREA)(28 MILS)  
W 257+66 TO W 257+84 RT (TH 66)

TEMPORARY 24 INCH STOP BAR, PAINT  
W 257+66 TO W 257+84 RT (TH 66)

SPECIAL PROVISION(DURABLE LETTER OR SYMBOL, POLYUREA)(28 MILS)  
W 257+74 RT "STOP" (TH 68) (4 EA)

TEMPORARY LETTER OR SYMBOL, PAINT  
W 257+74 RT "STOP" (TH 68) (4 EA)

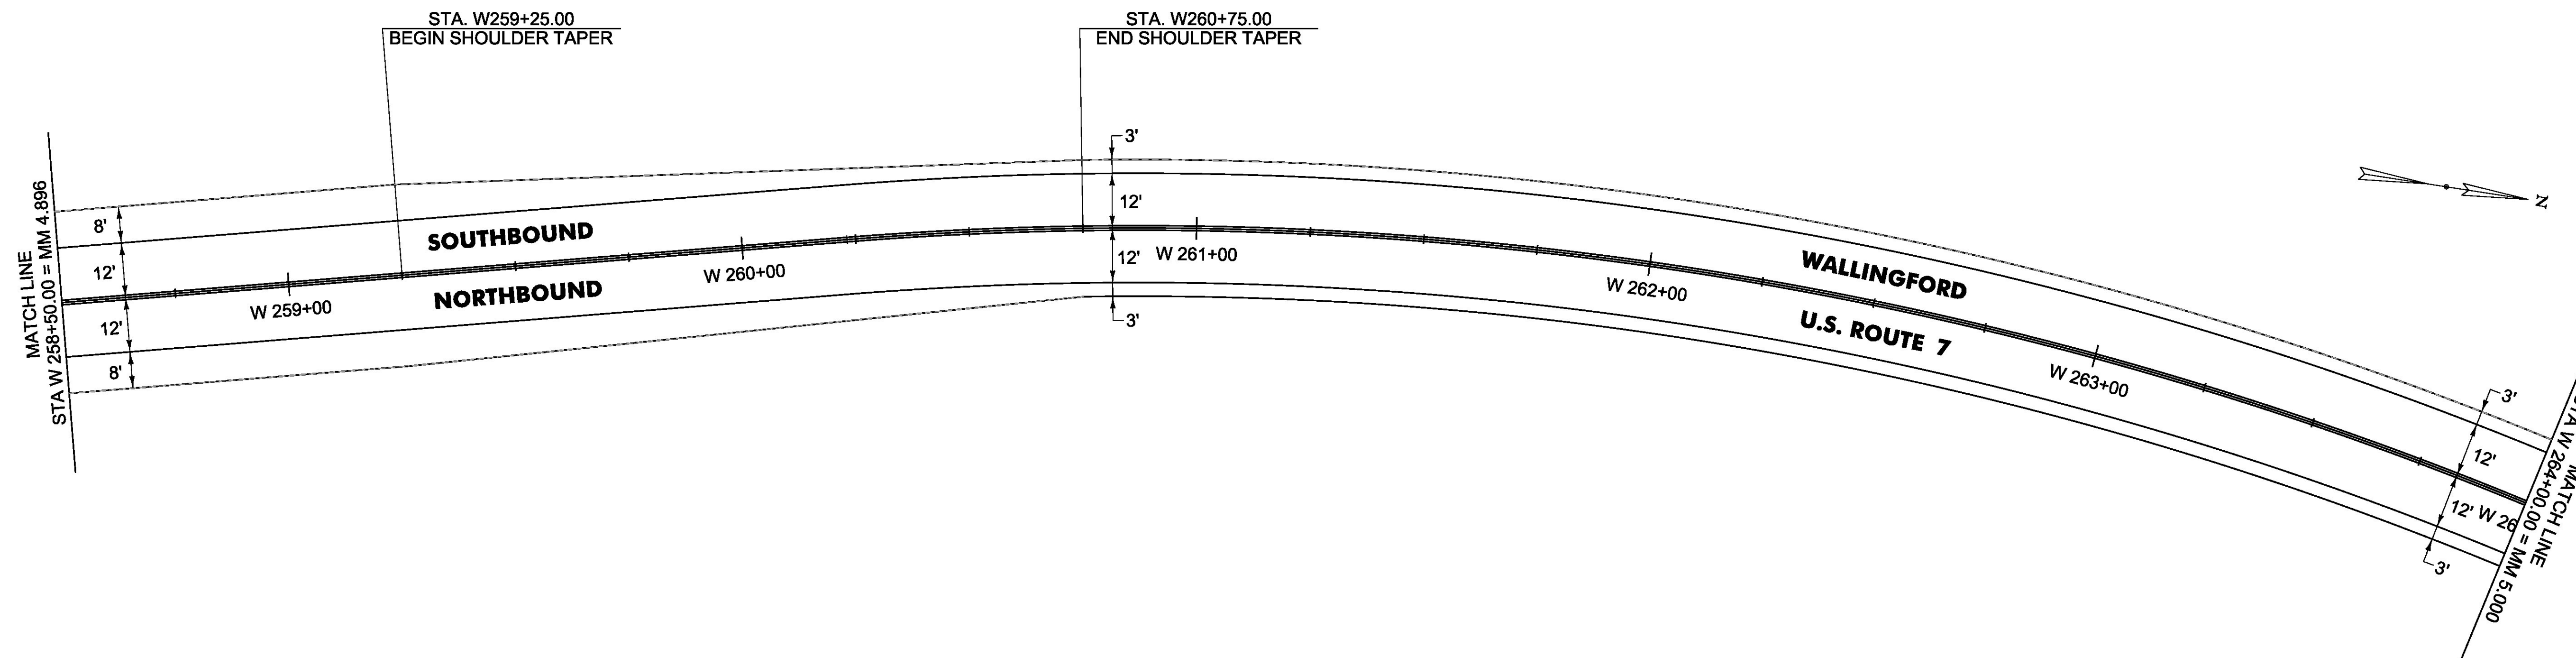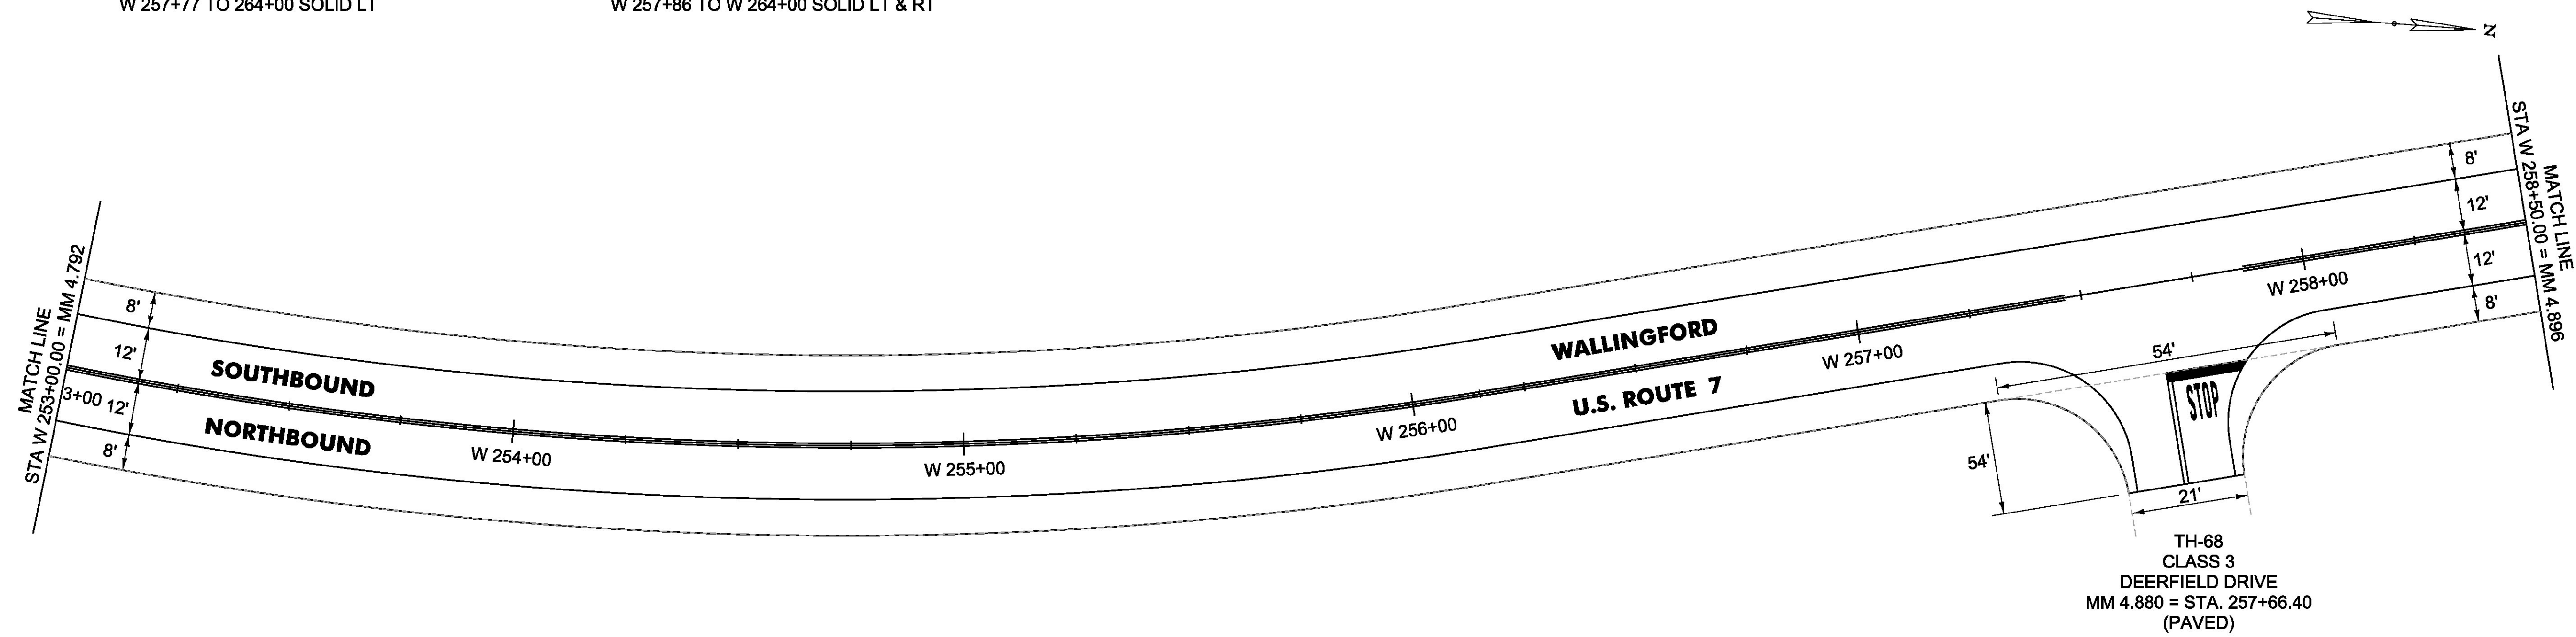

NOT TO SCALE

PROJECT NAME:	MANCHESTER-RUTLAND TOWN
PROJECT NUMBER:	NH SURF(50)
FILE NAME: layout37.dgn	PLOT DATE: 1/14/2016
PROJECT LEADER: M. FOWLER	DRAWN BY: B. KIPP
DESIGNED BY: B. KIPP	CHECKED BY: M. FOWLER
PLAN SHEET 37	SHEET 51 OF 105