


SPECIAL PROVISION(DURABLE 4 INCH WHITE LINE,
POLYUREA)(28 MILS)
W 269+50 TO W 275+00 SOLID LT & RT

SPECIAL PROVISION(DURABLE 4 INCH YELLOW LINE,
POLYUREA)(28 MILS)
W 269+50 TO W 275+00 SOLID LT & RT

TEMPORARY 4 INCH WHITE LINE, PAINT
W 269+50 TO W 275+00 SOLID LT & RT

TEMPORARY 4 INCH YELLOW LINE, PAINT
W 269+50 TO W 275+00 SOLID LT & RT

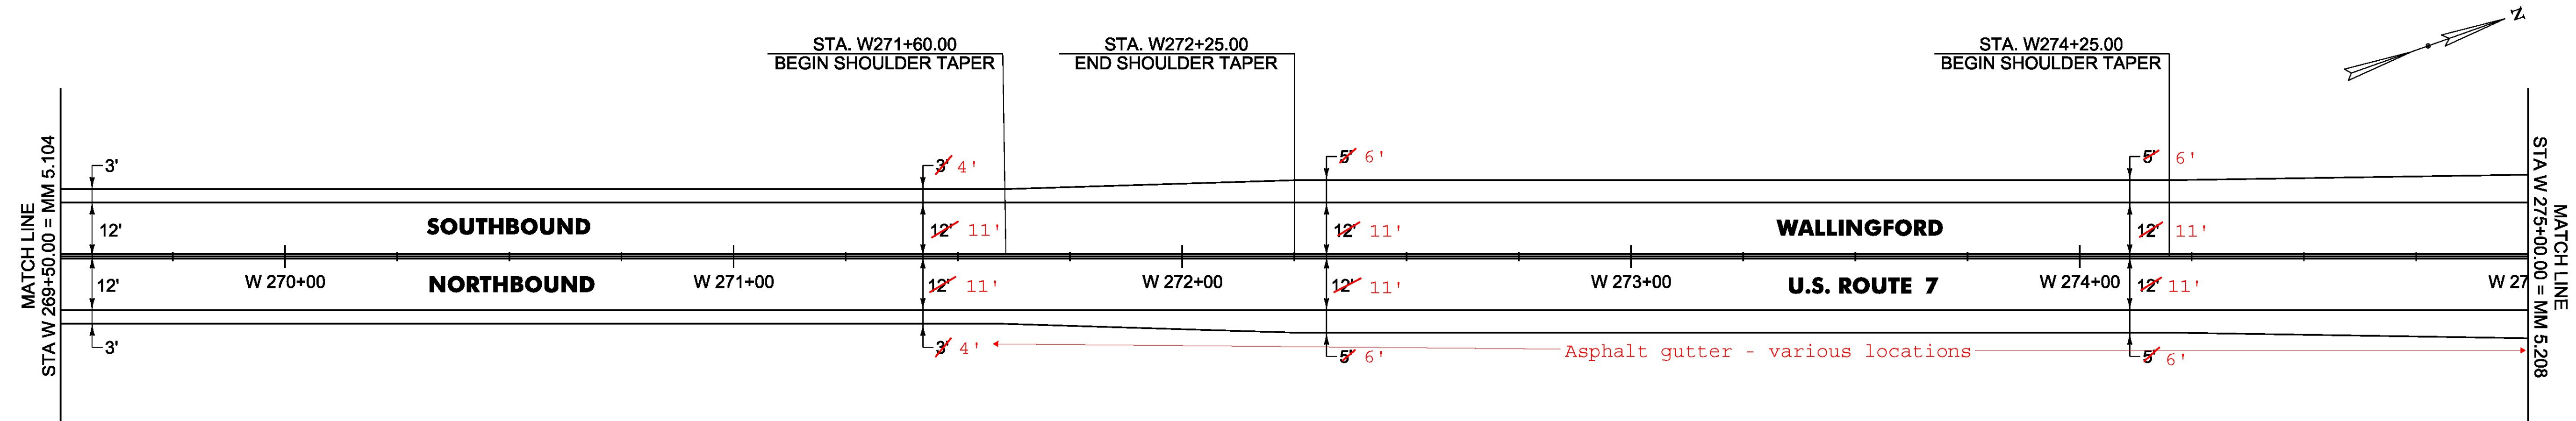

Asphalt gutter - various locations

NOT TO SCALE

PROJECT NAME:	MANCHESTER-RUTLAND TOWN
PROJECT NUMBER:	NH SURF(50)
FILE NAME:	layout39.dgn
PROJECT LEADER:	M. FOWLER
DESIGNED BY:	B. KIPP
PLAN SHEET	39
PLOT DATE:	1/14/2016
DRAWN BY:	B. KIPP
CHECKED BY:	M. FOWLER
SHEET	53 OF 105