

SPECIAL PROVISION(DURABLE 4 INCH WHITE LINE, POLYUREA)(28 MILS)
W 275+00 TO W 280+50 SOLID LT
W 275+00 TO W 277+90 SOLID RT
W 278+10 TO W 280+50 SOLID RT

TEMPORARY 4 INCH WHITE LINE, PAINT
W 275+00 TO W 280+50 SOLID LT
W 275+00 TO W 277+90 SOLID RT
W 278+10 TO W 280+50 SOLID RT

SPECIAL PROVISION(DURABLE 8 INCH WHITE LINE, POLYUREA)(28 MILS)
W 278+50 RT (HYD. CROSS HATCHING)

TEMPORARY 8 INCH WHITE LINE, PAINT
W 278+50 RT (HYD. CROSS HATCHING)

SPECIAL PROVISION(DURABLE 4 INCH YELLOW LINE, POLYUREA)(28 MILS)
W 275+00 TO W 277+86 SOLID LT & RT
W 278+20 DOUBLE SOLID LT
W 278+26 TO W 280+05 SOLID LT & RT

TEMPORARY 4 INCH YELLOW LINE, PAINT
W 275+00 TO W 277+86 SOLID LT & RT
W 278+20 DOUBLE SOLID LT
W 278+26 TO W 280+05 SOLID LT & RT

SPECIAL PROVISION(DURABLE 24 INCH STOP BAR, POLYUREA)(28 MILS)
W 278+06 TO W 278+18 RT (TH 17)


TEMPORARY 24 INCH STOP BAR, PAINT
W 278+06 TO W 278+18 RT (TH 17)

SPECIAL PROVISION(DURABLE LETTER OR SYMBOL, POLYUREA)(28 MILS)
W 278+12 RT "STOP" (TH 17) (4 EA)

TEMPORARY LETTER OR SYMBOL, PAINT
W 278+12 RT "STOP" (TH 17) (4 EA)

SPECIAL PROVISION(DURABLE CROSSWALK MARKING, POLYUREA)(28 MILS)
W 277+86 TO W 278+26 RT (TH 17)

TEMPORARY CROSSWALK MARKING, PAINT
W 277+86 TO W 278+26 RT (TH 17)

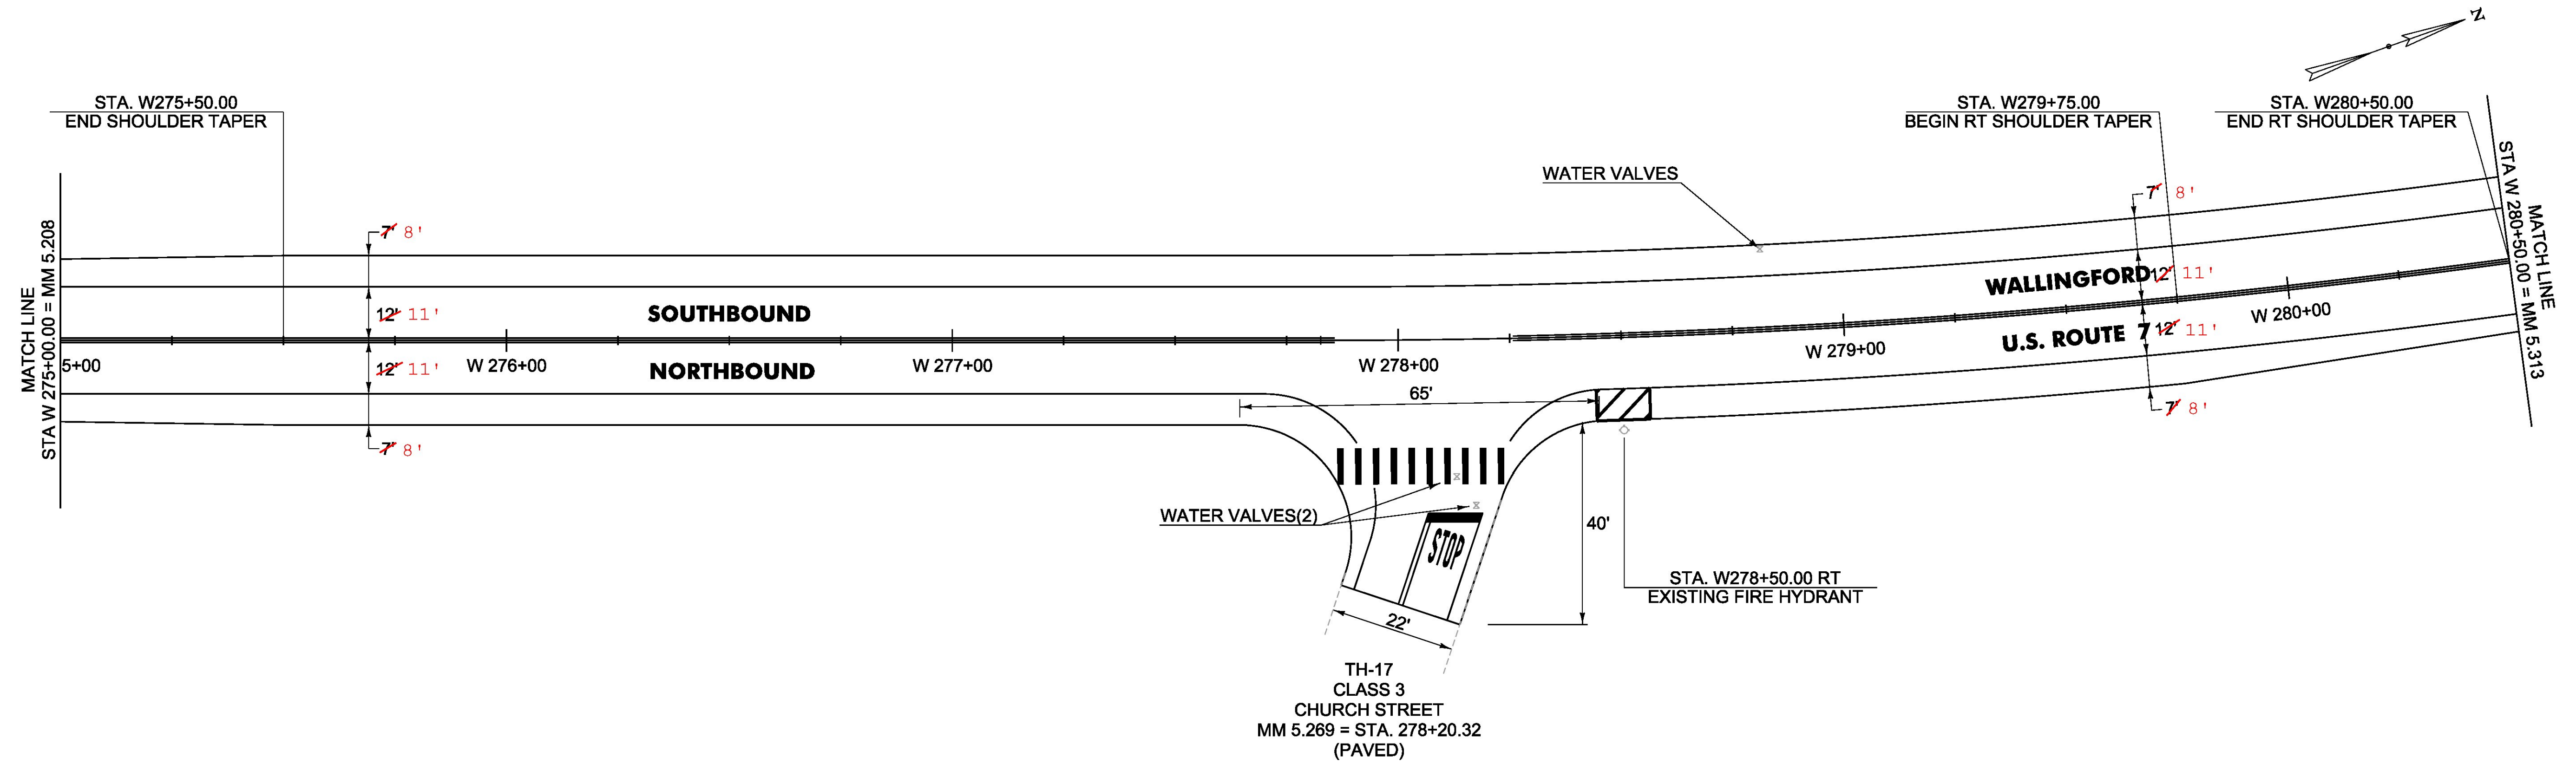

NOTE: EXISTING WATER VALVES AND SEWER MANHOLES SHALL BE ADJUSTED BY OTHERS IF NECESSARY.

PROJECT NAME:	MANCHESTER-RUTLAND TOWN
PROJECT NUMBER:	NH SURF(50)
FILE NAME:	layout40.dgn
PROJECT LEADER:	M. FOWLER
DESIGNED BY:	B. KIPP
PLAN SHEET	40
PLOT DATE:	1/14/2016
DRAWN BY:	B. KIPP
CHECKED BY:	M. FOWLER
SHEET	54 OF 105

NOT TO SCALE