

SPECIAL PROVISION(DURABLE 4 INCH WHITE LINE, POLYUREA)(28 MILS)  
 W 280+50 TO W 280+56 SOLID RT  
 W 280+50 TO W 281+31 SOLID LT  
 W 281+13 TO W 286+00 SOLID RT  
 W 281+50 TO W 286+00 SOLID LT

SPECIAL PROVISION(DURABLE 4 INCH YELLOW LINE, POLYUREA)(28 MILS)  
 W 280+50 TO W 280+64 SOLID LT & RT  
 W 281+05 TO W 281+16 SOLID LT & RT  
 W 281+26 DOUBLE SOLID LT  
 W 281+56 TO W 286+00 SOLID LT & RT

SPECIAL PROVISION(DURABLE 24 INCH STOP BAR, POLYUREA)(28 MILS)  
 W 281+25 TO W 281+37 LT (TH 56)

SPECIAL PROVISION(DURABLE LETTER OR SYMBOL, POLYUREA)(28 MILS)  
 W 281+30 LT "STOP" (TH 56) (4 EA)

SPECIAL PROVISION(DURABLE CROSSWALK MARKING, POLYUREA)(28 MILS)  
 W 280+75 TO W 280+92 RT (TH 11)  
 W 281+22 TO W 281+50 LT (TH 56)


TEMPORARY 4 INCH WHITE LINE, PAINT  
 W 280+50 TO W 280+56 SOLID RT  
 W 280+50 TO W 281+31 SOLID LT  
 W 281+13 TO W 286+00 SOLID RT  
 W 281+50 TO W 286+00 SOLID LT

TEMPORARY 4 INCH YELLOW LINE, PAINT  
 W 280+50 TO W 280+64 SOLID LT & RT  
 W 281+05 TO W 281+16 SOLID LT & RT  
 W 281+26 DOUBLE SOLID LT  
 W 281+56 TO W 286+00 SOLID LT & RT

TEMPORARY 24 INCH STOP BAR, PAINT  
 W 281+25 TO W 281+37 LT (TH 56)

TEMPORARY LETTER OR SYMBOL, PAINT  
 W 281+30 LT "STOP" (TH 56) (4 EA)

TEMPORARY CROSSWALK MARKING, PAINT  
 W 280+75 TO W 280+92 RT (TH 11)  
 W 281+22 TO W 281+50 LT (TH 56)

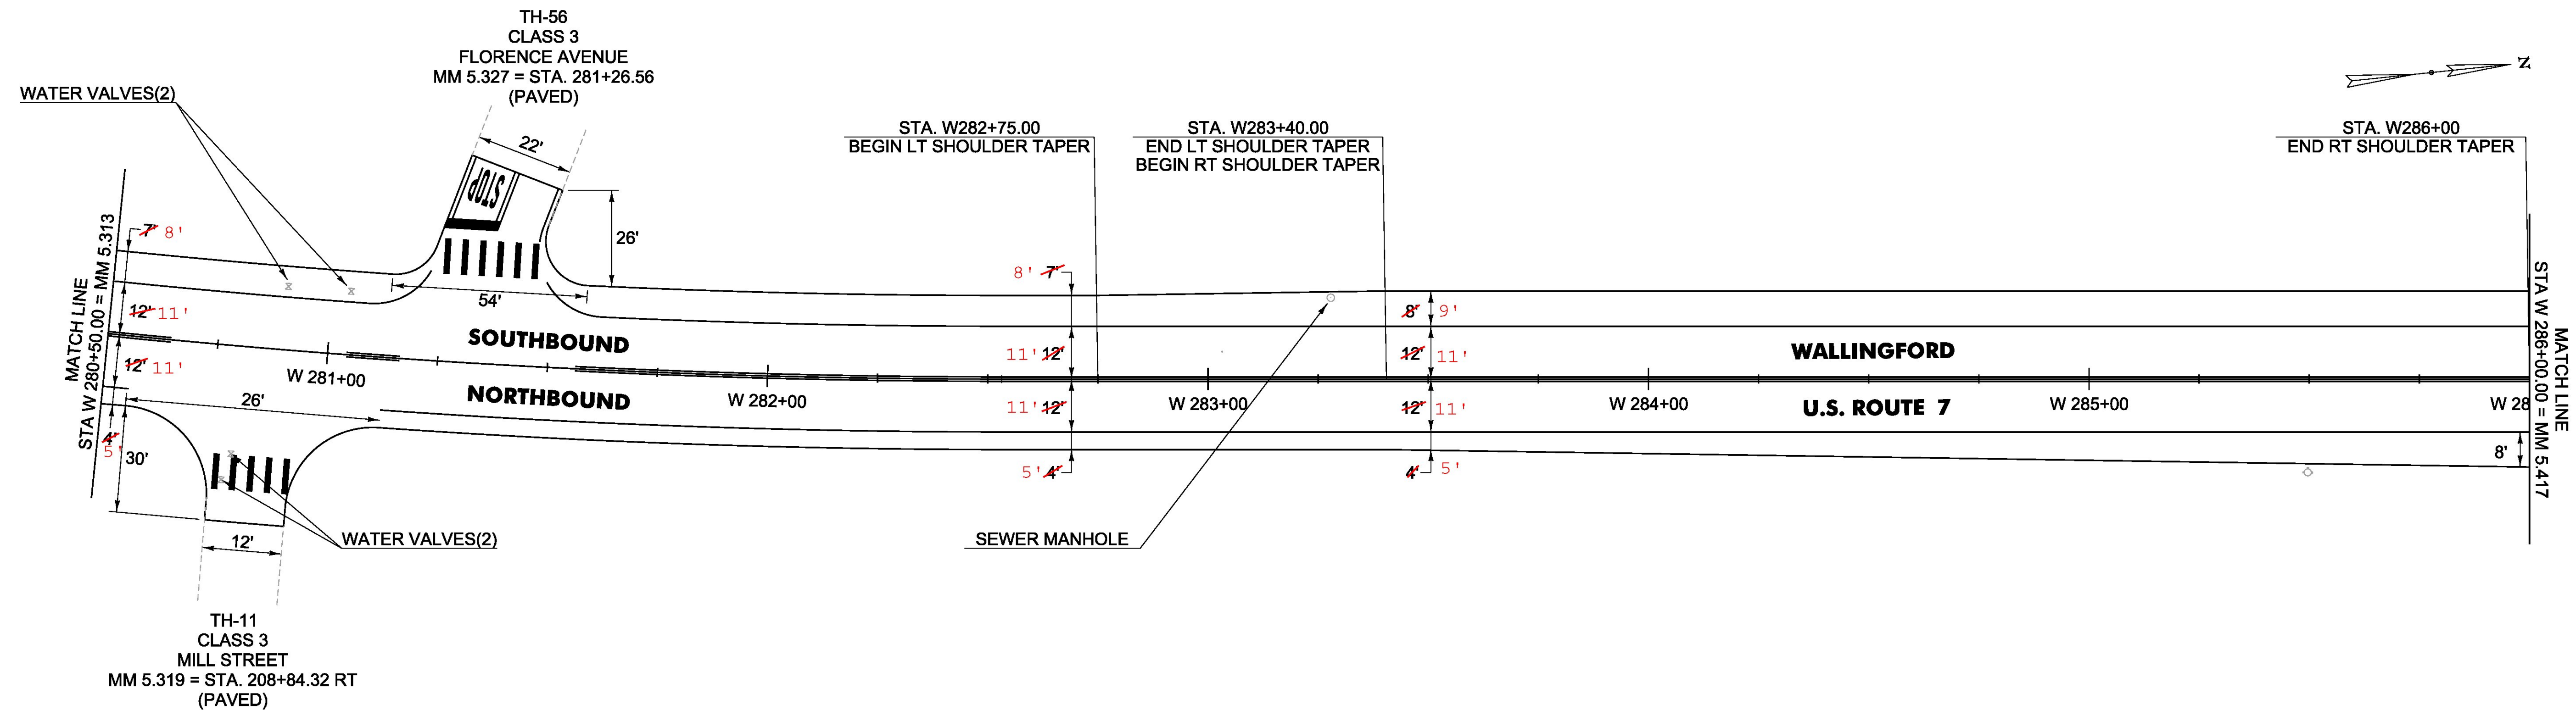

NOTE: EXISTING WATER VALVES AND SEWER MANHOLES SHALL BE ADJUSTED BY OTHERS IF NECESSARY.

PROJECT NAME:	MANCHESTER-RUTLAND TOWN
PROJECT NUMBER:	NH SURF(50)
FILE NAME:	layout41.dgn
PROJECT LEADER:	M. FOWLER
DESIGNED BY:	B. KIPP
PLAN SHEET 41	
PLOT DATE:	1/14/2016
DRAWN BY:	B. KIPP
CHECKED BY:	M. FOWLER
SHEET 55	OF 105

NOT TO SCALE