

SPECIAL PROVISION(DURABLE 4 INCH WHITE LINE, POLYUREA)(28 MILS)
 W 286+00 TO W 286+69 SOLID RT
 W 286+00 TO W 286+73 SOLID LT
 W 286+81 TO W 286+88 SOLID RT
 W 286+83 TO W 286+92 SOLID LT
 W 287+14 TO W 287+26 SOLID RT
 W 287+22 TO W 287+30 SOLID LT
 W 287+39 TO W 291+50 SOLID RT
 W 287+39 TO W 291+50 SOLID LT

VT ROUTE 140:
 W 287+00 SOLID RT & LT

TEMPORARY 4 INCH WHITE LINE, PAINT
 W 286+00 TO W 286+69 SOLID RT
 W 286+00 TO W 286+73 SOLID LT
 W 286+81 TO W 286+88 SOLID RT
 W 286+83 TO W 286+92 SOLID LT
 W 287+14 TO W 287+26 SOLID RT
 W 287+22 TO W 287+30 SOLID LT
 W 287+39 TO W 291+50 SOLID RT
 W 287+39 TO W 291+50 SOLID LT

VT ROUTE 140:
 W 287+00 SOLID RT & LT

SPECIAL PROVISION(DURABLE 4 INCH YELLOW LINE, POLYUREA)(28 MILS)
 W 286+00 TO W 286+64 SOLID RT & LT
 W 287+43 TO W 291+50 SOLID RT & LT

VT ROUTE 140:
 W 287+00 DOUBLE SOLID RT
 W 287+00 DOUBLE SOLID LT

TEMPORARY 4 INCH YELLOW LINE, PAINT
 W 286+00 TO W 286+64 SOLID RT & LT
 W 287+43 TO W 291+50 SOLID RT & LT

VT ROUTE 140:
 W 287+00 DOUBLE SOLID RT
 W 287+00 DOUBLE SOLID LT

SPECIAL PROVISION(DURABLE 8 INCH WHITE LINE, POLYUREA)(28 MILS)
 W 290+00 LT (HYD. CROSS HATCHING)


TEMPORARY 8 INCH WHITE LINE, PAINT
 W 290+00 LT (HYD. CROSS HATCHING)

SPECIAL PROVISION(DURABLE 24 INCH STOP BAR, POLYUREA)(28 MILS)
 W 286+63 RT
 W 287+00 RT & LT (VT ROUTE 140)
 W 287+44 LT

TEMPORARY 24 INCH STOP BAR, PAINT
 W 286+63 RT
 W 287+00 RT & LT (VT ROUTE 140)
 W 287+44 LT

SPECIAL PROVISION(DURABLE CROSSWALK MARKING, POLYUREA)(28 MILS)
 W 286+77
 W 286+88 TO W 287+14 RT
 W 286+93 TO W 287+21 LT
 W 287+33

TEMPORARY CROSSWALK MARKING, PAINT
 W 286+77
 W 286+88 TO W 287+14 RT
 W 286+93 TO W 287+21 LT
 W 287+33

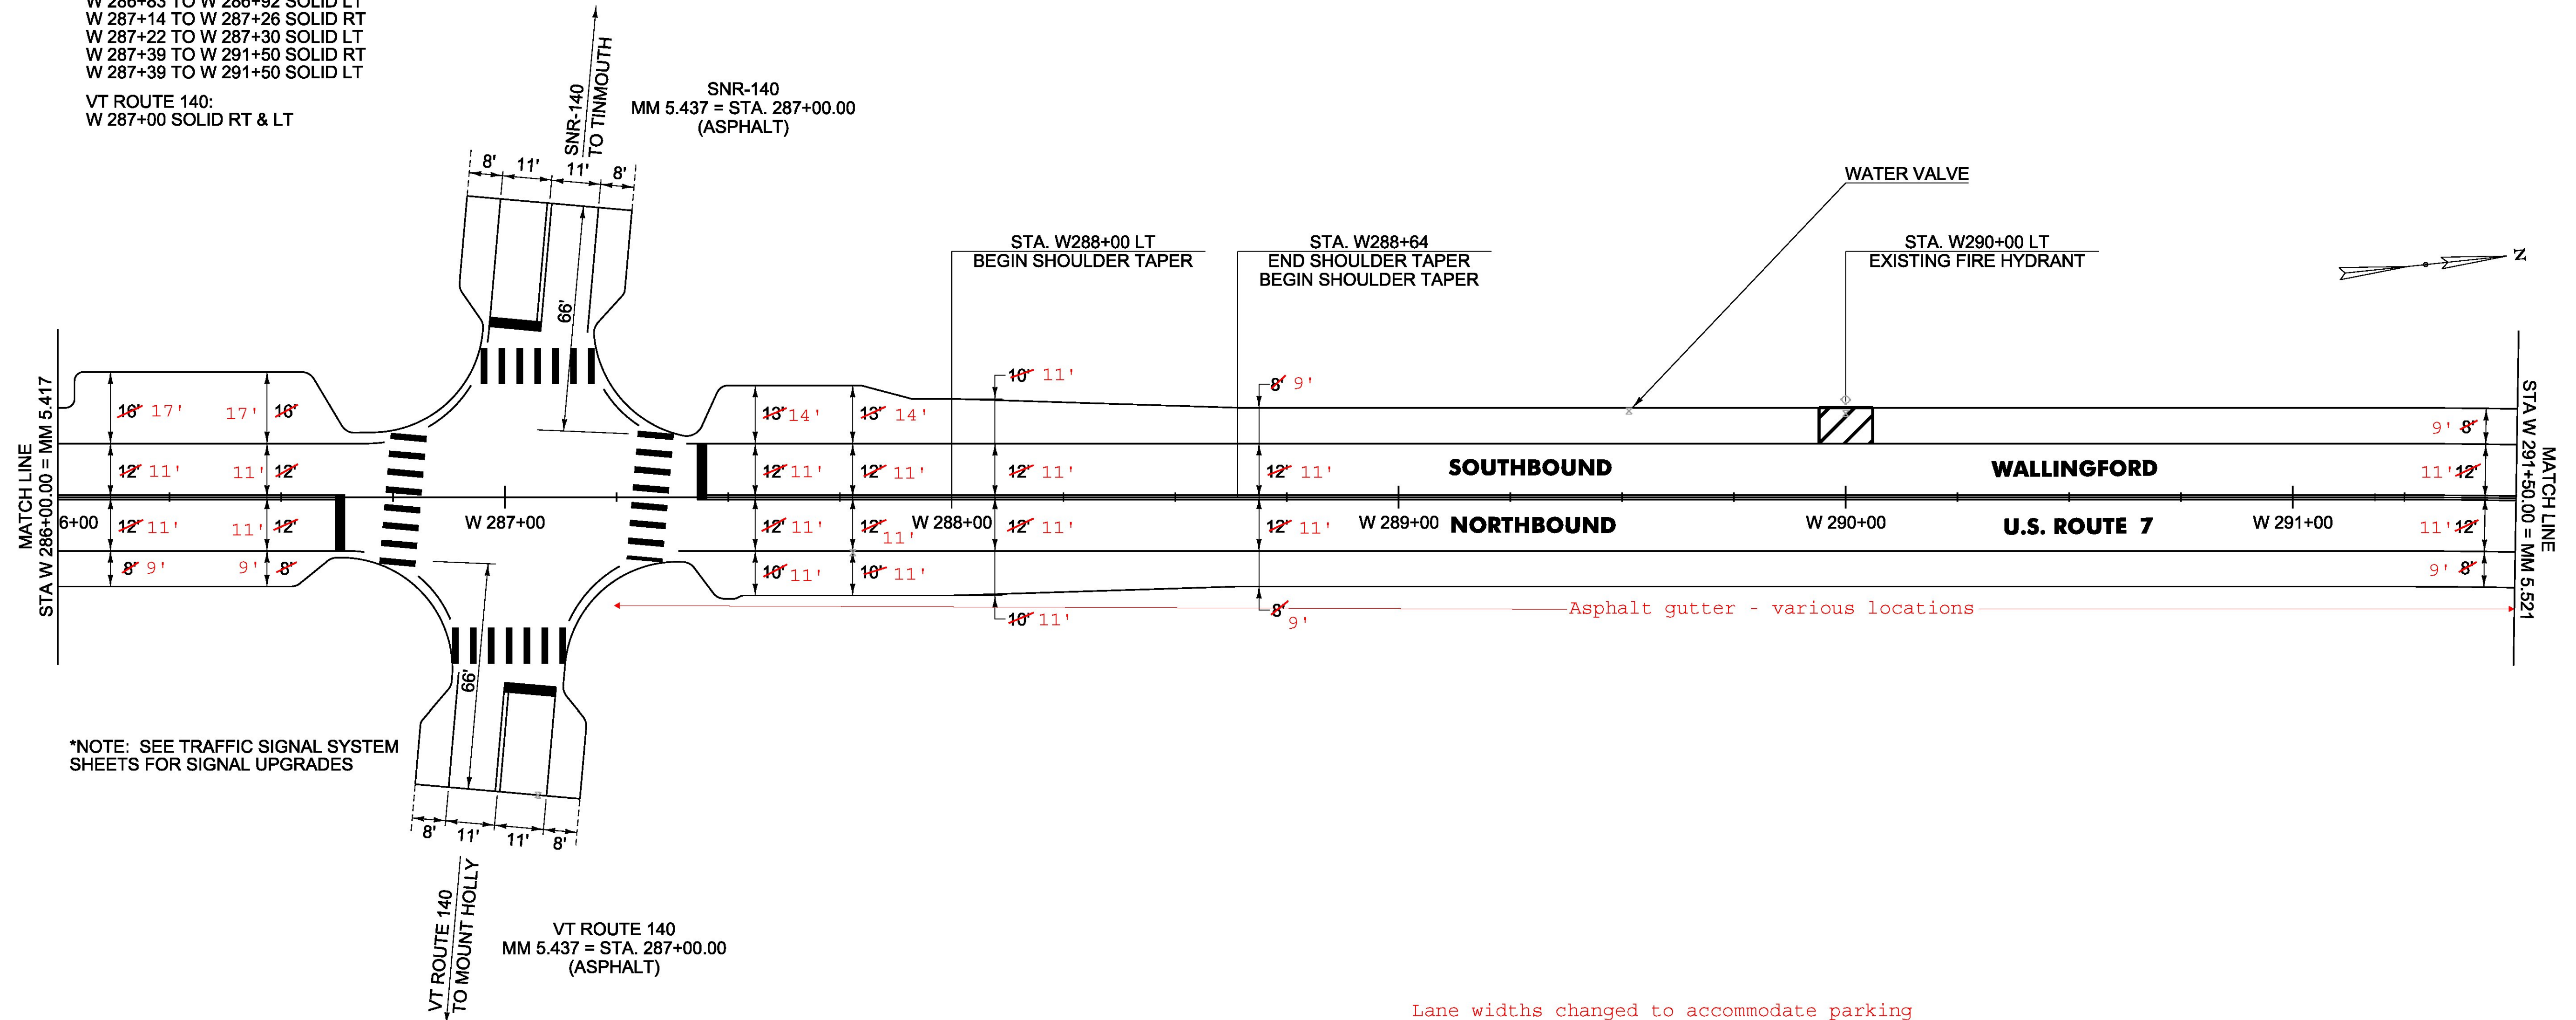

*NOTE: SEE TRAFFIC SIGNAL SYSTEM SHEETS FOR SIGNAL UPGRADES

Lane widths changed to accommodate parking

NOTE: EXISTING WATER VALVES AND SEWER MANHOLES SHALL BE ADJUSTED BY OTHERS IF NECESSARY.

PROJECT NAME:	MANCHESTER-RUTLAND TOWN
PROJECT NUMBER:	NH SURF(50)
FILE NAME:	layout42.dgn
PROJECT LEADER:	M. FOWLER
DESIGNED BY:	B. KIPP
PLAN SHEET	42
PLOT DATE:	1/14/2016
DRAWN BY:	B. KIPP
CHECKED BY:	M. FOWLER
SHEET	56 OF 105

NOT TO SCALE