

SPECIAL PROVISION(DURABLE 4 INCH WHITE LINE, POLYUREA)(28 MILS)
W 291+50 TO W 295+68 SOLID RT
W 291+50 TO W 293+56 SOLID LT
W 293+78 TO W 297+00 SOLID LT
W 295+90 TO W 297+00 SOLIDRT

SPECIAL PROVISION(DURABLE 4 INCH YELLOW LINE, POLYUREA)(28 MILS)
W 291+50 TO W 293+47 SOLID RT & LT
W 293+67 DOUBLE SOLID LT (TH 58)
W 293+87 TO W 295+59 SOLID RT & LT
W 295+79 DOUBLE SOLID RT (TH 10)

SPECIAL PROVISION(DURABLE 8 INCH WHITE LINE, POLYUREA)(28 MILS)
W 293+53 LT (HYD. CROSS HATCHING)
TEMPORARY 8 INCH WHITE LINE, PAINT
W 293+53 LT (HYD. CROSS HATCHING)

SPECIAL PROVISION(DURABLE 24 INCH STOP BAR, POLYUREA)(28 MILS)
W 293+56 TO W 293+68 LT (TH 58)
W 295+79 TO W 295+92 RT (TH 10)
TEMPORARY 24 INCH STOP BAR, PAINT
W 293+56 TO W 293+68 LT (TH 58)
W 295+79 TO W 295+92 RT (TH 10)


SPECIAL PROVISION(DURABLE LETTER OR SYMBOL, POLYUREA)(28 MILS)
W 293+61 LT "STOP" (TH 58) (4 EA)
W 295+85 RT "STOP" (TH 10) (4 EA)
TEMPORARY LETTER OR SYMBOL, PAINT
W 293+61 LT "STOP" (TH 58) (4 EA)
W 295+85 RT "STOP" (TH 10) (4 EA)

TEMPORARY 4 INCH WHITE LINE, PAINT
W 291+50 TO W 295+68 SOLID RT
W 291+50 TO W 293+56 SOLID LT
W 293+78 TO W 297+00 SOLID LT
W 295+90 TO W 297+00 SOLIDRT

TEMPORARY 4 INCH YELLOW LINE, PAINT
W 291+50 TO W 293+47 SOLID RT & LT
W 293+67 DOUBLE SOLID LT (TH 58)
W 293+87 TO W 295+59 SOLID RT & LT
W 295+79 DOUBLE SOLID RT (TH 10)

SPECIAL PROVISION(DURABLE CROSSWALK MARKING, POLYUREA)(28 MILS)
W 293+62 LT (TH 58)
W 295+85 RT (TH 10)

TEMPORARY CROSSWALK MARKING, PAINT
W 293+62 LT (TH 58)
W 295+85 RT (TH 10)

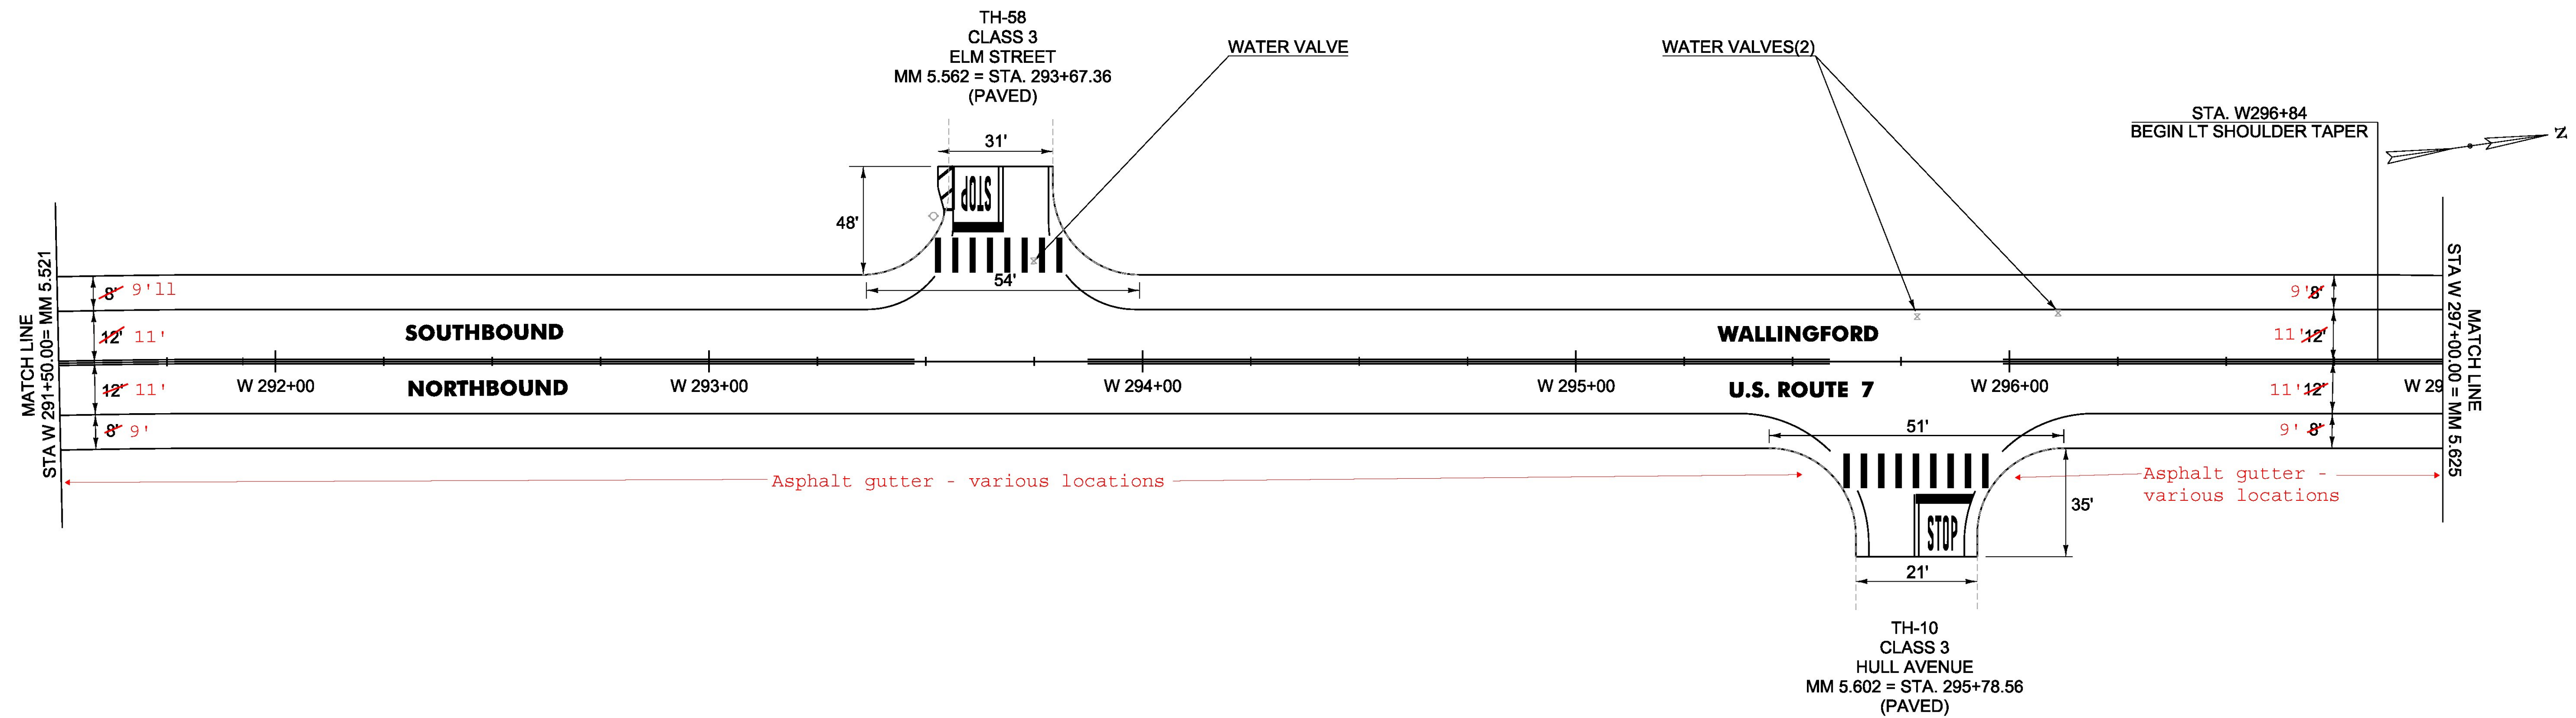

NOTE: EXISTING WATER VALVES AND SEWER MANHOLES SHALL BE ADJUSTED BY OTHERS IF NECESSARY.

PROJECT NAME:	MANCHESTER-RUTLAND TOWN
PROJECT NUMBER:	NH SURF(50)
FILE NAME:	layout43.dgn
PROJECT LEADER:	M. FOWLER
DESIGNED BY:	B. KIPP
PLAN SHEET	43
PLOT DATE:	1/14/2016
DRAWN BY:	B. KIPP
CHECKED BY:	M. FOWLER
SHEET	57 OF 105

NOT TO SCALE