

SPECIAL PROVISION(DURABLE 4 INCH WHITE LINE, POLYUREA)(28 MILS)
W 297+00 TO W 300+59 SOLID RT
W 297+00 TO W 300+79 SOLID LT
W 301+02 TO W 302+50 SOLID LT
W 301+10 TO W 302+50 SOLID RT

SPECIAL PROVISION(DURABLE 4 INCH YELLOW LINE, POLYUREA)(28 MILS)
W 297+00 TO W 300+64 SOLID RT & LT
W 300+91 DOUBLE SOLID LT (TH 64)
W 301+10 TO W 302+50 SOLID RT & LT

SPECIAL PROVISION(DURABLE 8 INCH WHITE LINE, POLYUREA)(28 MILS)
W 300+50 LT (HYD. CROSS HATCHING)
W 301+25 TO W 302+50 RT (CROSS HATCHING)

SPECIAL PROVISION(DURABLE LETTER OR SYMBOL, POLYUREA)(28 MILS)
W 300+84 LT "STOP" (TH 64) (4 EA)
TEMPORARY LETTER OR SYMBOL, PAINT
W 300+84 LT "STOP" (TH 64) (4 EA)

SPECIAL PROVISION(DURABLE 24 INCH STOP BAR, POLYUREA)(28 MILS)
W 300+76 TO W 300+91 LT (TH 64)
DURABLE 24 INCH STOP BAR, POLYUREA
W 300+76 TO W 300+91 LT (TH 64)


TEMPORARY 4 INCH WHITE LINE, PAINT
W 297+00 TO W 300+59 SOLID RT
W 297+00 TO W 300+79 SOLID LT
W 301+02 TO W 302+50 SOLID LT
W 301+10 TO W 302+50 SOLID RT

TEMPORARY 4 INCH YELLOW LINE, PAINT
W 297+00 TO W 300+64 SOLID RT & LT
W 300+91 DOUBLE SOLID LT (TH 64)
W 301+10 TO W 302+50 SOLID RT & LT

TEMPORARY 8 INCH WHITE LINE, PAINT
W 300+50 LT (HYD. CROSS HATCHING)
W 301+25 TO W 302+50 RT (CROSS HATCHING)

SPECIAL PROVISION(DURABLE CROSSWALK MARKING, POLYUREA)(28 MILS)
W 300+71 TO W 301+11 LT

TEMPORARY CROSSWALK MARKING, PAINT
W 300+71 TO W 301+11 LT

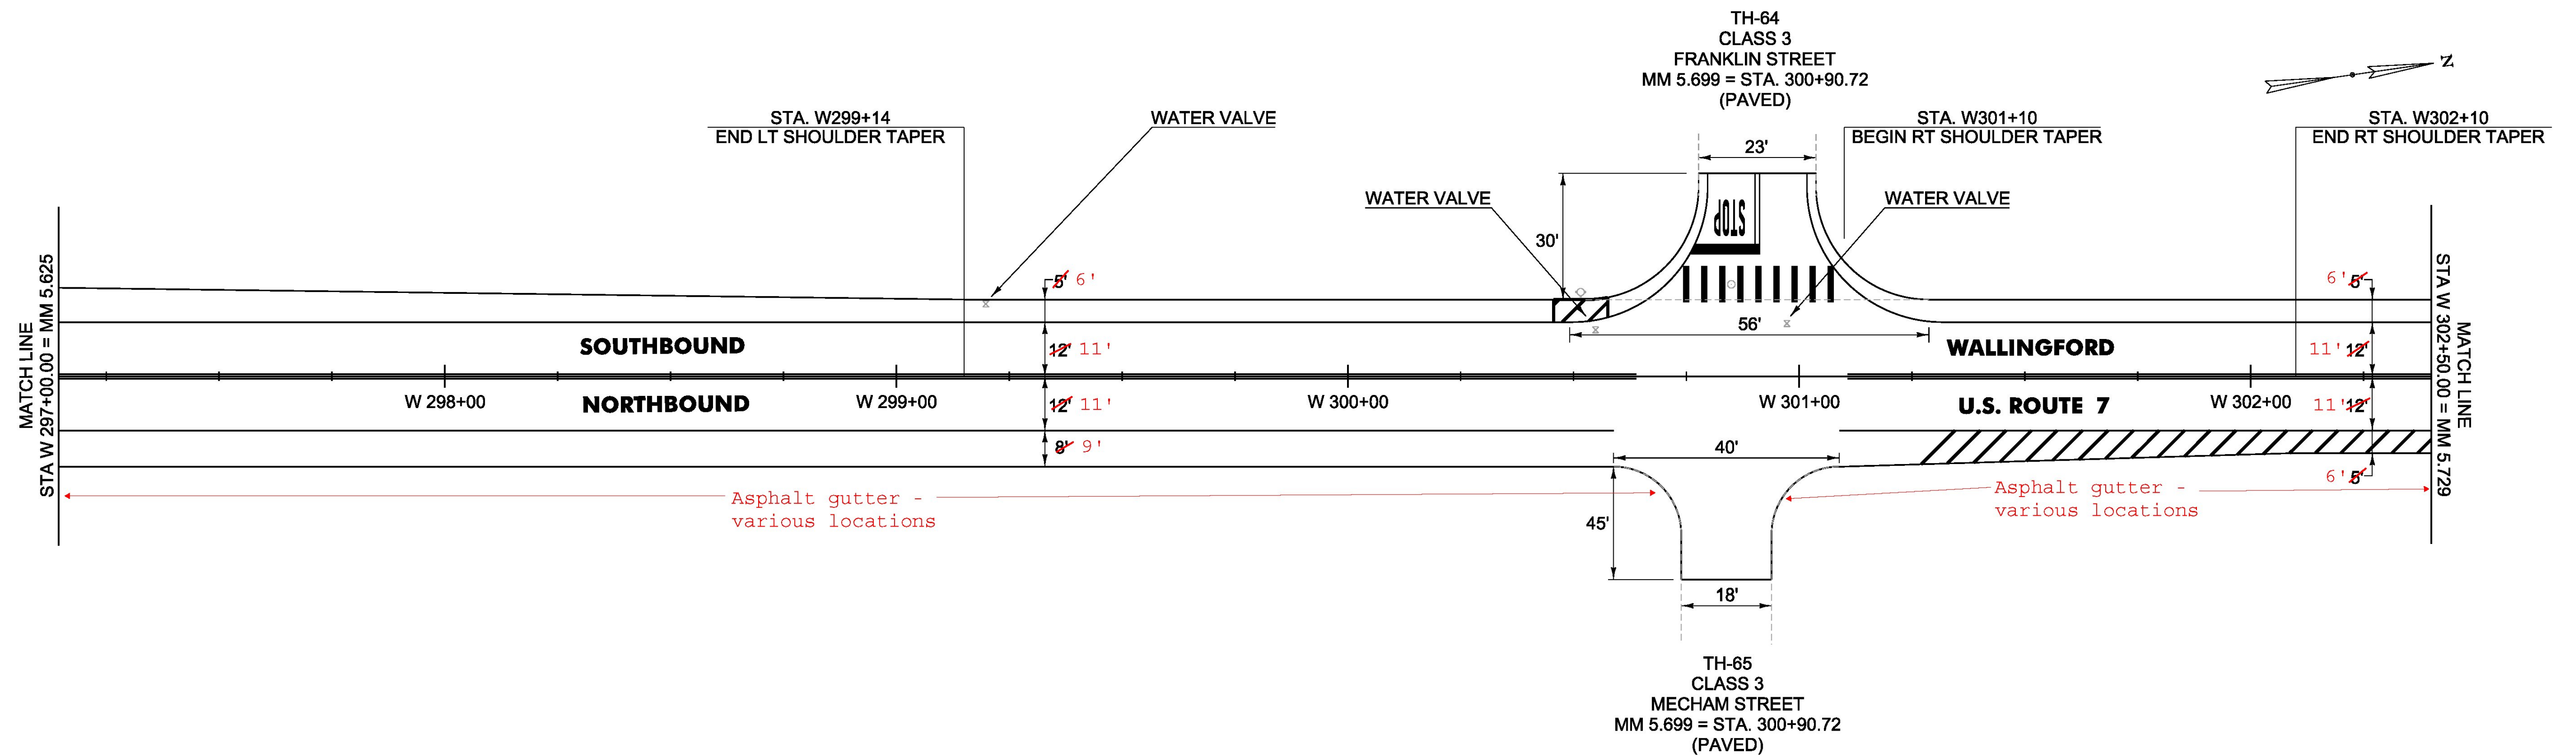

NOTE: EXISTING WATER VALVES AND SEWER MANHOLES SHALL BE ADJUSTED BY OTHERS IF NECESSARY.

PROJECT NAME:	MANCHESTER-RUTLAND TOWN
PROJECT NUMBER:	NH SURF(50)
FILE NAME:	layout44.dgn
PROJECT LEADER:	M. FOWLER
DESIGNED BY:	B. KIPP
PLAN SHEET	44
PLOT DATE:	1/14/2016
DRAWN BY:	N. PAPPAS
CHECKED BY:	M. FOWLER
SHEET	58 OF 105

NOT TO SCALE