

SPECIAL PROVISION(DURABLE 4 INCH WHITE LINE, POLYUREA)(28 MILS)
 W 302+50 TO W 303+19 RT
 W 302+50 TO W 304+48 LT
 W 303+69 TO W 308+00 RT
 W 304+71 TO W 308+00 LT

SPECIAL PROVISION(DURABLE 4 INCH YELLOW LINE, POLYUREA)(28 MILS)
 W 302+50 TO W 303+19 RT & LT
 W 304+60 DOUBLE SOLID LT
 W 303+64 TO W 304+40 RT & LT
 W 304+80 TO W 308+00 RT & LT

SPECIAL PROVISION(DURABLE 8 INCH WHITE LINE, POLYUREA)(28 MILS)
 W 302+50 TO 303+16 RT (CROSS HATCHING)

 TEMPORARY 8 INCH WHITE LINE, PAINT
 W 302+50 TO 303+16 RT (CROSS HATCHING)

SPECIAL PROVISION(DURABLE LETTER OR SYMBOL, POLYUREA)(28 MILS)
 W 304+50 LT "STOP" (TH 2) (4 EA)


 TEMPORARY LETTER OR SYMBOL, PAINT
 W 304+50 LT "STOP" (TH 2) (4 EA)

SPECIAL PROVISION(DURABLE 24 INCH STOP BAR, POLYUREA)(28 MILS)
 W 304+34 TO W 304+60 LT (TH 2)

 TEMPORARY 24 INCH STOP BAR, PAINT
 W 304+34 TO W 304+60 LT (TH 2)

TEMPORARY 4 INCH WHITE LINE, PAINT
 W 302+50 TO W 303+19 RT
 W 302+50 TO W 304+48 LT
 W 303+69 TO W 308+00 RT
 W 304+71 TO W 308+00 LT

TEMPORARY 4 INCH YELLOW LINE, PAINT
 W 302+50 TO W 303+19 RT & LT
 W 304+60 DOUBLE SOLID LT
 W 303+64 TO W 304+40 RT & LT
 W 304+80 TO W 308+00 RT & LT

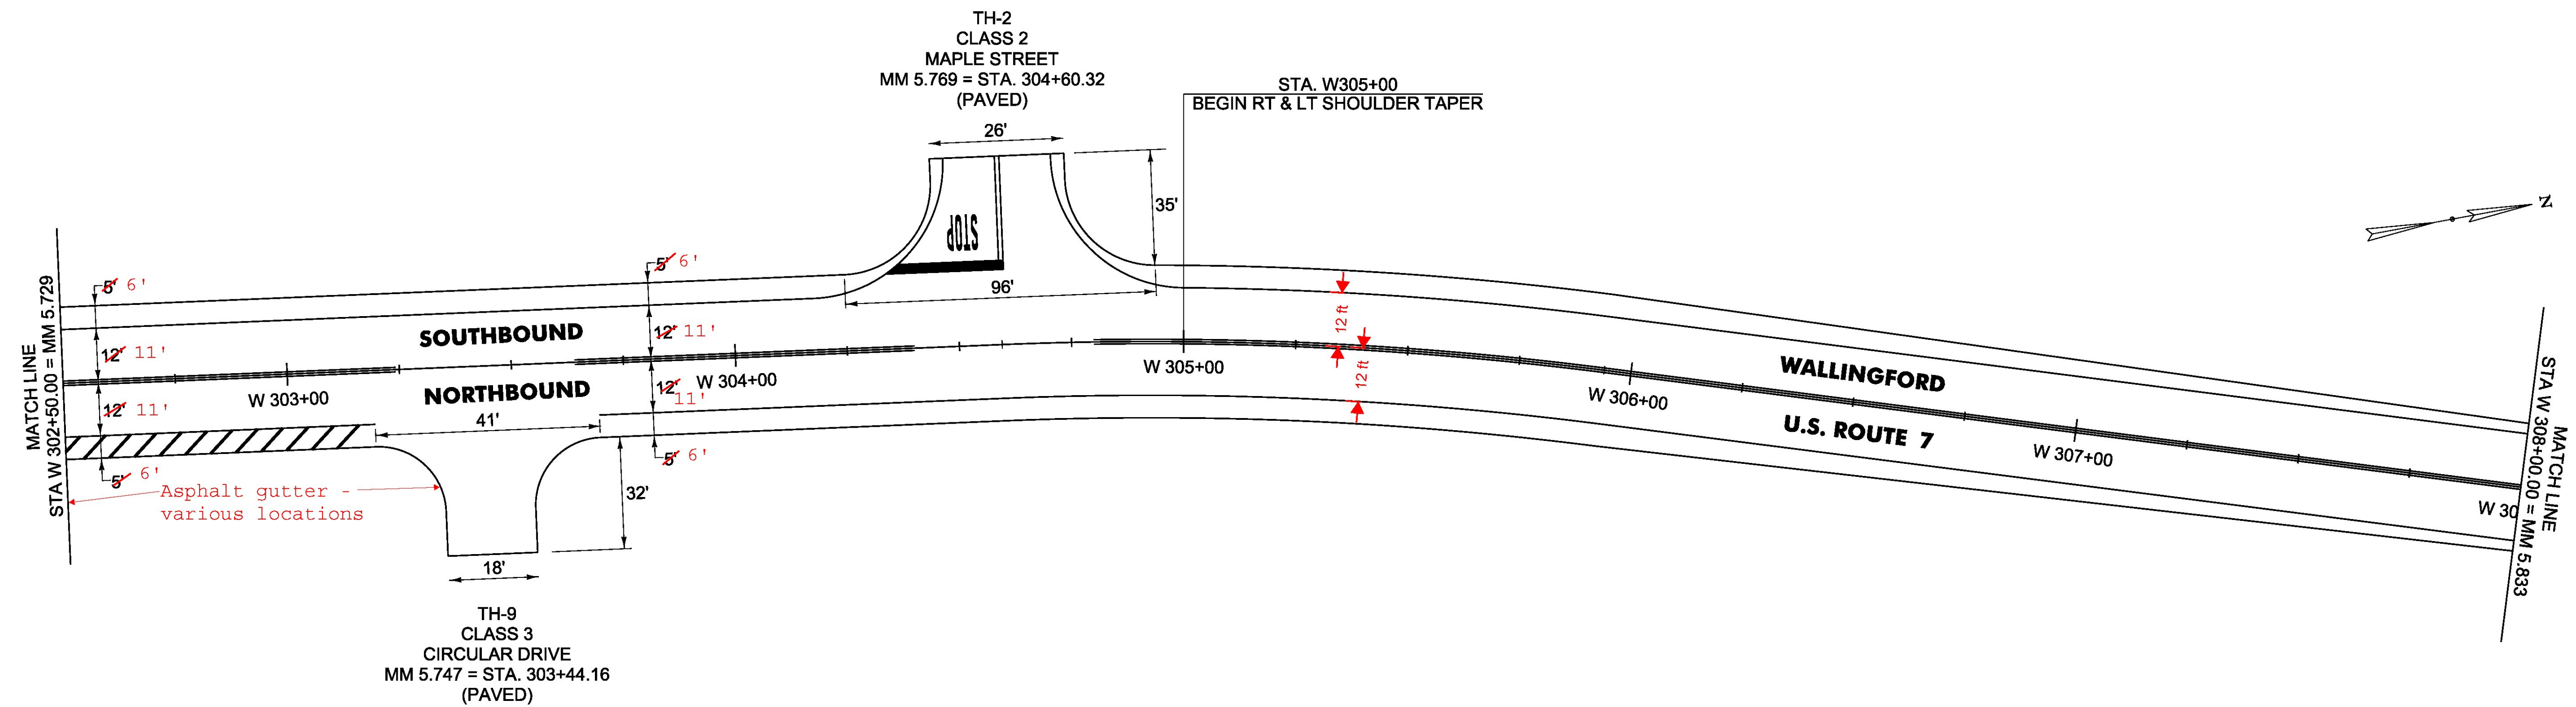

NOT TO SCALE

PROJECT NAME:	MANCHESTER-RUTLAND TOWN
PROJECT NUMBER:	NH SURF(50)
FILE NAME:	layout45.dgn
PROJECT LEADER:	M. FOWLER
DESIGNED BY:	B. KIPP
PLAN SHEET	45
PLOT DATE:	1/14/2016
DRAWN BY:	N. PAPPAS
CHECKED BY:	M. FOWLER
SHEET	59 OF 105