


SPECIAL PROVISION(DURABLE 4 INCH WHITE LINE,
POLYUREA)(28 MILS)
W 319+00 TO W 322+91 RT
W 322+31 TO W 330+00 LT
TEMPORARY 4 INCH WHITE LINE, PAINT
W 319+00 TO W 322+91 RT
W 322+31 TO W 330+00 LT

SPECIAL PROVISION(DURABLE 4 INCH YELLOW LINE,
POLYUREA)(28 MILS)
W 319+00 TO W 322+91 RT
W 322+31 TO W 330+00 LT
TEMPORARY 4 INCH YELLOW LINE, PAINT
W 319+00 TO W 322+91 RT
W 322+31 TO W 330+00 LT

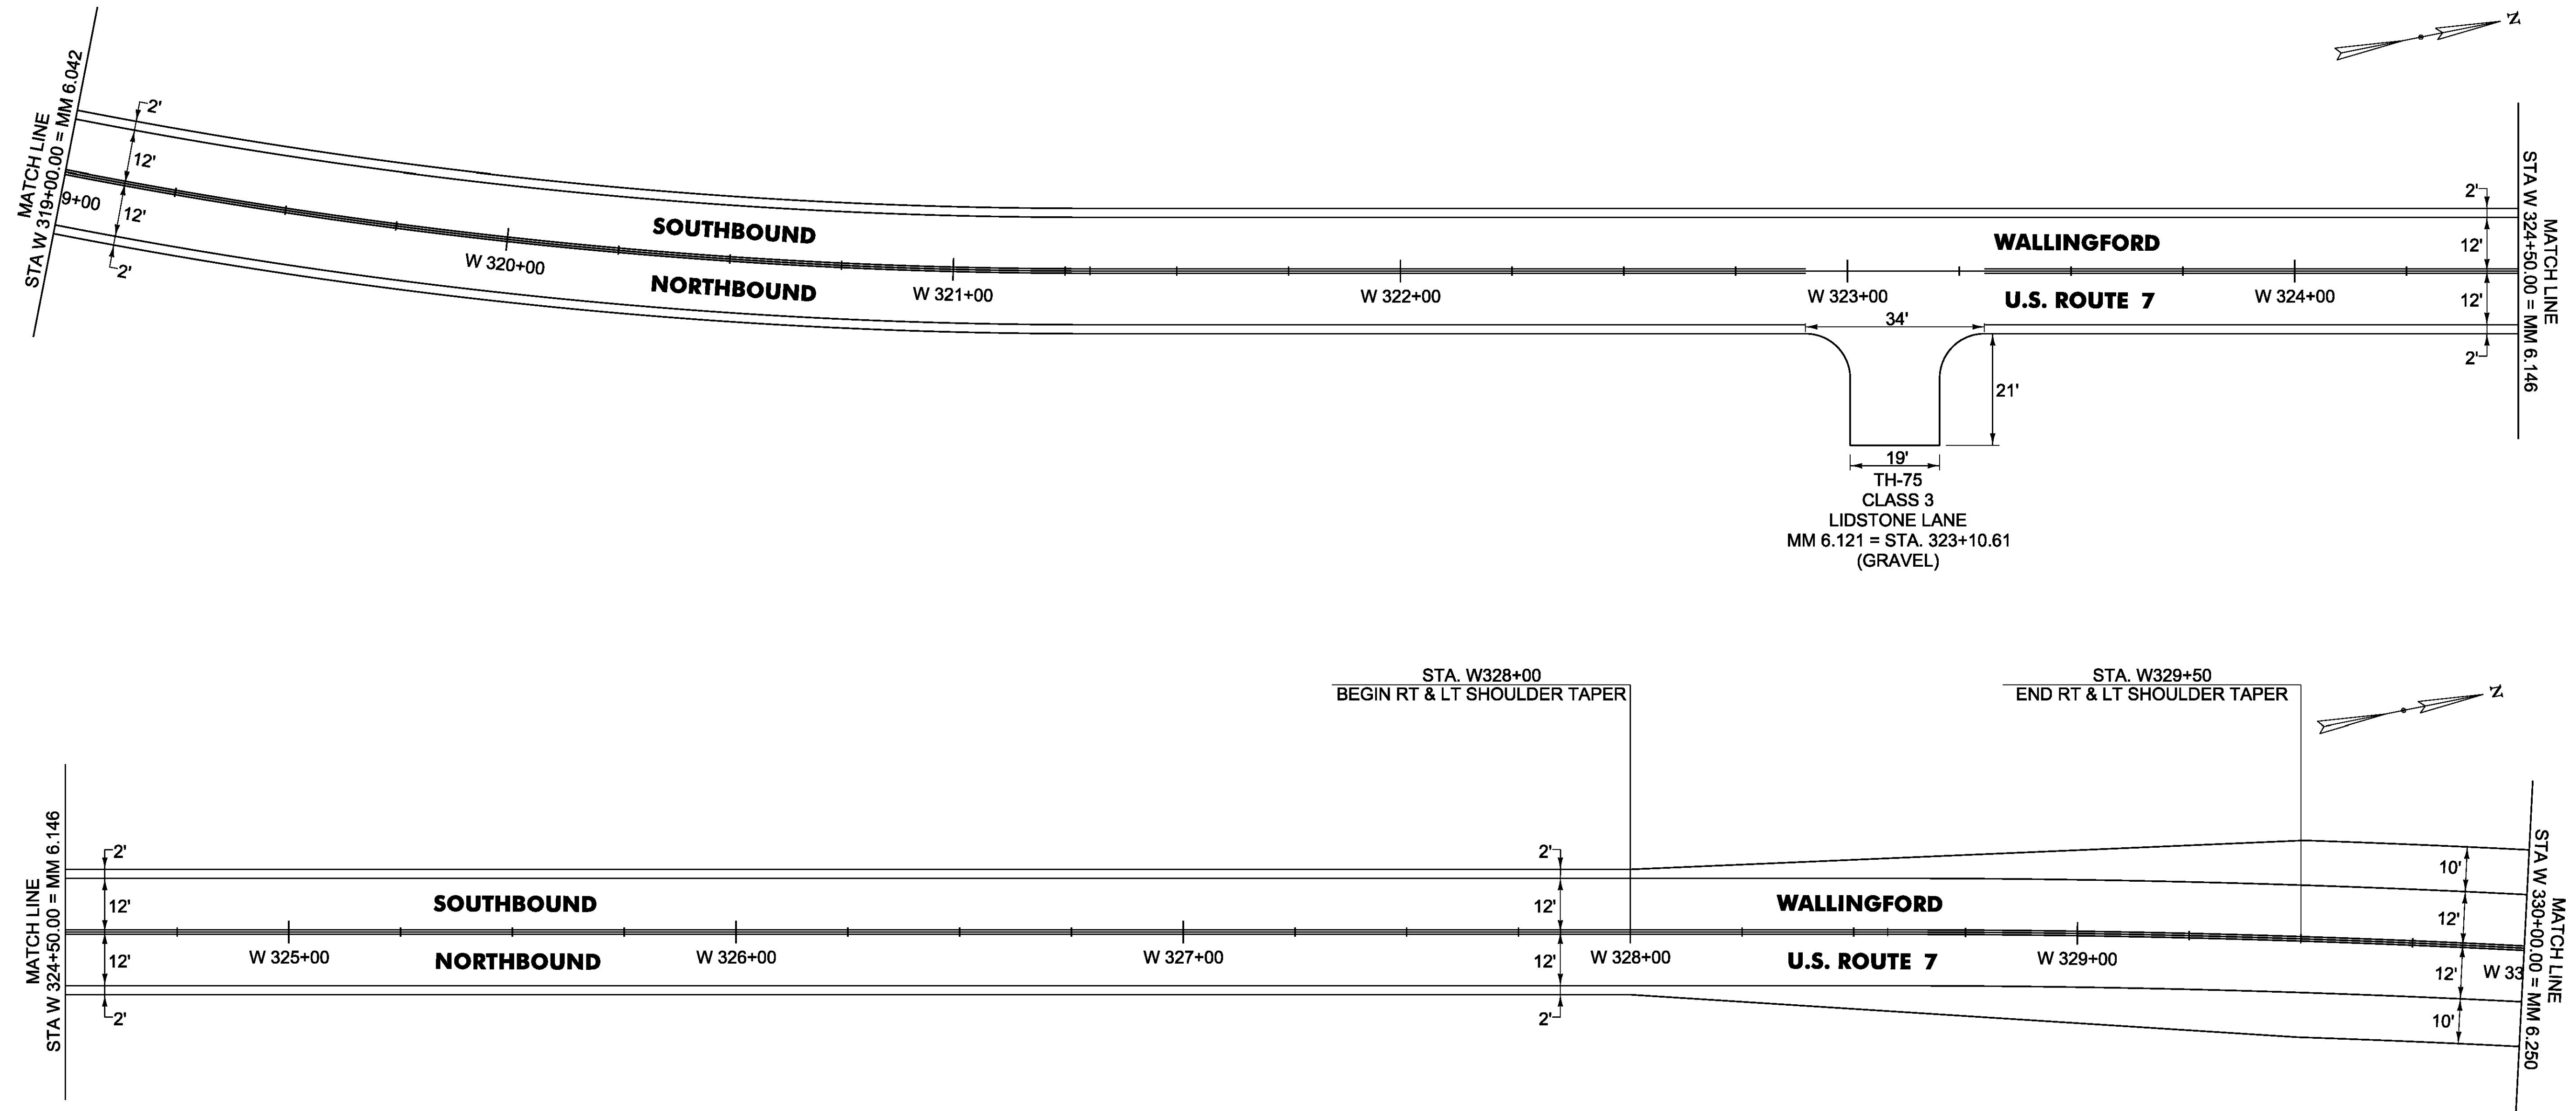

STA. W328+00
BEGIN RT & LT SHOULDER TAPER

STA. W329+50
END RT & LT SHOULDER TAPER

NOT TO SCALE

PROJECT NAME:	MANCHESTER-RUTLAND TOWN
PROJECT NUMBER:	NH SURF(50)
FILE NAME:	layout47.dgn
PROJECT LEADER:	M. FOWLER
DESIGNED BY:	B. KIPP
PLAN SHEET	47
PLOT DATE:	1/14/2016
DRAWN BY:	N. PAPPAS
CHECKED BY:	M. FOWLER
SHEET	61 OF 105