

SPECIAL PROVISION(DURABLE 4 INCH WHITE LINE, POLYUREA)(28 MILS)
 W 330+00 TO W 331+96 RT
 W 332+19 TO W 335+50 RT
 W 330+00 TO W 332+62 LT
 W 332+88 TO W 334+59 LT
 W 334+80 TO W 335+50 LT

TEMPORARY 4 INCH WHITE LINE, PAINT
 W 330+00 TO W 331+96 RT
 W 332+19 TO W 335+50 RT
 W 330+00 TO W 332+62 LT
 W 332+88 TO W 334+59 LT
 W 334+80 TO W 335+50 LT

SPECIAL PROVISION(DURABLE 4 INCH YELLOW LINE, POLYUREA)(28 MILS)
 W 330+00 TO W 331+77 RT & LT
 W 332+17 TO W 332+52 RT & LT
 W 332+94 TO W 334+24 RT & LT
 W 334+64 TO W 335+50 RT & LT


TEMPORARY 4 INCH YELLOW LINE, PAINT
 W 330+00 TO W 331+77 RT & LT
 W 332+17 TO W 332+52 RT & LT
 W 332+94 TO W 334+24 RT & LT
 W 334+64 TO W 335+50 RT & LT

SPECIAL PROVISION(DURABLE LETTER OR SYMBOL, POLYUREA)(28 MILS)
 W 332+06 RT "STOP" (TH 8) (4 EA)
 W 332+67 LT "STOP" (TH 7) (4 EA)
 W 334+44 LT "STOP" (VT 7B) (4 EA)

TEMPORARY LETTER OR SYMBOL, PAINT
 W 332+06 RT "STOP" (TH 8) (4 EA)
 W 332+67 LT "STOP" (TH 7) (4 EA)
 W 334+44 LT "STOP" (VT 7B) (4 EA)

SPECIAL PROVISION(DURABLE 24 INCH STOP BAR, POLYUREA)(28 MILS)
 W 331+96 TO W 332+16 RT (TH 8)
 W 332+57 TO W 332+74 LT (TH 7)
 W 334+33 TO W 334+44 LT (VT 7B)

DURABLE 24 INCH STOP BAR, POLYUREA
 W 331+96 TO W 332+16 RT (TH 8)
 W 332+57 TO W 332+74 LT (TH 7)
 W 334+33 TO W 334+44 LT (VT 7B)

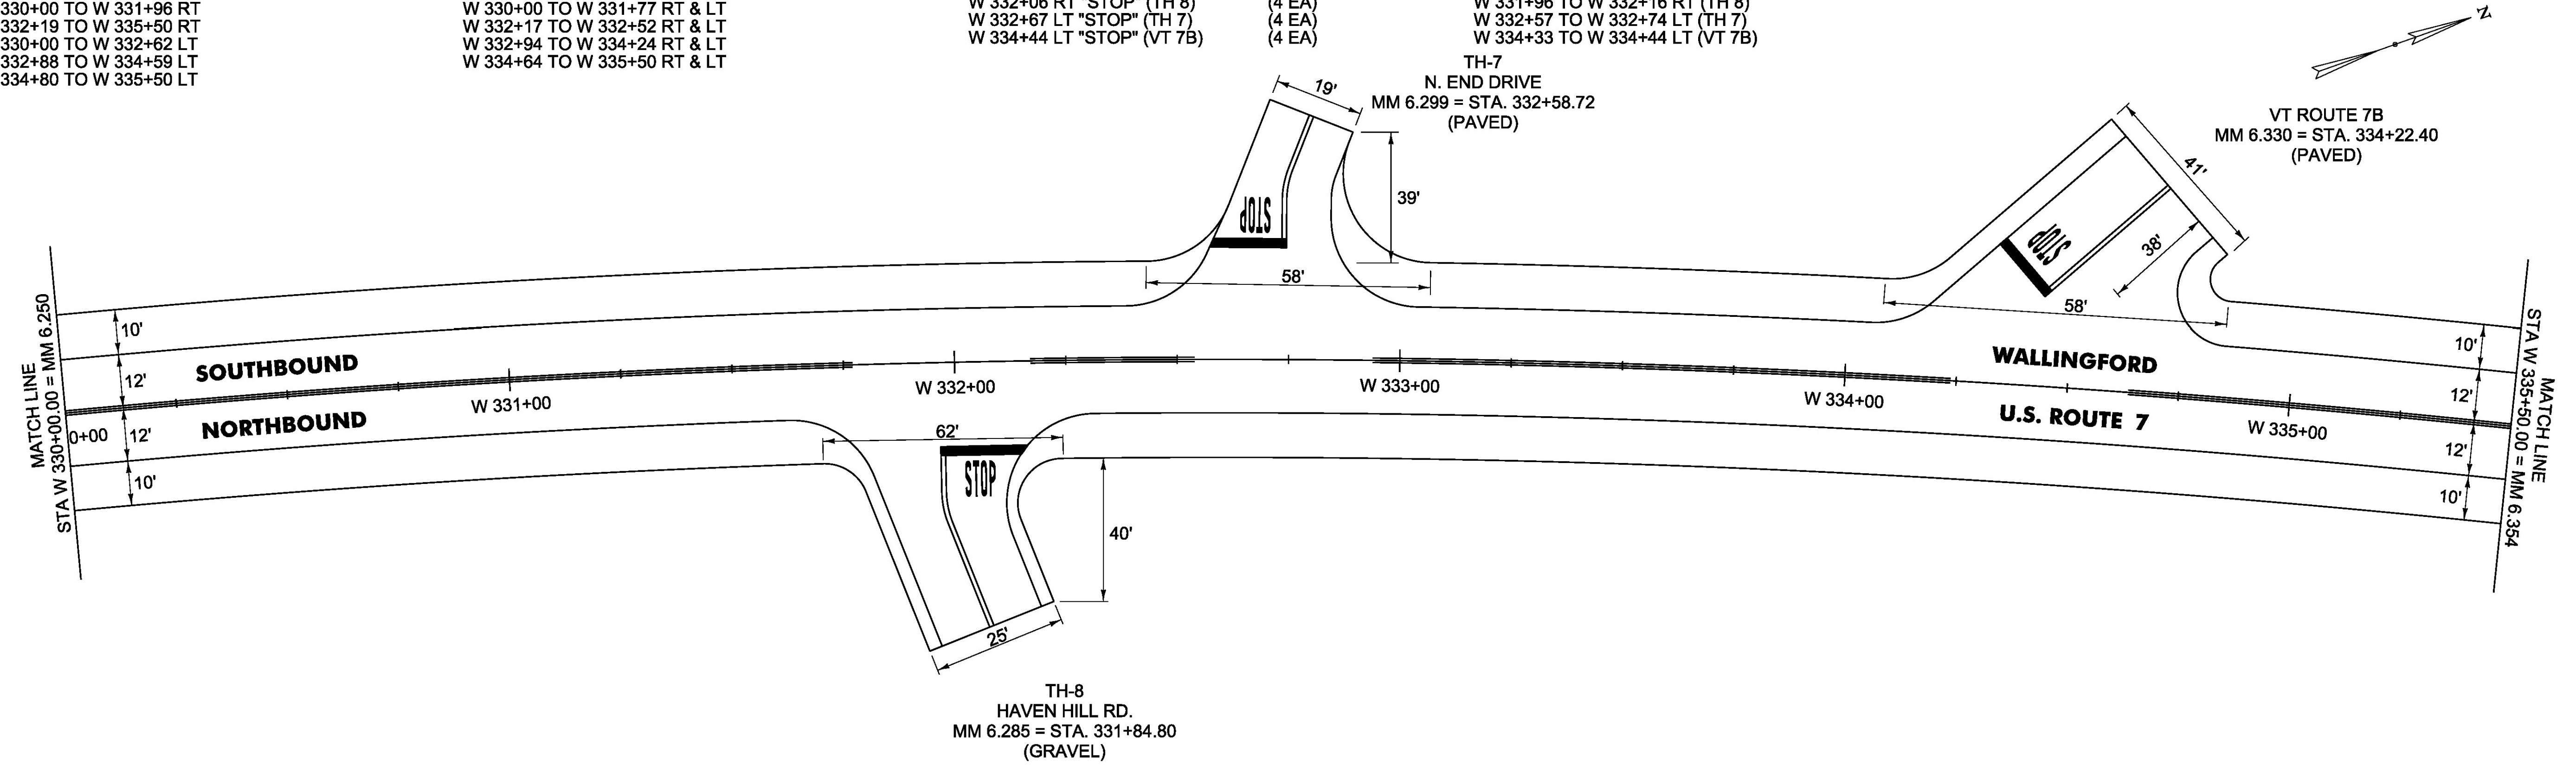

NOT TO SCALE

PROJECT NAME:	MANCHESTER-RUTLAND TOWN
PROJECT NUMBER:	NH SURF(50)
FILE NAME:	layout48.dgn
PROJECT LEADER:	M. FOWLER
DESIGNED BY:	B. KIPP
PLAN SHEET 48	
PLOT DATE:	1/14/2016
DRAWN BY:	N. PAPPAS
CHECKED BY:	M. FOWLER
SHEET 62	OF 105