

SPECIAL PROVISION(DURABLE 4 INCH WHITE LINE, POLYUREA)(28 MILS)

WALLINGFORD:
MM 6.354 TO MM 6.518 RT & LT

TEMPORARY 4 INCH WHITE LINE, PAINT

WALLINGFORD:
MM 6.354 TO MM 6.518 RT & LT

SPECIAL PROVISION(DURABLE LETTER OR SYMBOL, POLYUREA)(28 MILS)

WALLINGFORD:
MM 6.778 RT - MERGE ARROW (SOUTHBOUND)
MM 6.744 RT - MERGE ARROW (SOUTHBOUND)

TEMPORARY LETTER OR SYMBOL, PAINT

WALLINGFORD:
MM 6.778 RT - MERGE ARROW (SOUTHBOUND) (1 EA)
MM 6.744 RT - MERGE ARROW (SOUTHBOUND) (1 EA)

SPECIAL PROVISION(DURABLE 6 INCH WHITE LINE, POLYUREA)(28 MILS)

WALLINGFORD:
MM 6.518 TO MM 6.790 RT & LT
MM 6.705 TO MM 6.790 RT DASHED (NORTHBOUND)

TEMPORARY 6 INCH WHITE LINE, PAINT

WALLINGFORD:
MM 6.518 TO MM 6.790 RT & LT
MM 6.705 TO MM 6.790 RT DASHED (NORTHBOUND)

SPECIAL PROVISION(DURABLE 4 INCH YELLOW LINE, POLYUREA)(28 MILS)

WALLINGFORD:
MM 6.354 TO MM 6.465 SOLID RT & LT
MM 6.465 TO MM 6.518 DOUBLE SOLID RT & LT

TEMPORARY 4 INCH YELLOW LINE, PAINT

WALLINGFORD:
MM 6.354 TO MM 6.465 SOLID RT & LT
MM 6.465 TO MM 6.518 DOUBLE SOLID RT & LT

SPECIAL PROVISION(DURABLE 6 INCH YELLOW LINE, POLYUREA)(28 MILS)

WALLINGFORD:
MM 6.518 TO MM 6.790 SOLID RT & LT

TEMPORARY 6 INCH YELLOW LINE, PAINT


WALLINGFORD:
MM 6.518 TO MM 6.790 SOLID RT & LT

SPECIAL PROVISION(DURABLE 8 INCH YELLOW LINE, POLYUREA)(28 MILS)

WALLINGFORD:
MM 6.465 TO MM 6.518 HATCHED MEDIAN

MILLED RUMBLE STRIPS (SHOULDER)

WALLINGFORD:
MM 6.518 TO MM 6.790 RT (NORTHBOUND)
MM 6.518 TO MM 6.790 LT (SOUTHBOUND)

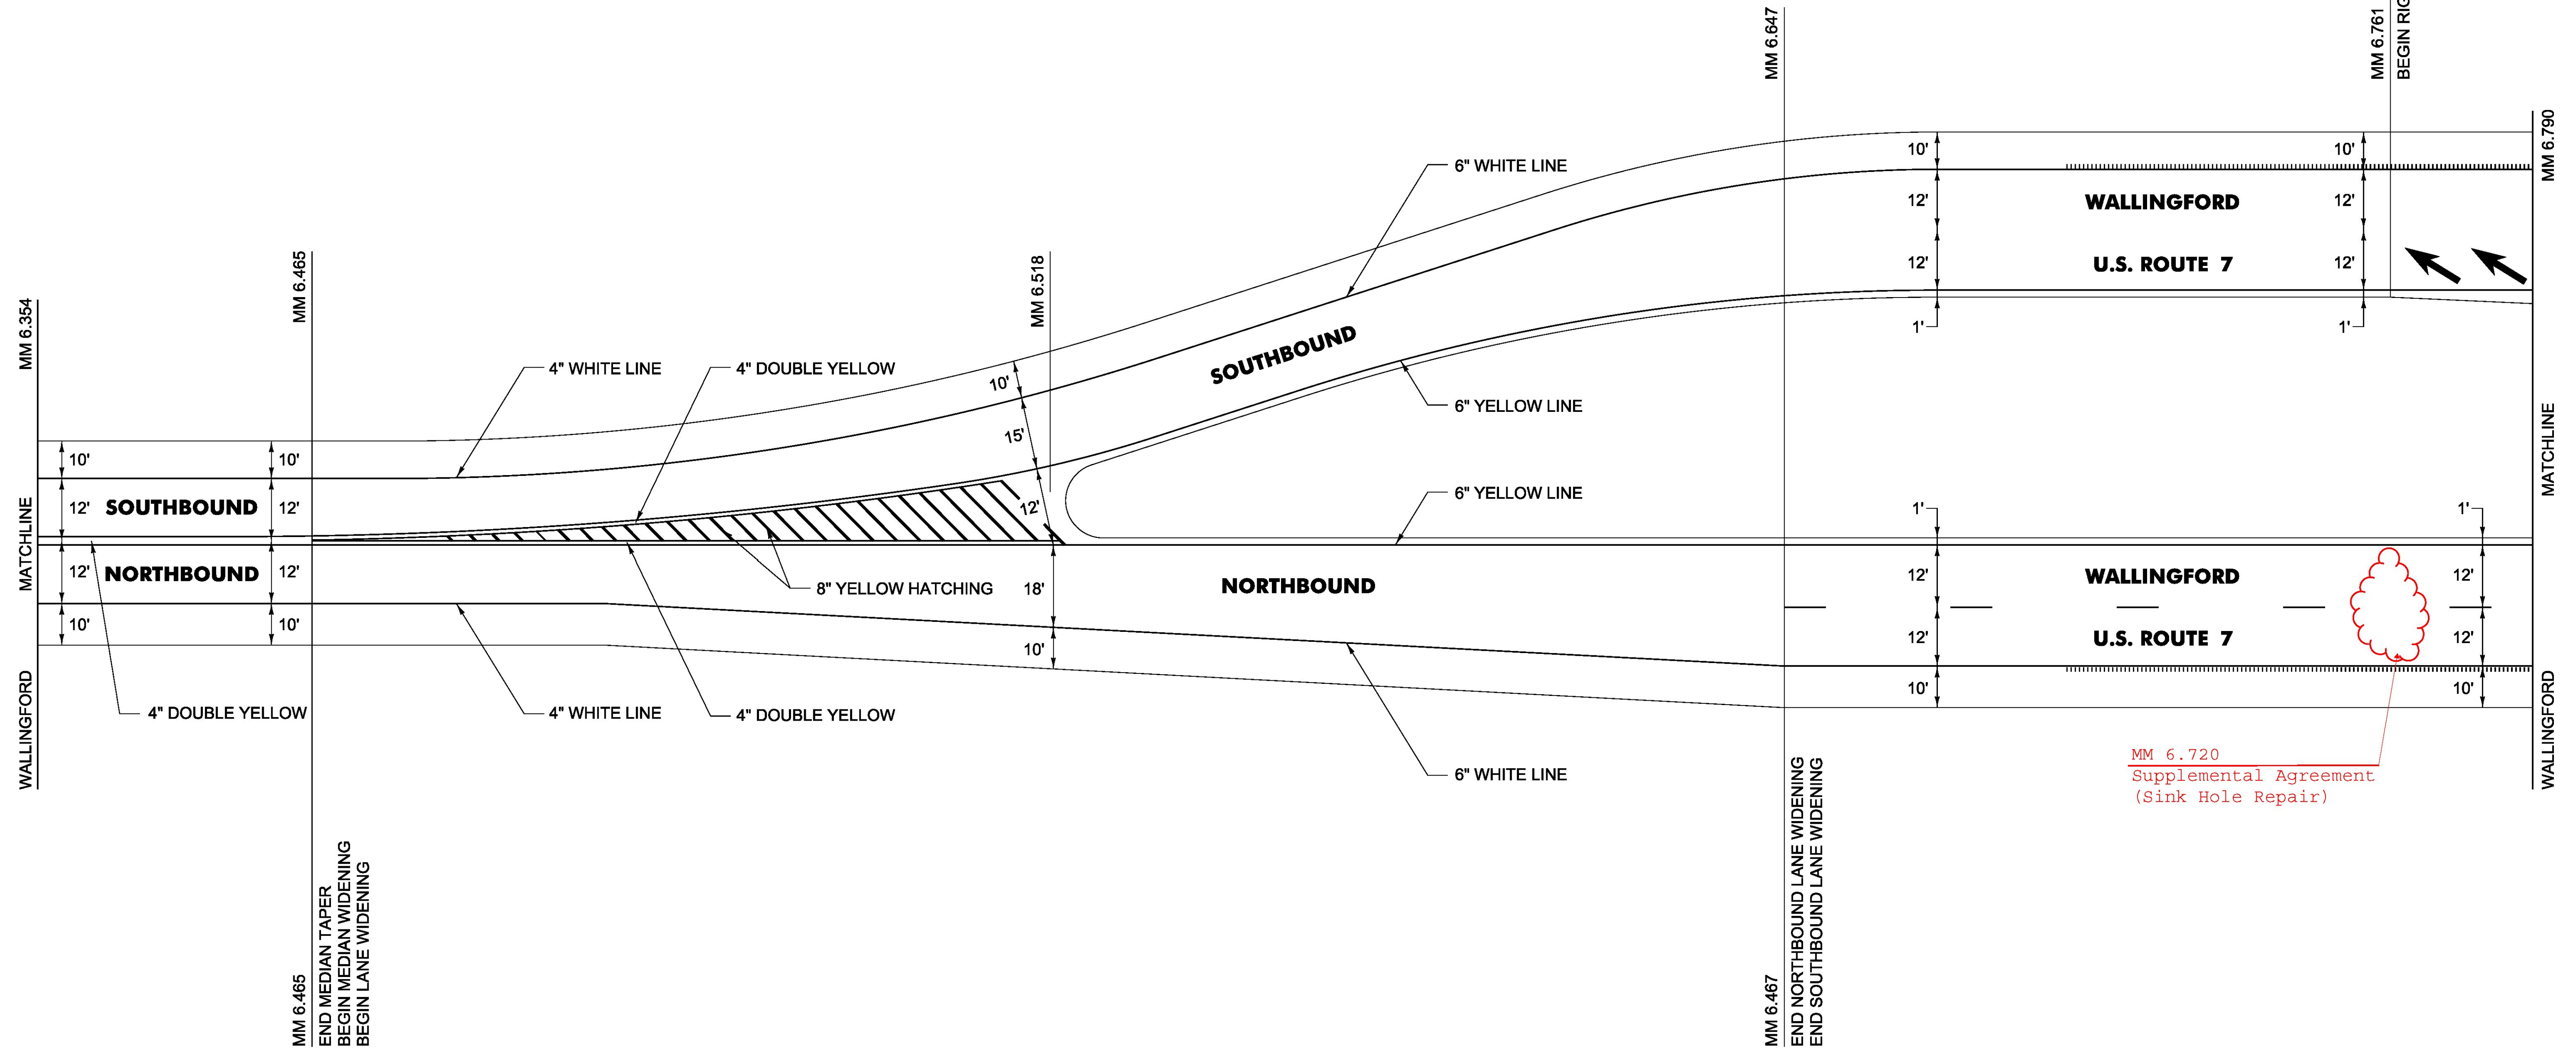

NOT TO SCALE

PROJECT NAME:	MANCHESTER-RUTLAND TOWN
PROJECT NUMBER:	NH SURF(50)
FILE NAME:	layout49.dgn
PROJECT LEADER:	M. FOWLER
DESIGNED BY:	B. KIPP
PLAN SHEET	49
PLOT DATE:	1/14/2016
DRAWN BY:	N. PAPPAS
CHECKED BY:	M. FOWLER
SHEET	63 OF 105