

SPECIAL PROVISION(DURABLE 6 INCH WHITE LINE, POLYUREA)(28 MILS)

WALLINGFORD:
MM 6.790 TO MM 7.110 SOLID LT (SOUTHBOUND)
MM 6.790 TO MM 7.110 SOLID RT (NORTHBOUND)
MM 6.790 TO MM 7.110 DASHED CL (NORTHBOUND)
MM 6.812 TO MM 7.110 DASHED CL (SOUTHBOUND)

CLARENDON:
MM 0.000 TO MM 0.248 SOLID LT (SOUTHBOUND)
MM 0.000 TO MM 0.248 SOLID RT (NORTHBOUND)
MM 0.000 TO MM 0.248 DASHED CL (SOUTHBOUND)
MM 0.000 TO MM 0.248 DASHED CL (NORTHBOUND)

TEMPORARY 6 INCH WHITE LINE, PAINT

WALLINGFORD:
MM 6.790 TO MM 7.110 SOLID LT (SOUTHBOUND)
MM 6.790 TO MM 7.110 SOLID RT (NORTHBOUND)
MM 6.790 TO MM 7.100 DASHED CL (NORTHBOUND)
MM 6.812 TO MM 7.100 DASHED CL (SOUTHBOUND)

CLARENDON:
MM 0.000 TO MM 0.248 SOLID LT (SOUTHBOUND)
MM 0.000 TO MM 0.248 SOLID RT (NORTHBOUND)
MM 0.000 TO MM 0.248 DASHED CL (SOUTHBOUND)
MM 0.000 TO MM 0.248 DASHED CL (NORTHBOUND)

SPECIAL PROVISION(DURABLE 6 INCH YELLOW LINE, POLYUREA)(28 MILS)

WALLINGFORD:
MM 6.790 TO MM 7.110 SOLID RT (SOUTHBOUND)
MM 6.790 TO MM 7.110 SOLID LT (NORTHBOUND)

CLARENDON:
MM 0.000 TO MM 0.248 SOLID RT (SOUTHBOUND)
MM 0.000 TO MM 0.248 SOLID LT (NORTHBOUND)

TEMPORARY 6 INCH YELLOW LINE, PAINT

WALLINGFORD:
MM 6.790 TO MM 7.110 SOLID RT (SOUTHBOUND)
MM 6.790 TO MM 7.110 SOLID LT (NORTHBOUND)

CLARENDON:
MM 0.000 TO MM 0.248 SOLID RT (SOUTHBOUND)
MM 0.000 TO MM 0.248 SOLID LT (NORTHBOUND)

SPECIAL PROVISION(DURABLE LETTER OR SYMBOL, POLYUREA)(28 MILS)

WALLINGFORD:
MM 6.812 RT - MERGE ARROW (SOUTHBOUND) (1 EA)


TEMPORARY LETTER OR SYMBOL, PAINT

WALLINGFORD:
MM 6.812 RT - MERGE ARROW (SOUTHBOUND) (1 EA)

MILLED RUMBLE STRIPS (SHOULDER)

WALLINGFORD:
MM 6.790 TO MM 7.110 RT (NORTHBOUND)
MM 6.790 TO MM 7.110 LT (SOUTHBOUND)
MM 6.800 TO MM 7.110 RT (SOUTHBOUND)
MM 6.851 TO MM 7.110 LT (NORTHBOUND)

CLARENDON:
MM 0.000 TO MM 0.248 RT (NORTHBOUND)
MM 0.000 TO MM 0.122 LT (NORTHBOUND)
MM 0.000 TO MM 0.184 RT (SOUTHBOUND)
MM 0.000 TO MM 0.248 LT (SOUTHBOUND)

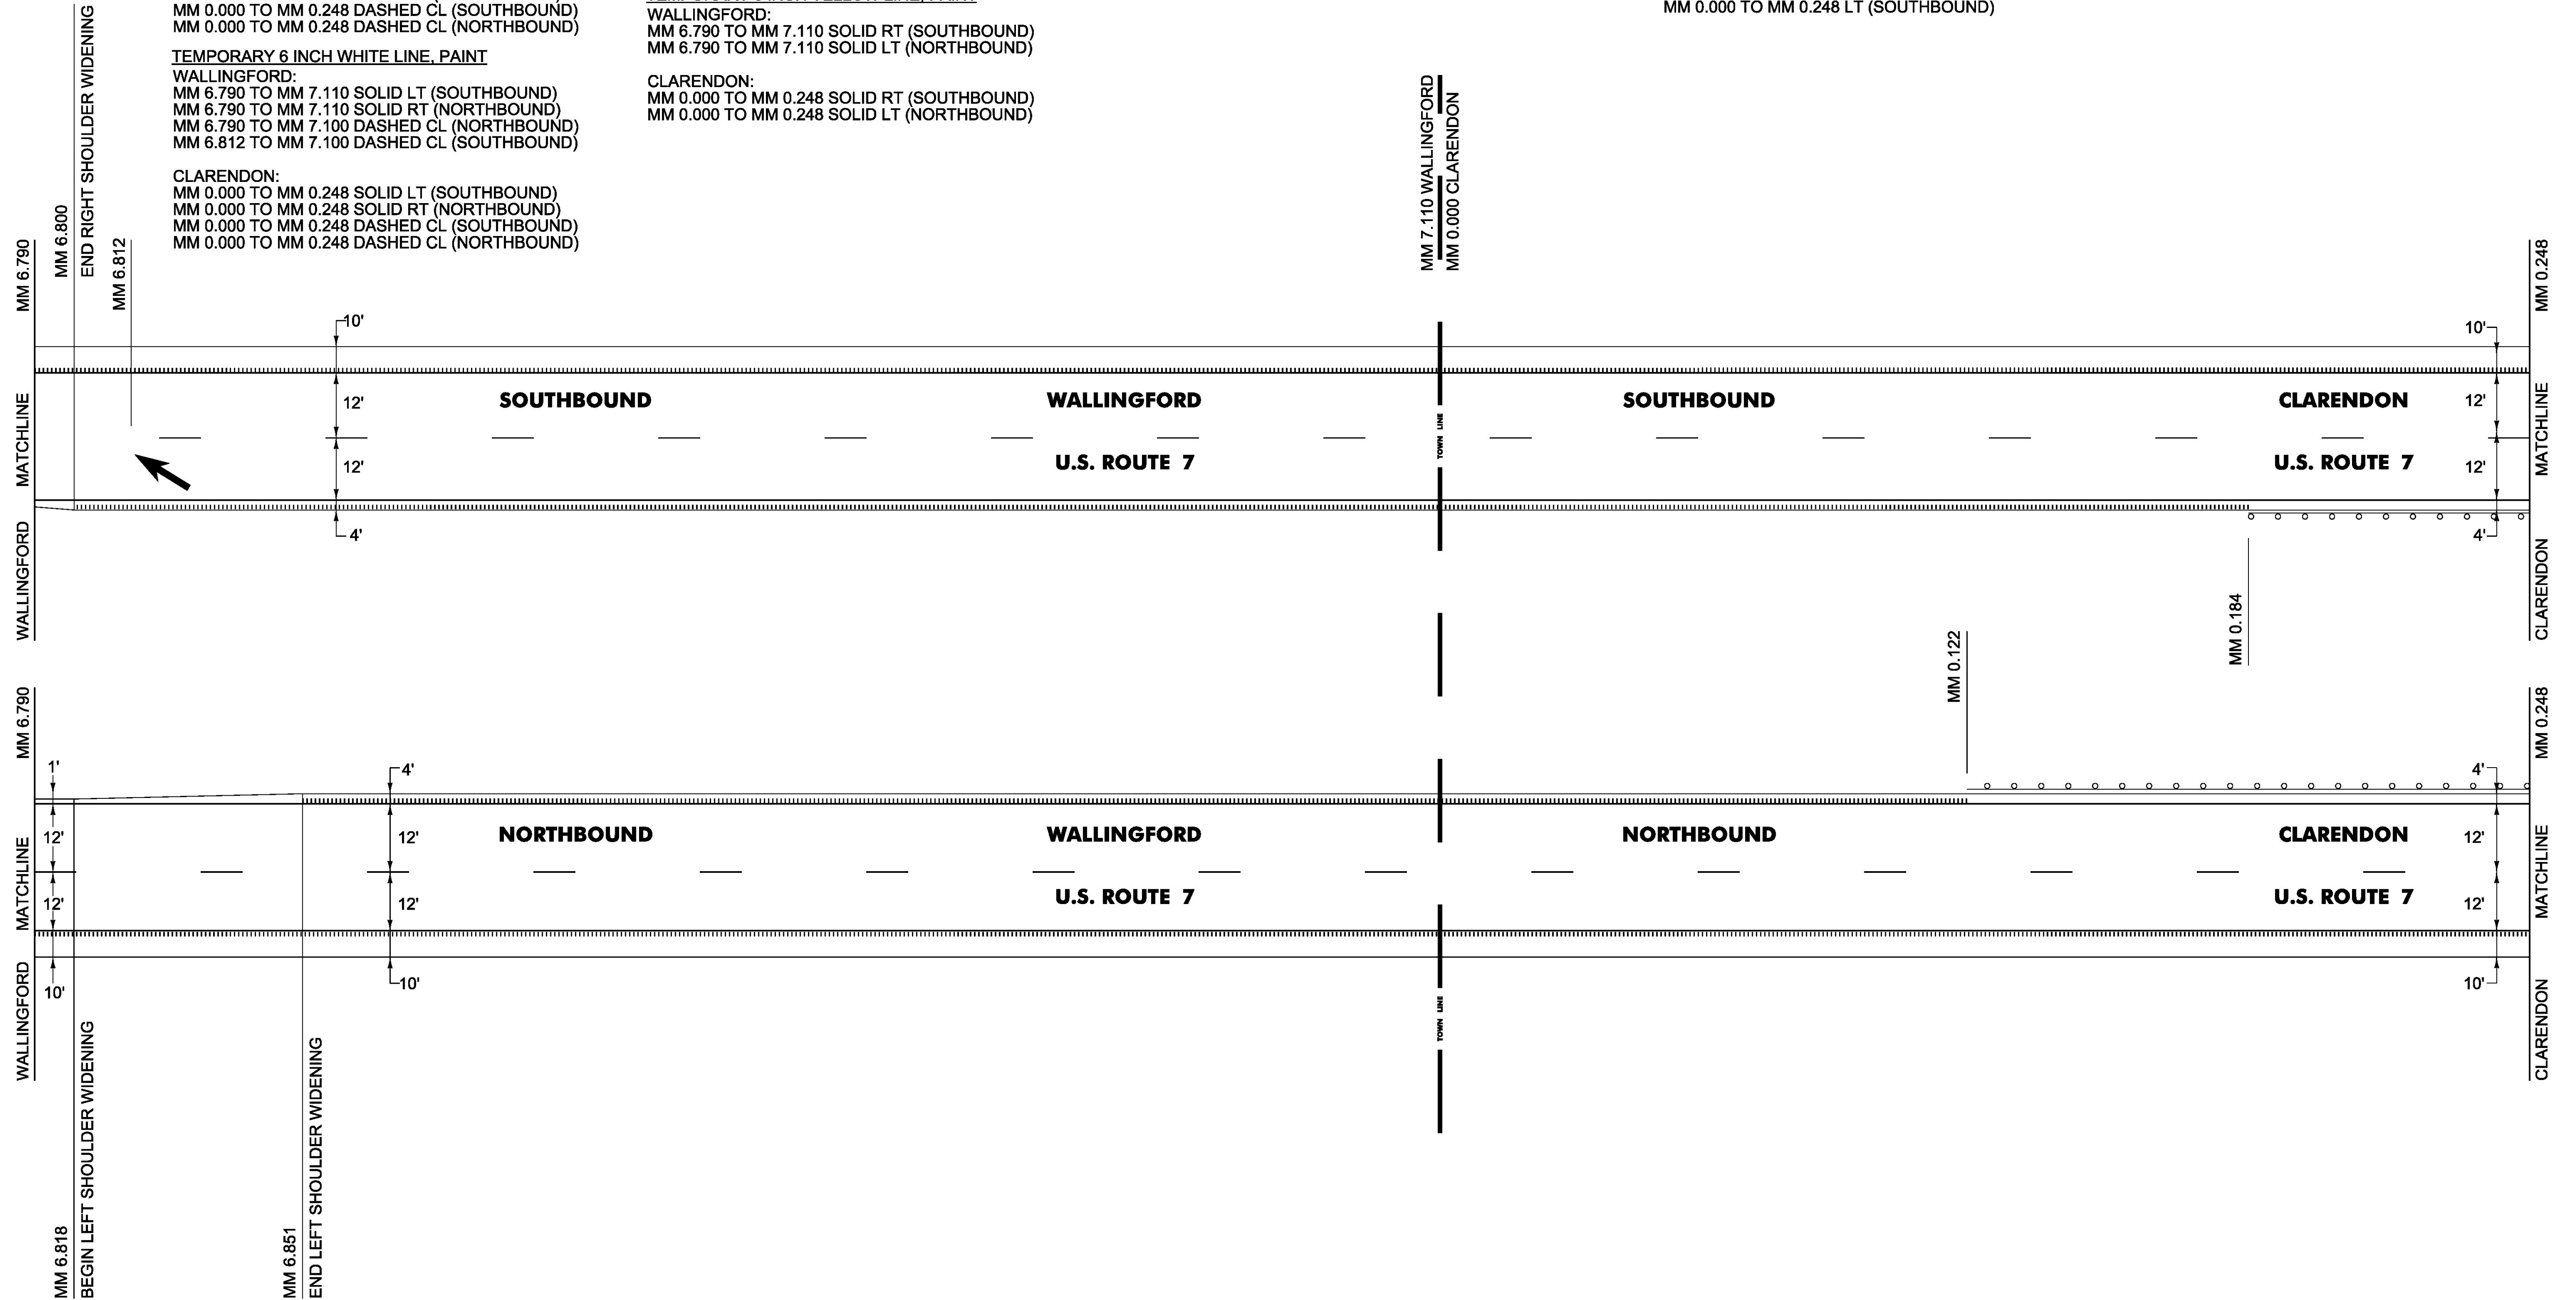

NOT TO SCALE

PROJECT NAME:	MANCHESTER-RUTLAND TOWN
PROJECT NUMBER:	NH SURF(50)
FILE NAME:	layout50.dgn
PROJECT LEADER:	M. FOWLER
DESIGNED BY:	B. KIPP
PLAN SHEET	50
PLOT DATE:	1/14/2016
DRAWN BY:	N. PAPPAS
CHECKED BY:	M. FOWLER
SHEET	64 OF 105