

SPECIAL PROVISION(DURABLE 4 INCH WHITE LINE, POLYUREA)(28 MILS)
 RUTLAND TOWN:
 MM 0.844 EDGE LINES RT (SEWARD ROAD)
 MM 0.844 EDGE LINES LT (SHOPPING CENTER)
 MM 0.844 LANE LINE LT (SHOPPING CENTER)

SPECIAL PROVISION(DURABLE 4 INCH YELLOW LINE, POLYUREA)(28 MILS)
 RUTLAND TOWN:
 MM 0.844 RT DOUBLE YELLOW (SEWARD ROAD)
 MM 0.844 LT MEDIAN & GORE AREA (SHOPPING CENTER)

SPECIAL PROVISION(DURABLE 6 INCH WHITE LINE, POLYUREA)(28 MILS)
 RUTLAND TOWN (NORTHBOUND):
 MM 0.765 - MM 0.832 DASHED CL
 MM 0.765 - MM 0.832 SOLID RT
 MM 0.766 - MM 0.792 DOTTED LANE LINE LT
 MM 0.792 - MM 0.832 SOLID LANE LINE LT
 MM 0.855 - MM 0.880 DASHED CL
 MM 0.855 - MM 0.880 SOLID RT

RUTLAND TOWN (SOUTHBOUND):
 MM 0.765 - MM 0.832 DASHED CL
 MM 0.765 - MM 0.832 SOLID LT
 MM 0.855 - MM 0.880 DASHED CL
 MM 0.855 - MM 0.880 SOLID LT
 MM 0.855 - MM 0.880 SOLID LANE LINE LT
 MM 0.855 - MM 0.872 SOLID LANE LINE RT

SPECIAL PROVISION(DURABLE 6 INCH YELLOW LINE, POLYUREA)(28 MILS)
 RUTLAND TOWN (NORTHBOUND):
 MM 0.587 - MM 0.792 DOUBLE SOLID RT
 MM 0.792 - MM 0.832 SOLID RT
 MM 0.855 - MM 0.880 SOLID RT

RUTLAND TOWN (SOUTHBOUND):
 MM 0.587 - MM 0.792 DOUBLE SOLID LT
 MM 0.792 - MM 0.832 SOLID LT
 MM 0.855 - MM 0.880 SOLID LT

TEMPORARY 4 INCH WHITE LINE, PAINT
 RUTLAND TOWN:
 MM 0.844 EDGE LINES RT (SEWARD ROAD)
 MM 0.844 EDGE LINES LT (SHOPPING CENTER)
 MM 0.844 LANE LINE LT (SHOPPING CENTER)

TEMPORARY 4 INCH YELLOW LINE, PAINT
 RUTLAND TOWN:
 MM 0.844 RT DOUBLE YELLOW (SEWARD ROAD)
 MM 0.844 LT MEDIAN & GORE AREA (SHOPPING CENTER)

TEMPORARY 6 INCH WHITE LINE, PAINT
 RUTLAND TOWN (NORTHBOUND):
 MM 0.765 - MM 0.832 DASHED CL
 MM 0.765 - MM 0.832 SOLID RT
 MM 0.766 - MM 0.792 DOTTED LANE LINE LT
 MM 0.792 - MM 0.832 SOLID LANE LINE LT
 MM 0.855 - MM 0.880 DASHED CL
 MM 0.855 - MM 0.880 SOLID RT

RUTLAND TOWN (SOUTHBOUND):
 MM 0.765 - MM 0.832 DASHED CL
 MM 0.765 - MM 0.832 SOLID LT
 MM 0.855 - MM 0.880 DASHED CL
 MM 0.855 - MM 0.880 SOLID LT
 MM 0.855 - MM 0.880 SOLID LANE LINE LT
 MM 0.855 - MM 0.872 SOLID LANE LINE RT

TEMPORARY 6 INCH YELLOW LINE, PAINT
 RUTLAND TOWN (NORTHBOUND):
 MM 0.587 - MM 0.792 DOUBLE SOLID RT
 MM 0.792 - MM 0.832 SOLID RT
 MM 0.855 - MM 0.880 SOLID RT

RUTLAND TOWN (SOUTHBOUND):
 MM 0.587 - MM 0.792 DOUBLE SOLID LT
 MM 0.792 - MM 0.832 SOLID LT
 MM 0.855 - MM 0.880 SOLID LT

SPECIAL PROVISION(DURABLE 8 INCH YELLOW LINE, POLYUREA)(28 MILS)
 RUTLAND TOWN:
 MM 0.765 - MM 0.792 GORE AREA

SPECIAL PROVISION(DURABLE CROSSWALK MARKING, POLYUREA)(28 MILS)
 RUTLAND TOWN:
 MM 0.832
 MM 0.844 LT (SHOPPING CENTER)
 MM 0.844 RT (SEWARD ROAD)

TEMPORARY 8 INCH YELLOW LINE, PAINT
 RUTLAND TOWN:
 MM 0.765 - MM 0.792 GORE AREA

TEMPORARY CROSSWALK MARKING, PAINT
 RUTLAND TOWN:
 MM 0.832
 MM 0.844 LT (SHOPPING CENTER)
 MM 0.844 RT (SEWARD ROAD)

SPECIAL PROVISION(DURABLE LETTER OR SYMBOL, POLYUREA)(28 MILS)
 RUTLAND TOWN (NORTHBOUND):
 MM 0.793 LT, ARROW (1 EA)
 MM 0.793 RT, DOUBLE ARROW (2 EA)
 MM 0.804 LT, "O,N,L,Y" (4 EA)
 MM 0.815 LT, ARROW (1 EA)
 MM 0.815 LT, DOUBLE ARROW (2 EA)

RUTLAND TOWN (SOUTHBOUND):
 MM 0.857 RT, ARROW (1 EA)
 MM 0.857 LT, ARROW (1 EA)
 MM 0.866 LT, "O,N,L,Y" (4 EA)
 MM 0.871 RT, "O,N,L,Y" (4 EA)
 MM 0.875 LT, ARROW (1 EA)

SHOPPING CENTER:
 MM 0.844 LT, ARROW (1 EA)
 MM 0.844 LT, DOUBLE ARROW (2 EA)
 MM 0.844 LT, "O,N,L,Y" (4 EA)

SPECIAL PROVISION(DURABLE 24 INCH STOP BAR, POLYUREA)(28 MILS)
 RUTLAND TOWN (NORTHBOUND):
 MM 0.832
 MM 0.844 (SEWARD ROAD)

RUTLAND TOWN (SOUTHBOUND):
 MM 0.844 (SHOPPING CENTER)
 MM 0.855


TEMPORARY LETTER OR SYMBOL, PAINT
 RUTLAND TOWN (NORTHBOUND):
 MM 0.793 LT, ARROW (1 EA)
 MM 0.793 RT, DOUBLE ARROW (2 EA)
 MM 0.804 LT, "O,N,L,Y" (4 EA)
 MM 0.815 LT, ARROW (1 EA)
 MM 0.815 LT, DOUBLE ARROW (2 EA)

RUTLAND TOWN (SOUTHBOUND):
 MM 0.857 RT, ARROW (1 EA)
 MM 0.857 LT, ARROW (1 EA)
 MM 0.866 LT, "O,N,L,Y" (4 EA)
 MM 0.871 RT, "O,N,L,Y" (4 EA)
 MM 0.875 LT, ARROW (1 EA)

SHOPPING CENTER:
 MM 0.844 LT, ARROW (1 EA)
 MM 0.844 LT, DOUBLE ARROW (2 EA)
 MM 0.844 LT, "O,N,L,Y" (4 EA)

TEMPORARY 24 INCH STOP BAR, PAINT
 RUTLAND TOWN (NORTHBOUND):
 MM 0.832
 MM 0.844 (SEWARD ROAD)

RUTLAND TOWN (SOUTHBOUND):
 MM 0.844 (SHOPPING CENTER)
 MM 0.855

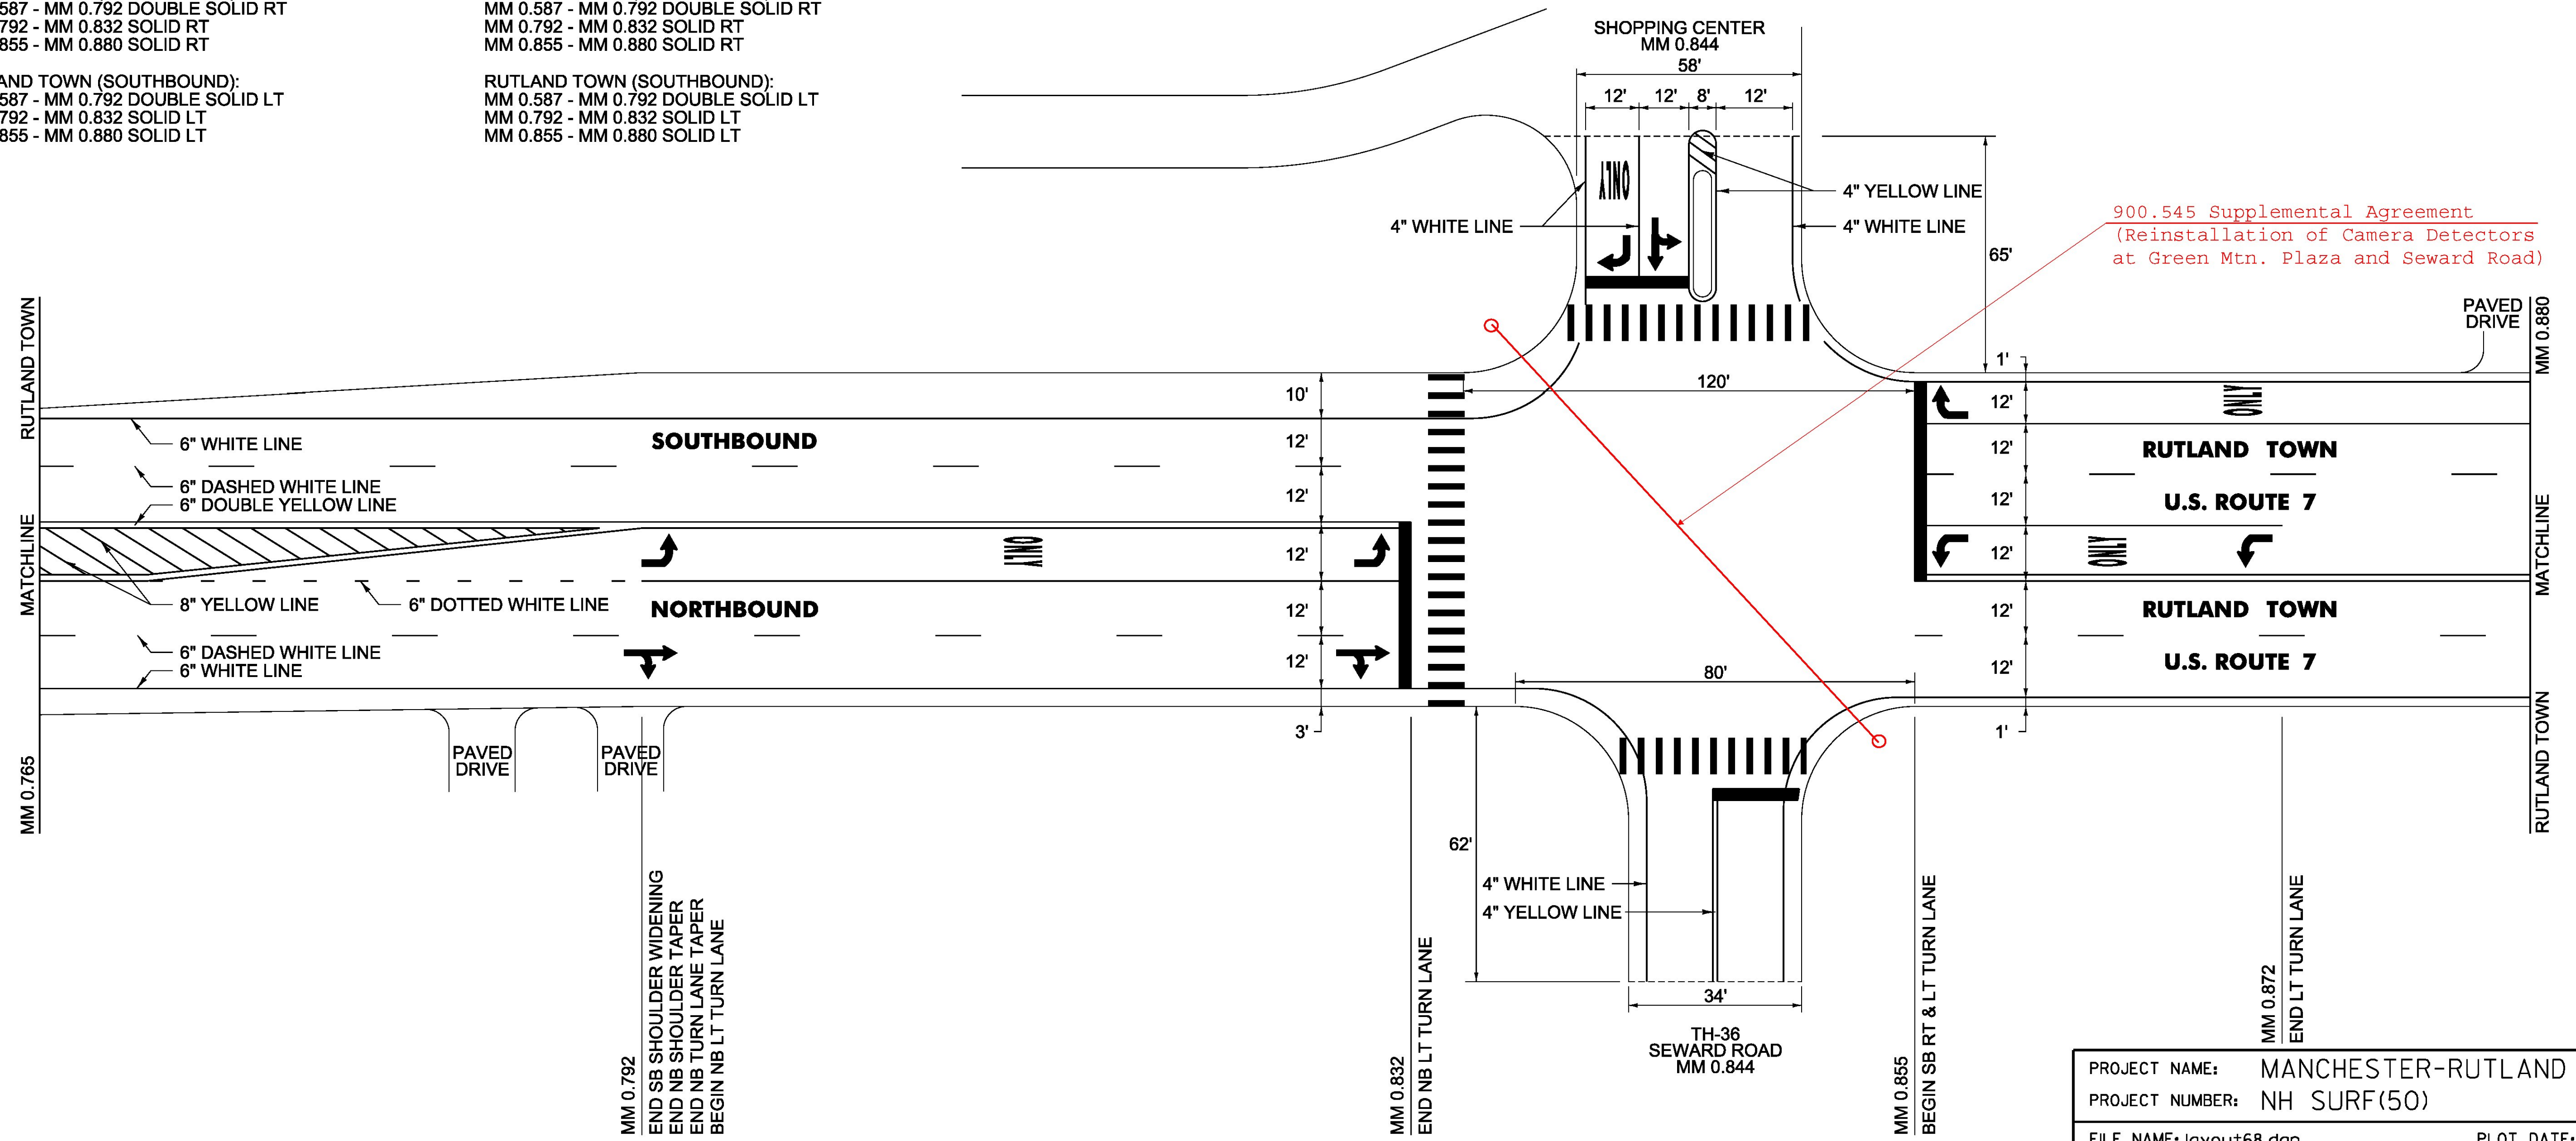

900.545 Supplemental Agreement
 (Reinstallation of Camera Detectors
 at Green Mtn. Plaza and Seward Road)

PROJECT NAME:	MANCHESTER-RUTLAND TOWN
PROJECT NUMBER:	NH SURF(50)
FILE NAME:	layout+68.dgn
DESIGNED BY:	B. KIPP
PROJECT LEADER:	M. FOWLER
CHECKED BY:	M. FOWLER
PLAN SHEET 68	SHEET 82 OF 105
PLOT DATE:	1/14/2016
DRAWN BY:	B. KIPP