

SPECIAL PROVISION(DURABLE 4 INCH WHITE LINE, POLYUREA)(28 MILS)
 RUTLAND TOWN:
 MM 1.137 EDGE LINES LT (DRIVE)
 MM 1.137 EDGE LINES RT (COLD RIVER ROAD)
 MM 1.137 LANE LINE RT (COLD RIVER ROAD)

TEMPORARY 4 INCH WHITE LINE, PAINT
 RUTLAND TOWN:
 MM 1.137 EDGE LINES LT (DRIVE)
 MM 1.137 EDGE LINES RT (COLD RIVER ROAD)
 MM 1.137 LANE LINE RT (COLD RIVER ROAD)

SPECIAL PROVISION(DURABLE LETTER OR SYMBOL, POLYUREA)(28 MILS)
 RUTLAND TOWN:
 MM 1.083 CL, ARROW (2 EA)
 MM 1.100 CL, ARROW (2 EA)
 MM 1.117 CL, ARROW (1 EA)
 MM 1.117 RT, DOUBLE ARROW (2 EA)
 MM 1.125 CL, ARROW (1 EA)
 MM 1.125 RT, DOUBLE ARROW (2 EA)
 MM 1.144 CL, ARROW (1 EA)
 MM 1.144 LT, DOUBLE ARROW (2 EA)
 MM 1.153 CL, "O,N,L,Y" (4 EA)
 MM 1.155 CL, ARROW (1 EA)
 MM 1.155 LT, DOUBLE ARROW (2 EA)

TEMPORARY LETTER OR SYMBOL, PAINT
 RUTLAND TOWN:
 MM 1.083 CL, ARROW (2 EA)
 MM 1.100 CL, ARROW (2 EA)
 MM 1.117 CL, ARROW (1 EA)
 MM 1.117 RT, DOUBLE ARROW (2 EA)
 MM 1.125 CL, ARROW (1 EA)
 MM 1.125 RT, DOUBLE ARROW (2 EA)
 MM 1.144 CL, ARROW (1 EA)
 MM 1.144 LT, DOUBLE ARROW (2 EA)
 MM 1.153 CL, "O,N,L,Y" (4 EA)
 MM 1.155 CL, ARROW (1 EA)
 MM 1.155 LT, DOUBLE ARROW (2 EA)

SPECIAL PROVISION(DURABLE CROSSWALK MARKING, POLYUREA)(28 MILS)
 RUTLAND TOWN:
 MM 1.137 RT (COLD RIVER ROAD)
 MM 1.137 LT (DRIVE)

TEMPORARY CROSSWALK MARKING, PAINT
 RUTLAND TOWN:
 MM 1.137 RT (COLD RIVER ROAD)
 MM 1.137 LT (DRIVE)

SPECIAL PROVISION(DURABLE 4 INCH YELLOW LINE, POLYUREA)(28 MILS)
 RUTLAND TOWN:
 MM 1.137 DOUBLE YELLOW LT (DRIVE)
 MM 1.137 DOUBLE YELLOW RT (COLD RIVER ROAD)

TEMPORARY 4 INCH YELLOW LINE, PAINT
 RUTLAND TOWN:
 MM 1.137 DOUBLE YELLOW LT (DRIVE)
 MM 1.137 DOUBLE YELLOW RT (COLD RIVER ROAD)

SPECIAL PROVISION(DURABLE 6 INCH WHITE LINE, POLYUREA)(28 MILS)
 RUTLAND TOWN:
 MM 1.060 - MM 1.130 DASHED CL RT
 MM 1.060 - MM 1.130 SOLID RT
 MM 1.060 - MM 1.130 DASHED CL LT
 MM 1.060 - MM 1.130 SOLID LT
 MM 1.116 - MM 1.130 SOLID LANE LINE RT
 MM 1.143 - MM 1.177 DASHED CL RT
 MM 1.143 - MM 1.177 SOLID RT
 MM 1.143 - MM 1.177 DASHED CL LT
 MM 1.143 - MM 1.177 SOLID LT
 MM 1.143 - MM 1.162 SOLID LANE LINE LT

TEMPORARY 6 INCH WHITE LINE, PAINT
 RUTLAND TOWN:
 MM 1.060 - MM 1.130 DASHED CL RT
 MM 1.060 - MM 1.130 SOLID RT
 MM 1.060 - MM 1.130 DASHED CL LT
 MM 1.060 - MM 1.130 SOLID LT
 MM 1.116 - MM 1.130 SOLID LANE LINE RT
 MM 1.143 - MM 1.177 DASHED CL RT
 MM 1.143 - MM 1.177 SOLID RT
 MM 1.143 - MM 1.177 DASHED CL LT
 MM 1.143 - MM 1.177 SOLID LT
 MM 1.143 - MM 1.162 SOLID LANE LINE LT

COLD RIVER ROAD:
 MM 1.137 RT, ARROW (1 EA)
 MM 1.137 RT, DOUBLE ARROW (2 EA)
 MM 1.137 RT, "O,N,L,Y" (4 EA)


COLD RIVER ROAD:
 MM 1.137 RT, ARROW (1 EA)
 MM 1.137 RT, DOUBLE ARROW (2 EA)
 MM 1.137 RT, "O,N,L,Y" (4 EA)

SPECIAL PROVISION(DURABLE 24 INCH STOP BAR, POLYUREA)(28 MILS)
 RANDBURY ROAD:
 MM 1.130 RT
 MM 1.137 RT (COLD RIVER ROAD)
 MM 1.137 LT (DRIVE)
 MM 1.143 LT

TEMPORARY 24 INCH STOP BAR, PAINT
 RANDBURY ROAD:
 MM 1.130 RT
 MM 1.137 RT (COLD RIVER ROAD)
 MM 1.137 LT (DRIVE)
 MM 1.143 LT

SPECIAL PROVISION(DURABLE 6 INCH WHITE LINE, POLYUREA)(28 MILS)
 RUTLAND TOWN:
 MM 1.060 - MM 1.100 DASHED RT
 MM 1.060 - MM 1.100 SOLID RT
 MM 1.060 - MM 1.100 DASHED LT
 MM 1.060 - MM 1.100 SOLID LT
 MM 1.100 - MM 1.130 DOUBLE YELLOW LT
 MM 1.143 - MM 1.177 DOUBLE YELLOW RT

TEMPORARY 6 INCH WHITE LINE, PAINT
 RUTLAND TOWN:
 MM 1.060 - MM 1.100 DASHED RT
 MM 1.060 - MM 1.100 SOLID RT
 MM 1.060 - MM 1.100 DASHED LT
 MM 1.060 - MM 1.100 SOLID LT
 MM 1.100 - MM 1.130 DOUBLE YELLOW LT
 MM 1.143 - MM 1.177 DOUBLE YELLOW RT

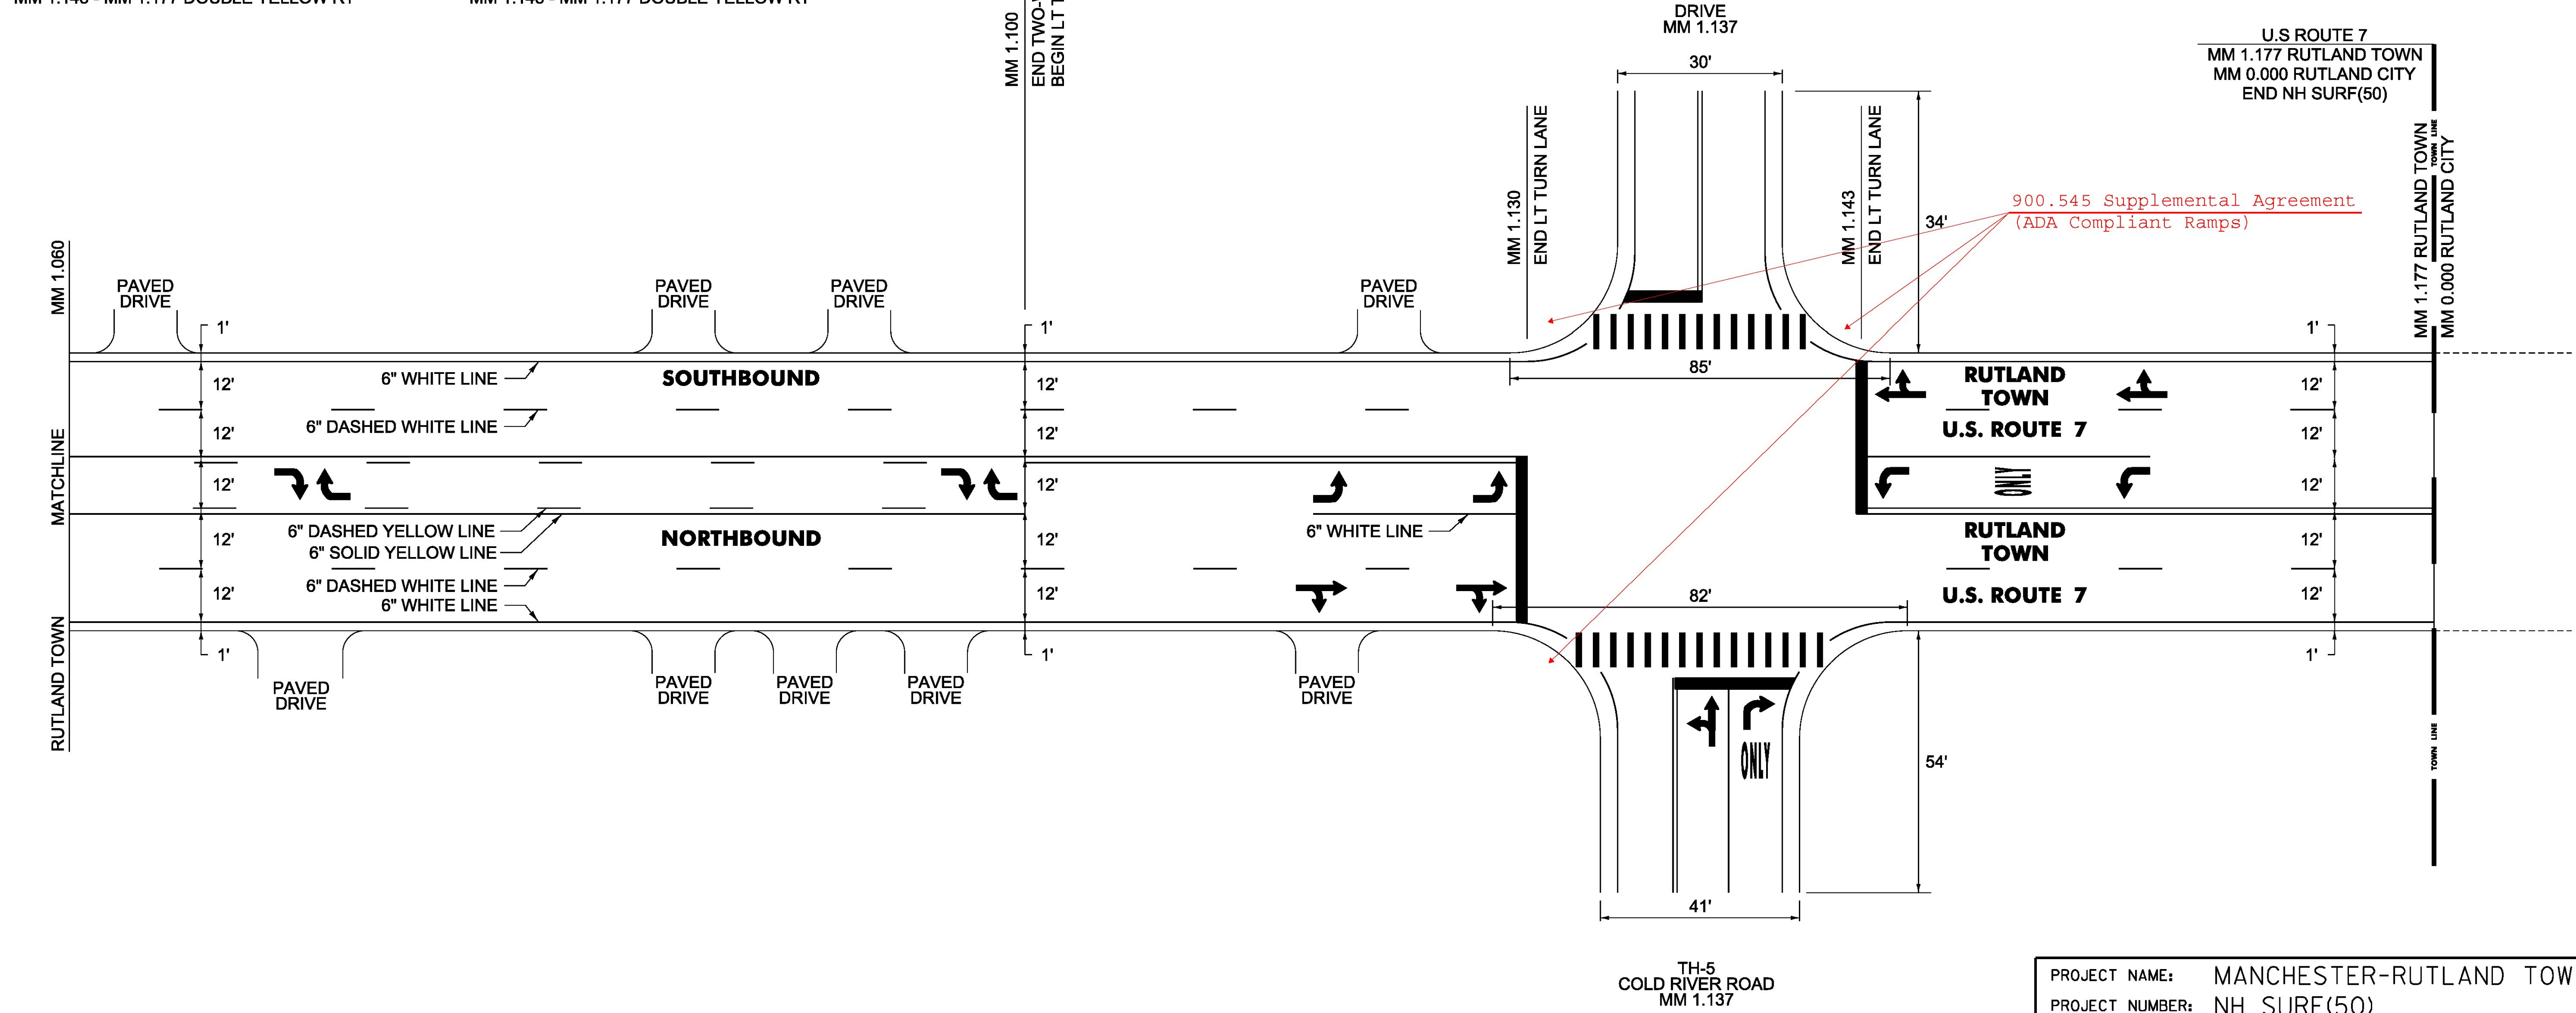

PROJECT NAME:	MANCHESTER-RUTLAND TOWN
PROJECT NUMBER:	NH SURF(50)
FILE NAME:	layout70.dgn
PROJECT LEADER:	M. FOWLER
DESIGNED BY:	B. KIPP
PLAN SHEET	70
PLOT DATE:	1/14/2016
DRAWN BY:	B. KIPP
CHECKED BY:	M. FOWLER
SHEET	84 OF 105