



BRIDGE #27
MM 4.663 - MANCHESTER

LENGTH OF NEW ASPHALTIC PLUG JOINTS:
JOINT #1 = 66'
JOINT #2 = 66'
TOTAL = 132'

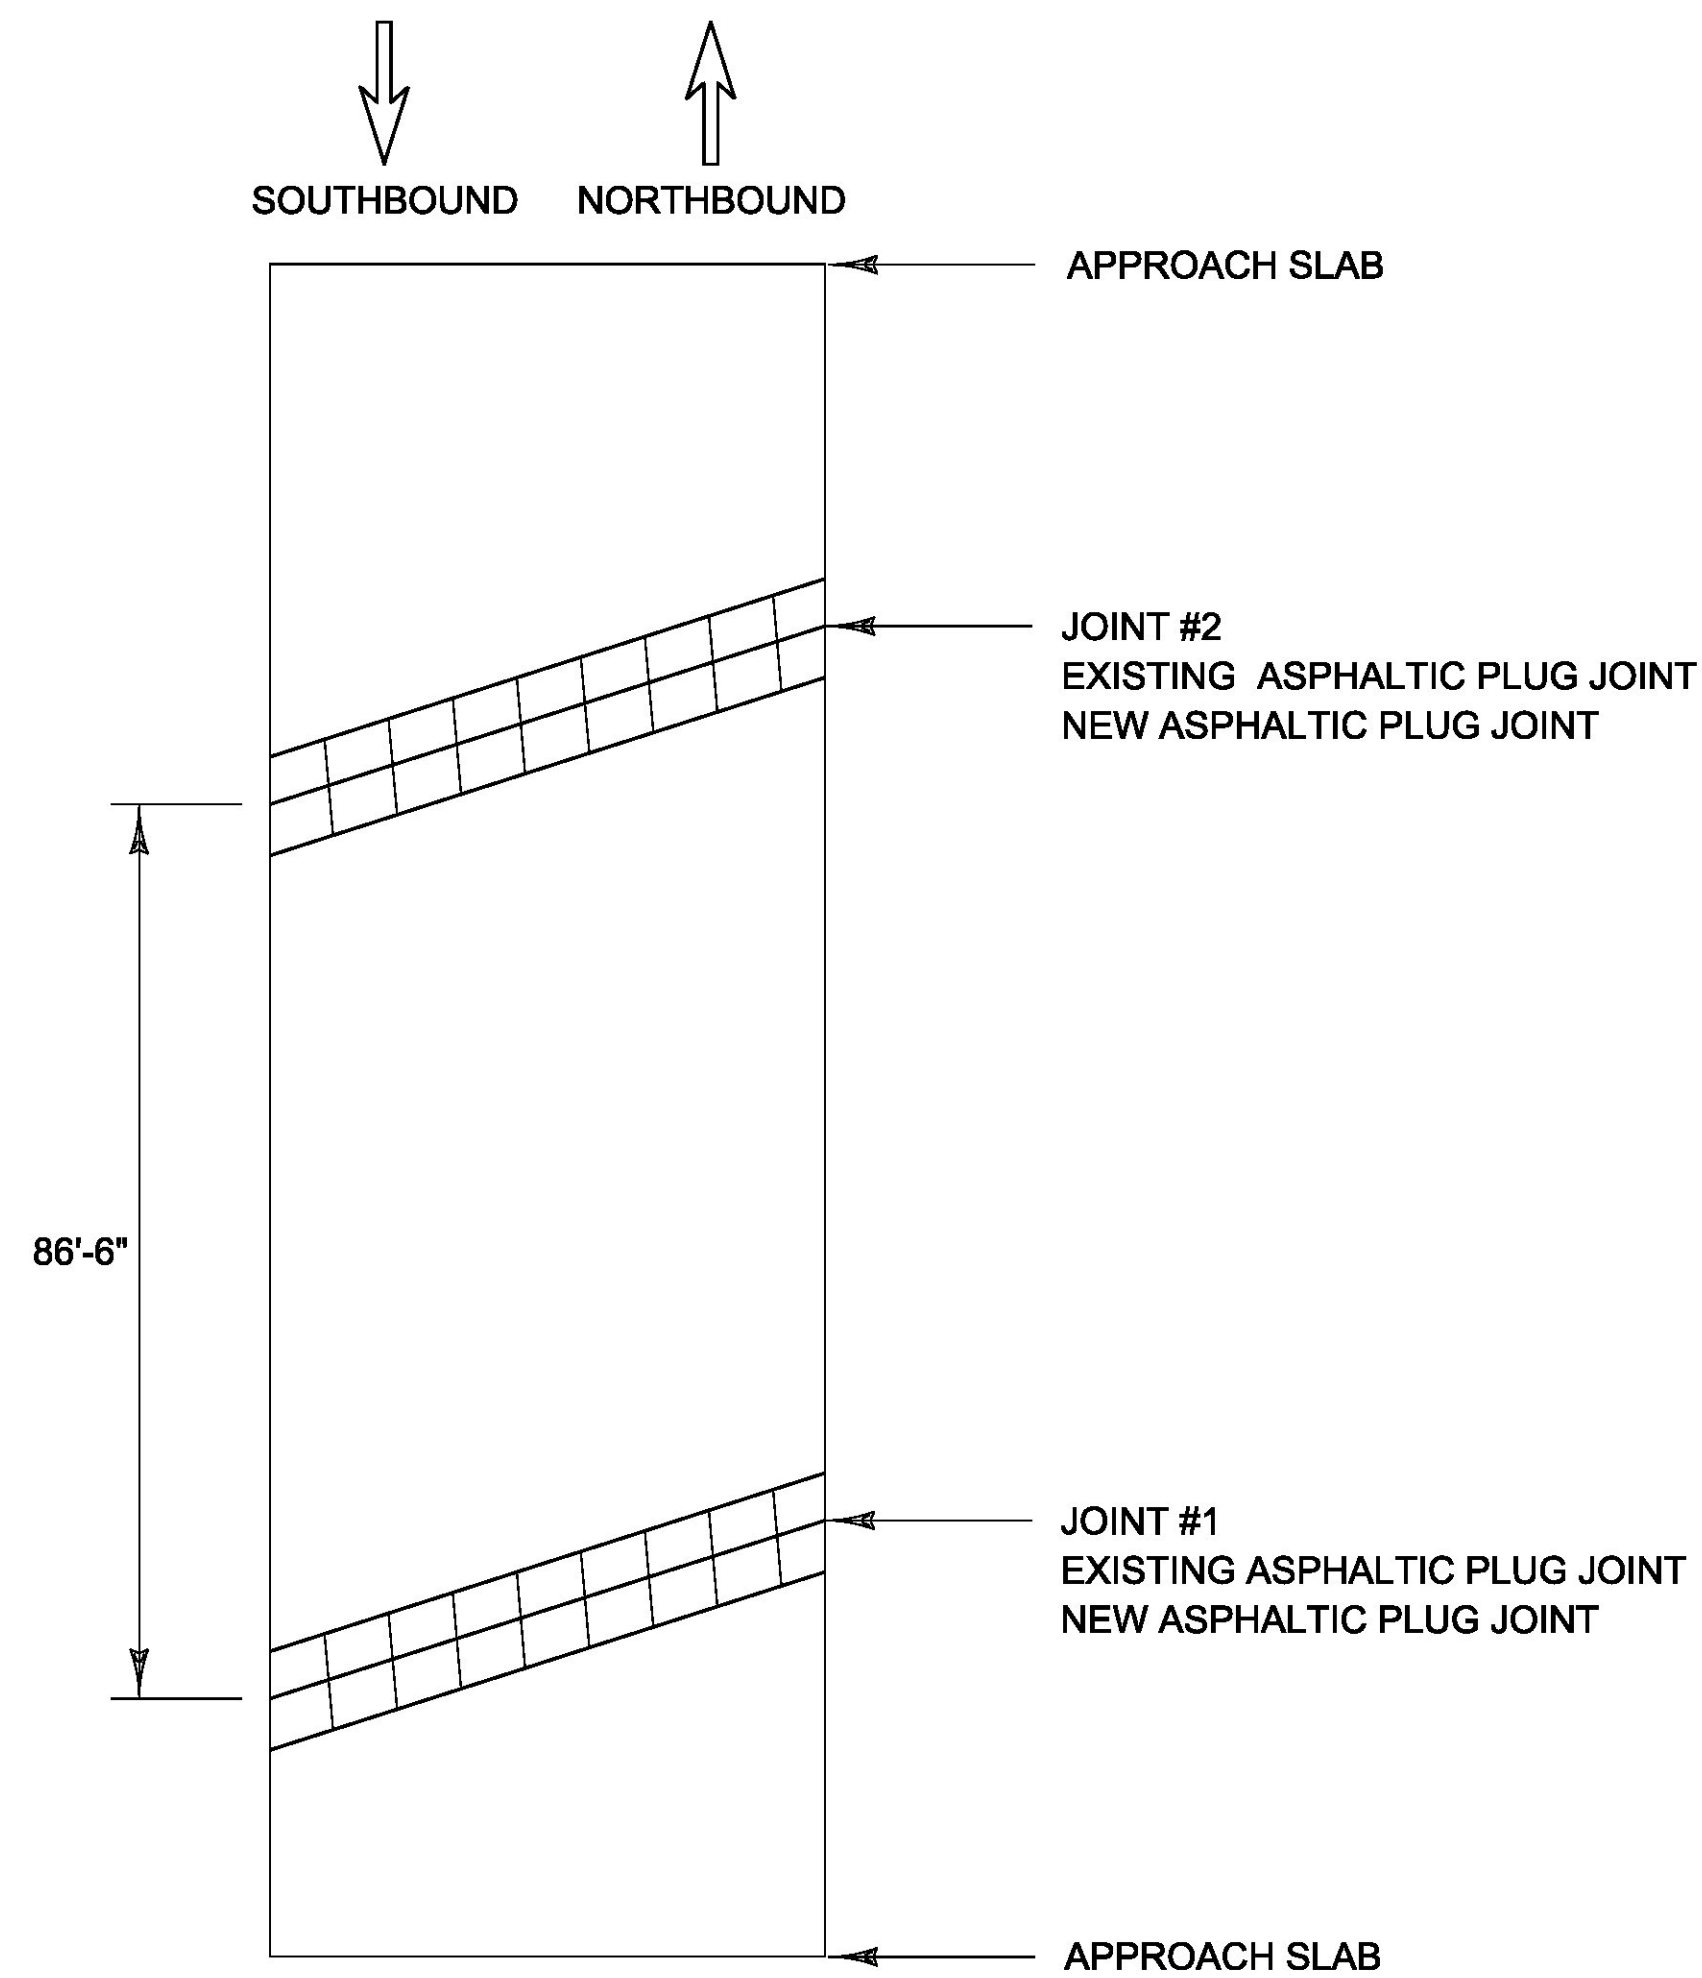

BRIDGE #30
MM 1.301 - DORSET

LENGTH OF NEW ASPHALTIC PLUG JOINTS:
JOINT #1 = 51'
JOINT #2 = ~~51'~~ 50.3'
TOTAL = ~~102'~~ 101.3'

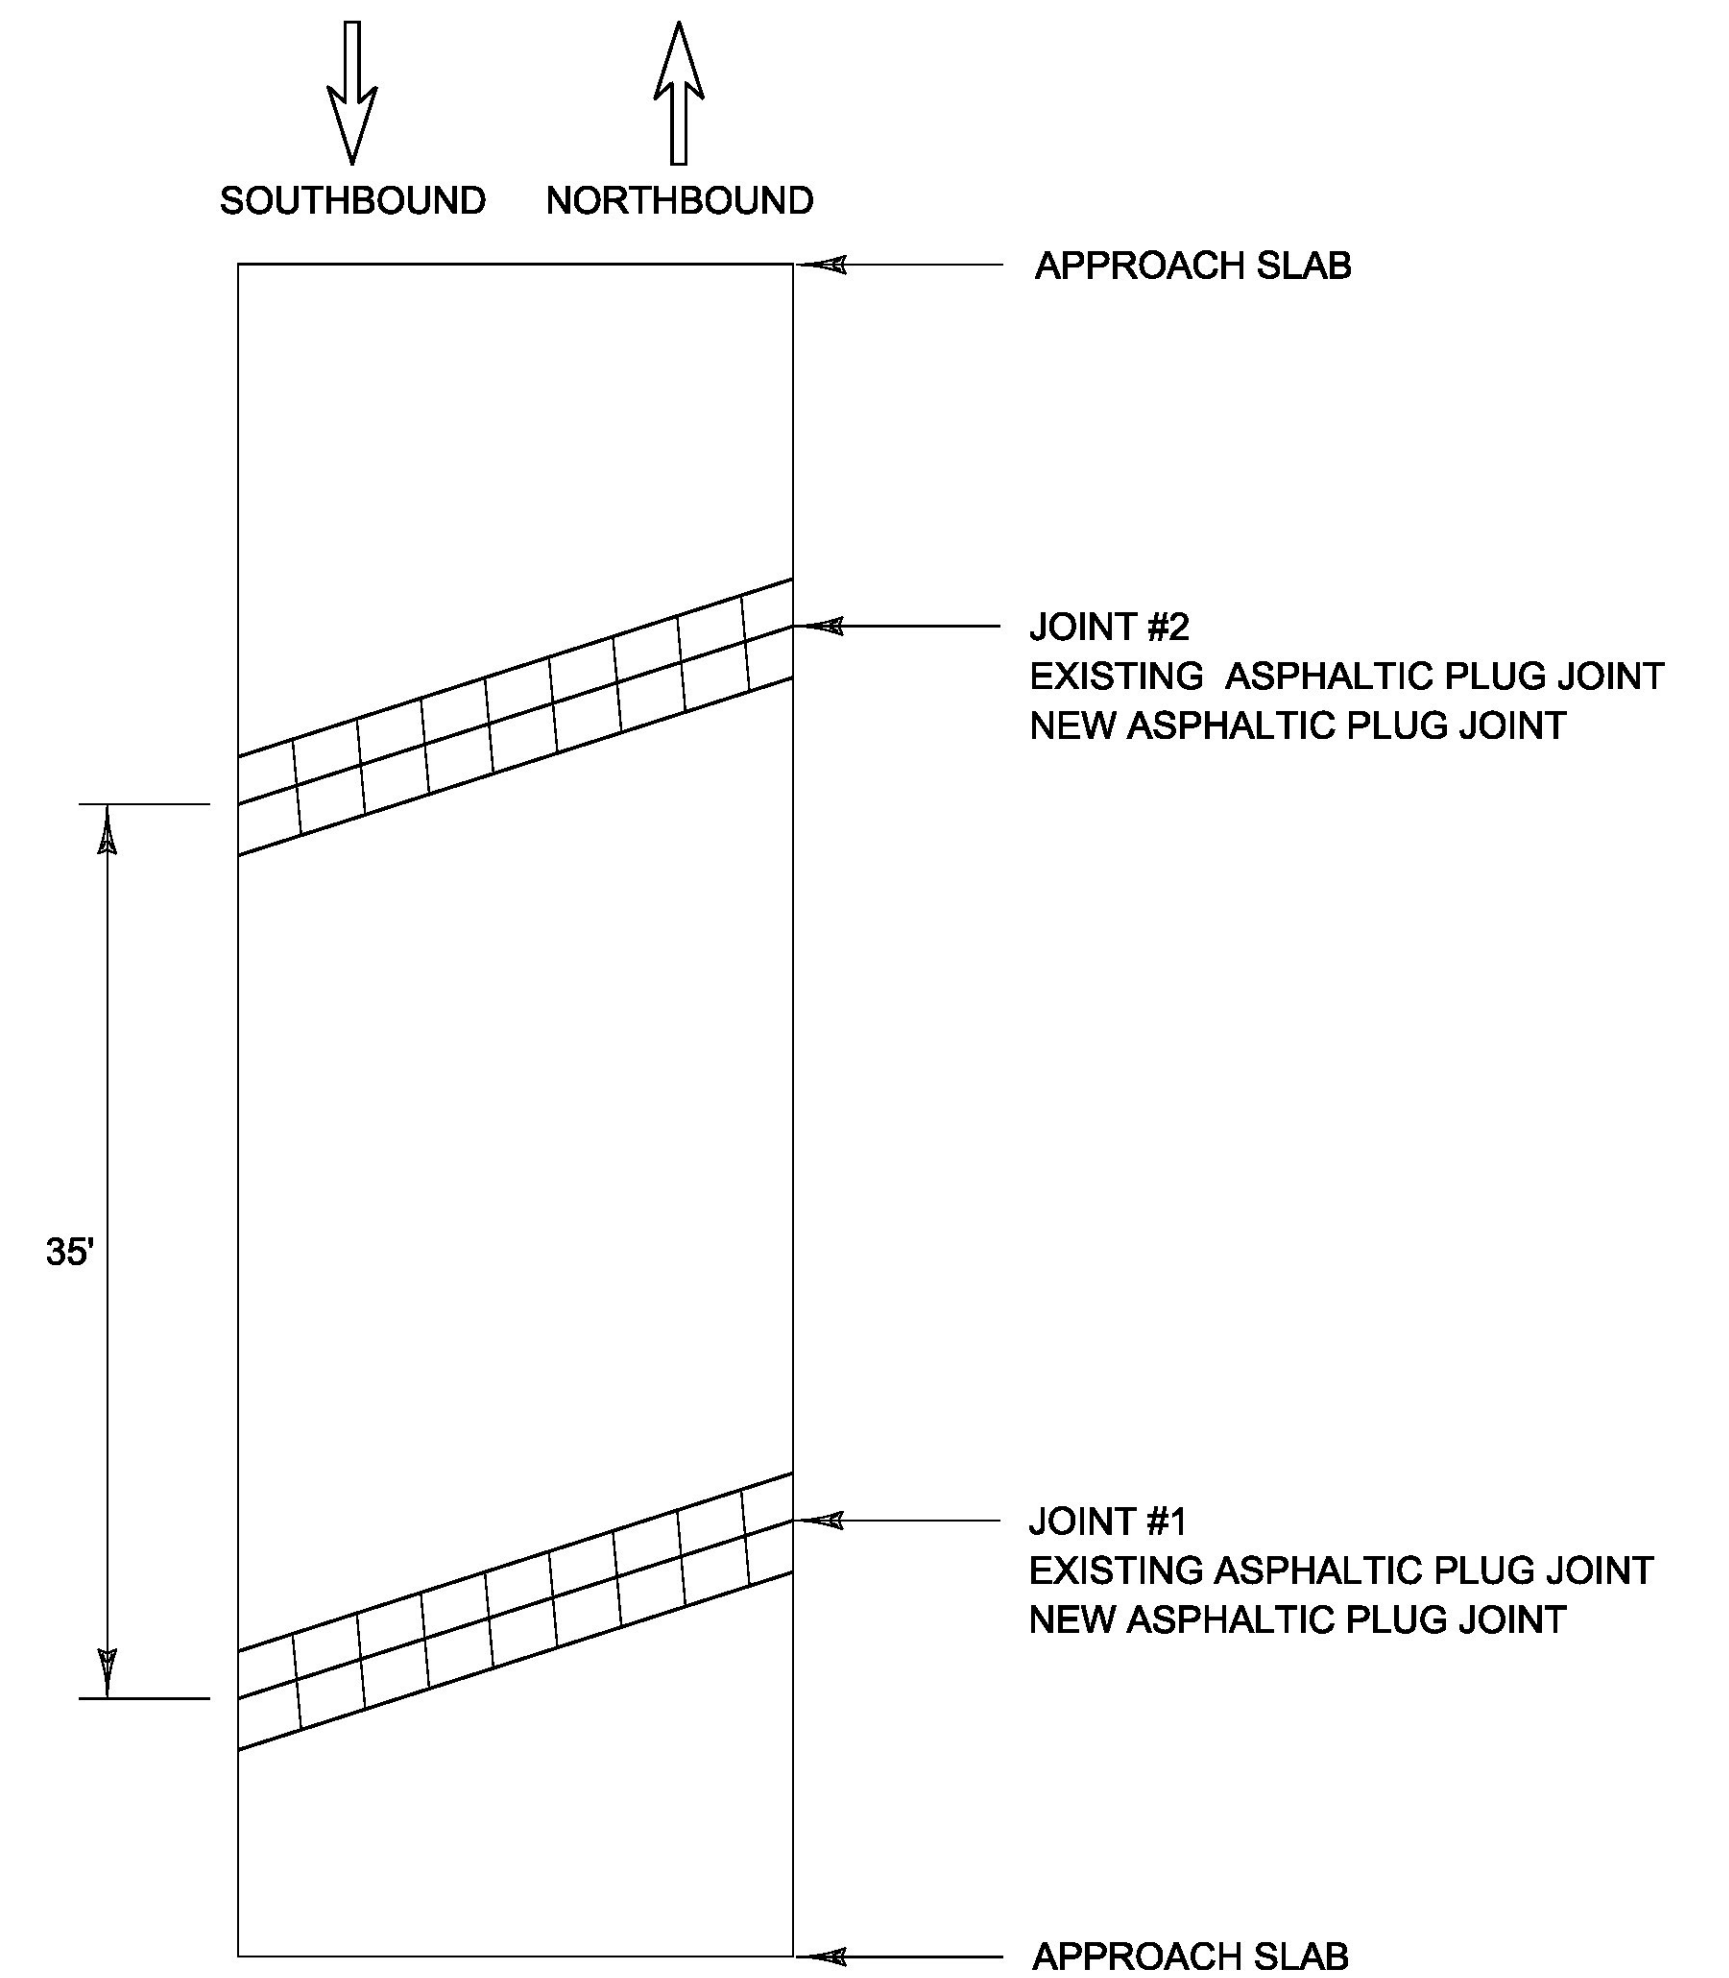

BRIDGE #31
MM 1.477 - DORSET

LENGTH OF NEW ASPHALTIC PLUG JOINTS:
JOINT #1 = ~~97'-6"~~ 100.83'
JOINT #2 = ~~97'-6"~~ 103.17'
TOTAL = ~~195'~~ 204'

PROJECT NAME: MANCHESTER-RUTLAND TOWN	
PROJECT NUMBER: NH SURF(50)	
FILE NAME: p14v200.dgn	PLOT DATE: 1/14/2016
PROJECT LEADER: M. FOWLER	DRAWN BY: B. KIPP
DESIGNED BY: B. KIPP	CHECKED BY: M. FOWLER
BRIDGE EXPANSION JOINT DETAIL SHEET I	SHEET 92 OF 105