


BRIDGE #79
 MM 4.625 - WALLINGFORD
 LENGTH OF NEW ASPHALTIC PLUG JOINTS:
 JOINT #1 = 41' 39.5'
 JOINT #2 = 82' 79.0'
 JOINT #3 = 82' 78.8'
 JOINT #3 = 41' 38.5'
 TOTAL = 246' 235.8'

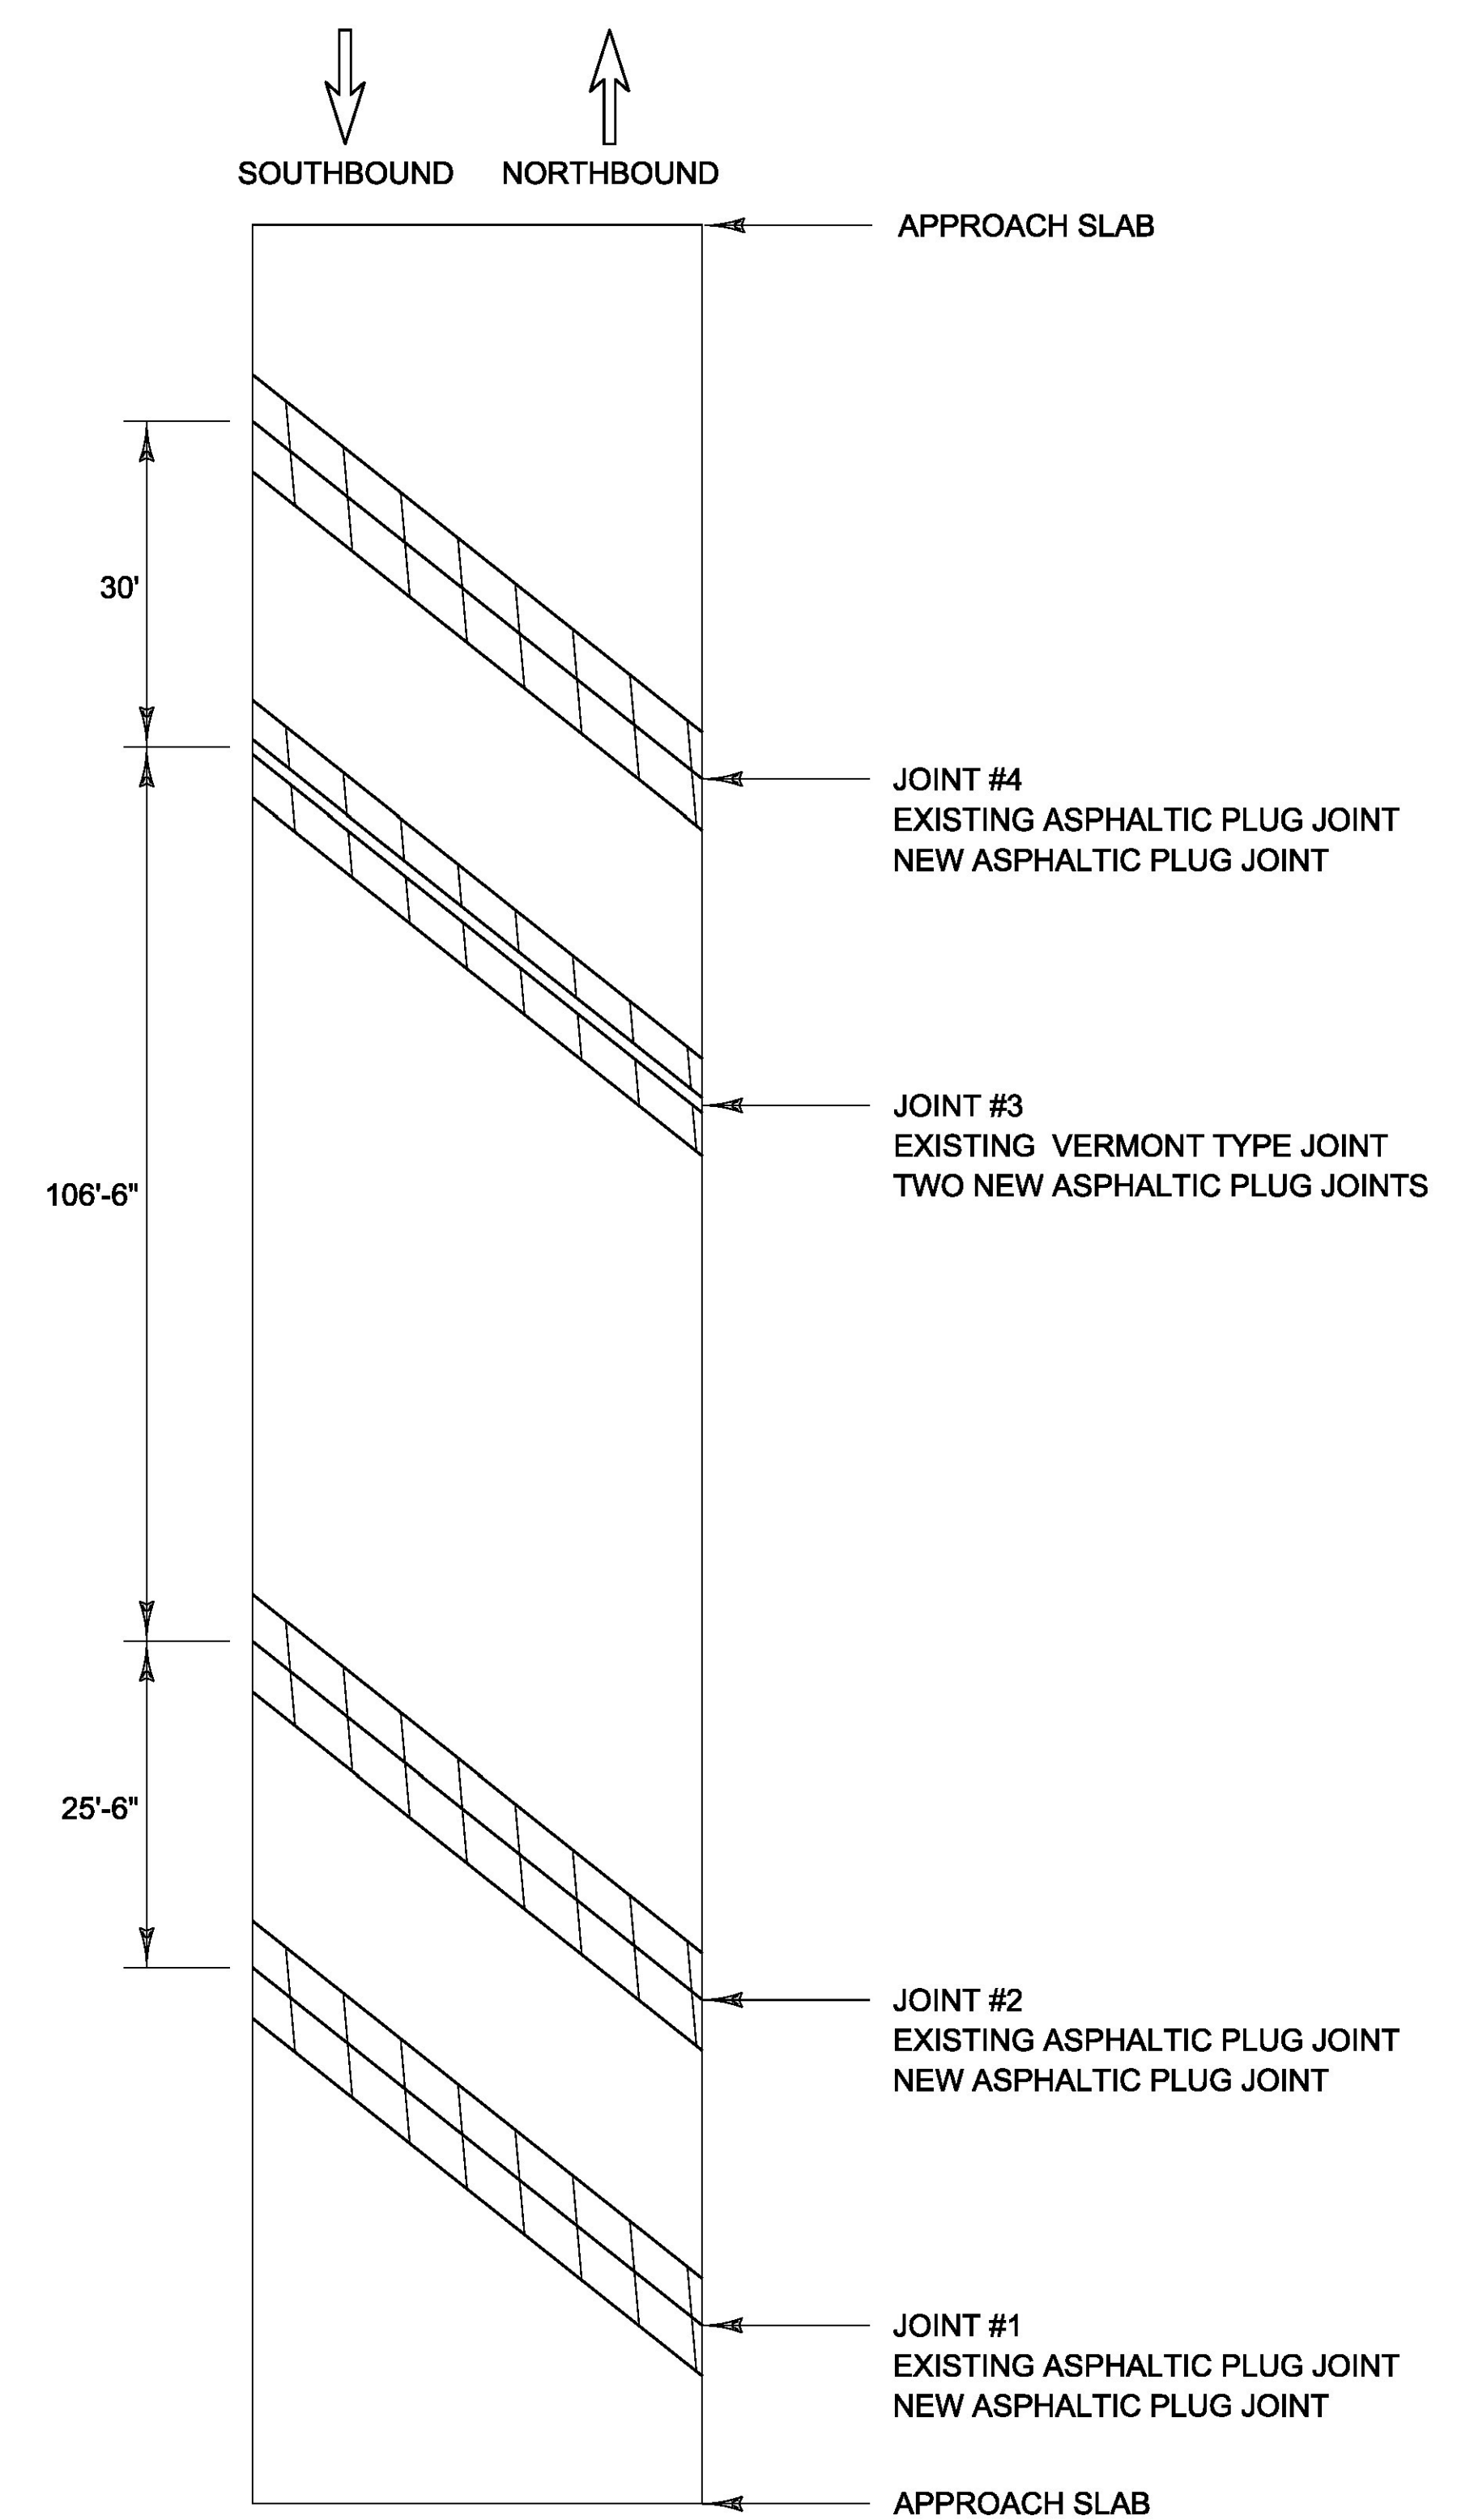

BRIDGE #80
 MM 4.717 - WALLINGFORD
 LENGTH OF NEW ASPHALTIC PLUG JOINTS:
 JOINT #1 = 84' 80.4'
 JOINT #2 = 88' 83.2'
 JOINT #3 = 176' 163.9'
 JOINT #4 = 84' 74.6'
 TOTAL = 432' 402.1'

PROJECT NAME: MANCHESTER-RUTLAND TOWN	
PROJECT NUMBER: NH SURF(50)	
FILE NAME: p14v200.dgn	PLOT DATE: 1/14/2016
PROJECT LEADER: M. FOWLER	DRAWN BY: B. KIPP
DESIGNED BY: B. KIPP	CHECKED BY: M. FOWLER
BRIDGE EXPANSION JOINT DETAIL SHEET 2	SHEET 93 OF 105