



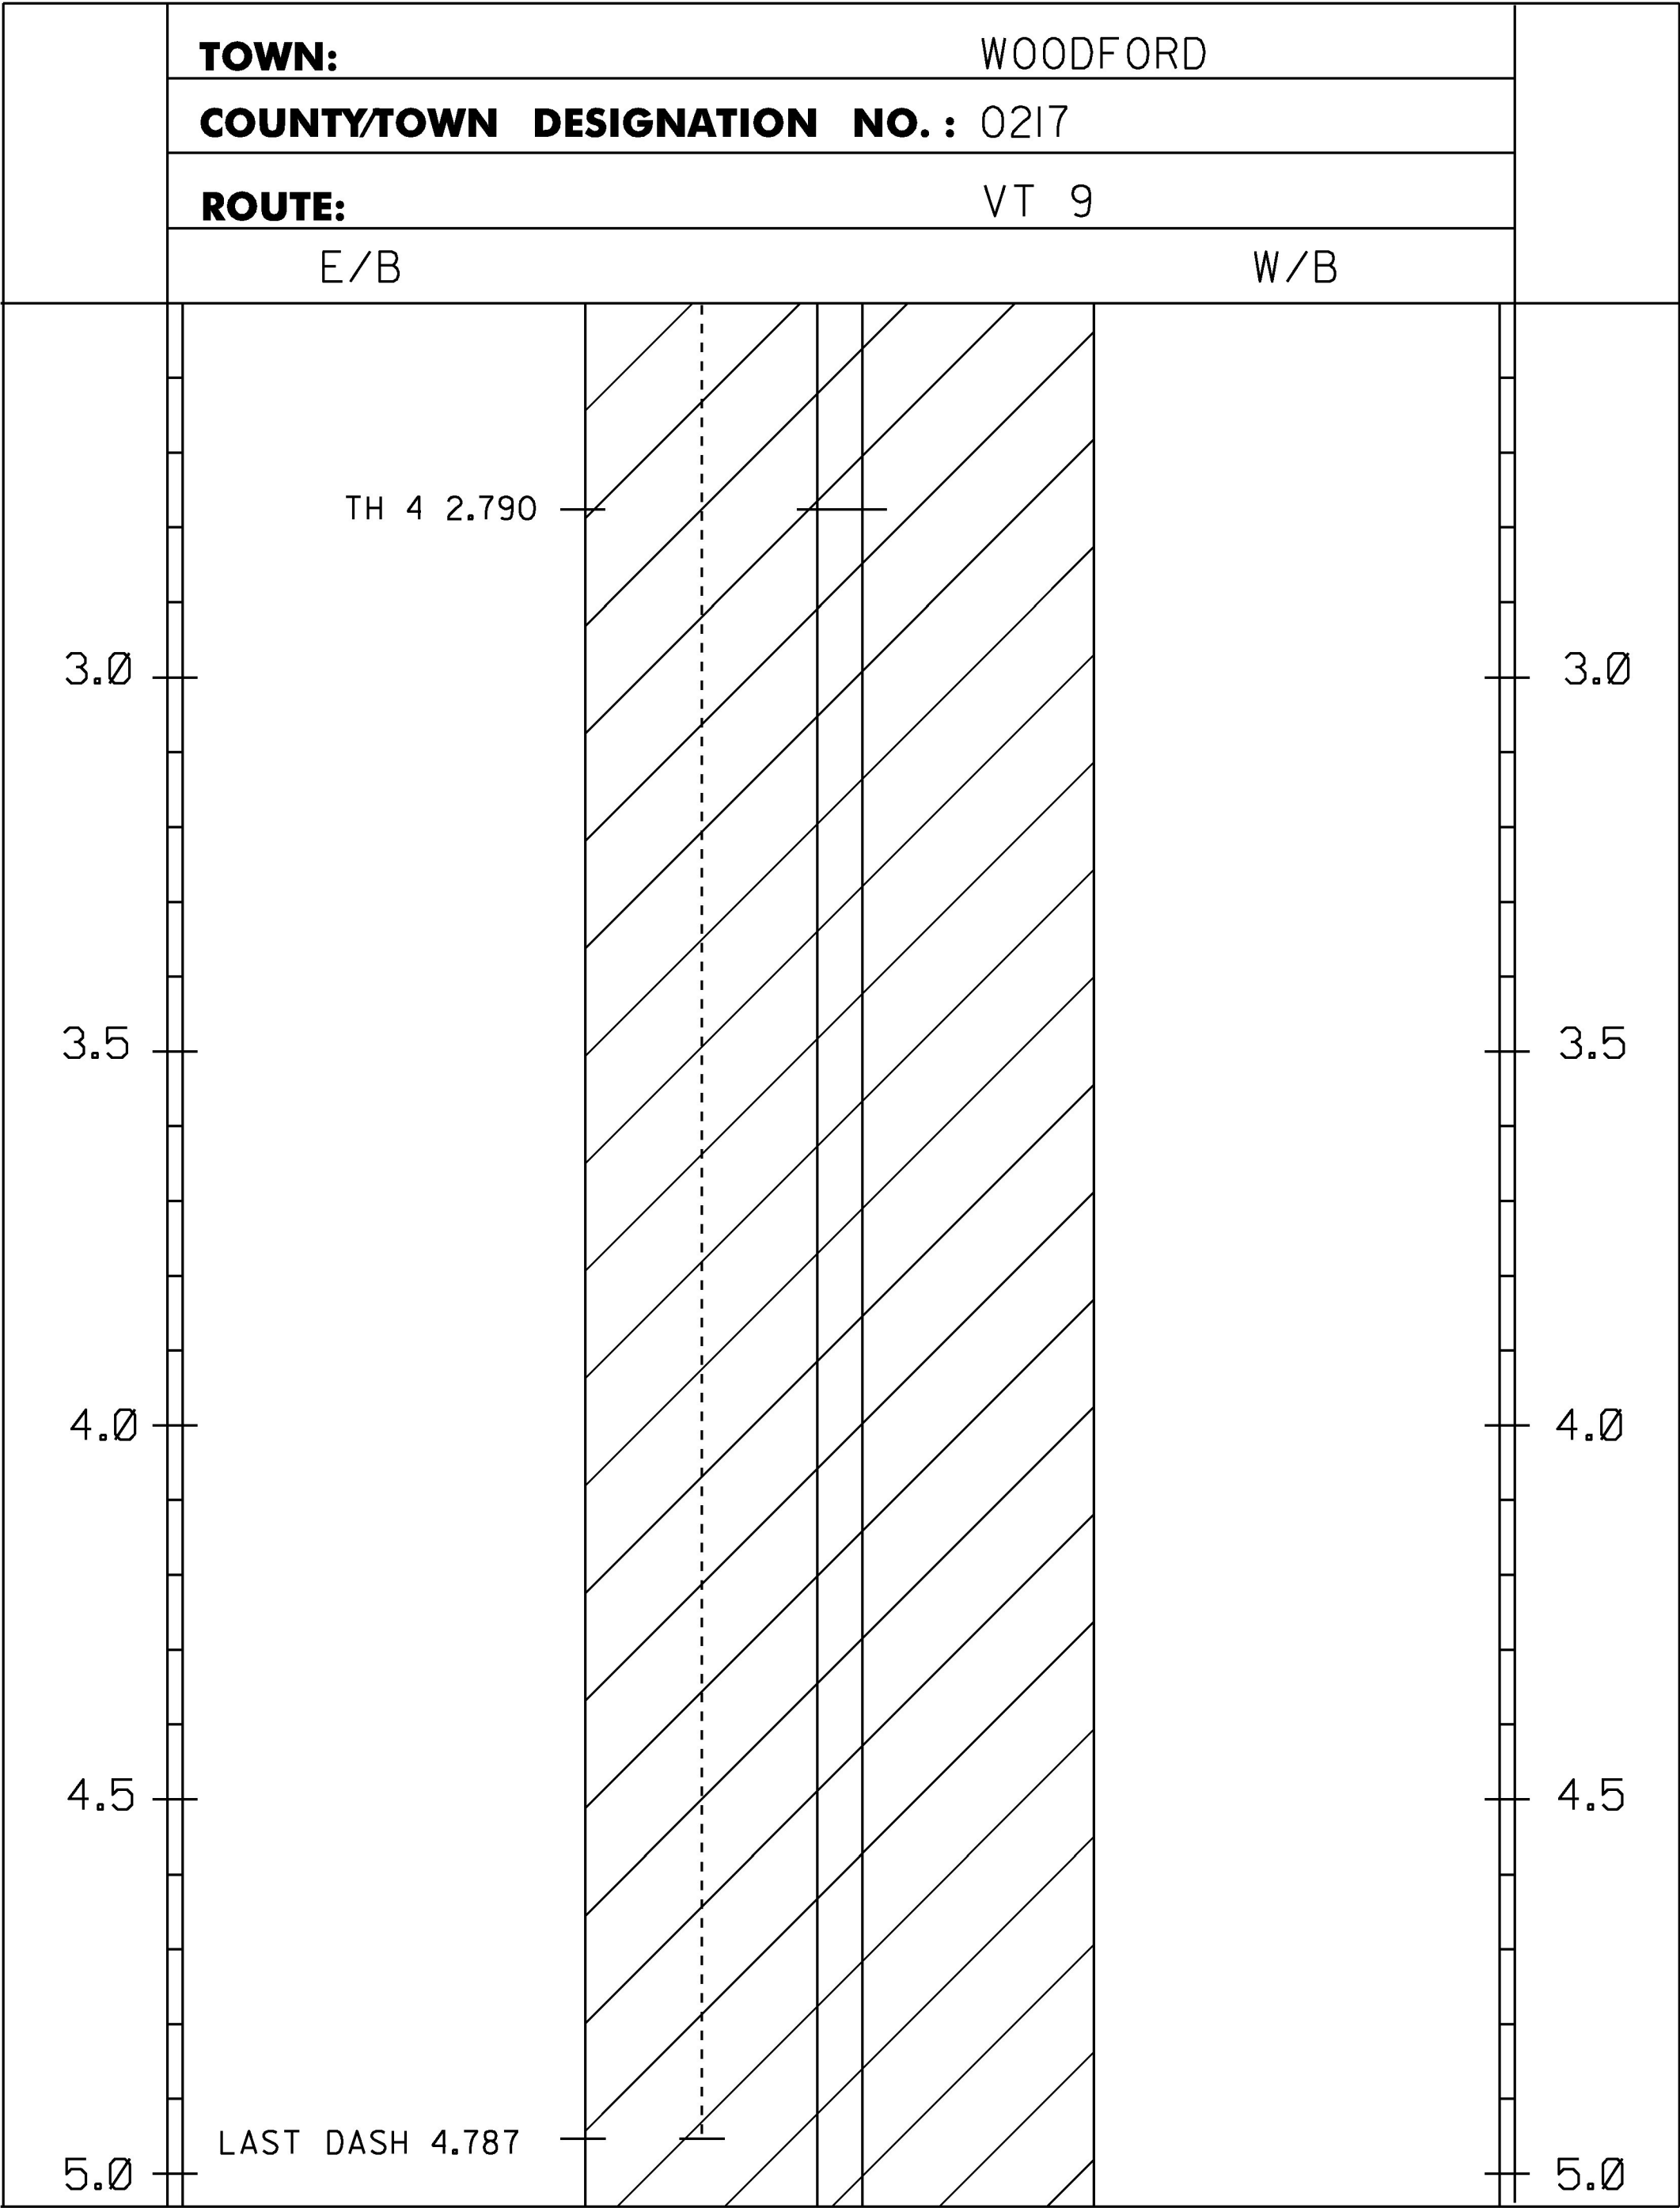


DURABLE 4 INCH WHITE LINE (OPTION BID ITEM)
(ALL LINES WILL INCLUDE EDGE LINE BREAKS AND
RADIUS FOR TOWN HIGHWAYS)
MM 2.500 - MM 7.500 LT & RT
MM 2.500 - 4.787 DASHED RT

DURABLE 4 INCH YELLOW LINE (OPTION BID ITEM)
(ALL LINES WILL INCLUDE C/L BREAKS FOR
TOWN HIGHWAYS)
MM 2.500 - MM 6.990 SOLID LT & RT
MM 6.990 - MM 7.500 SOLID LT & RT

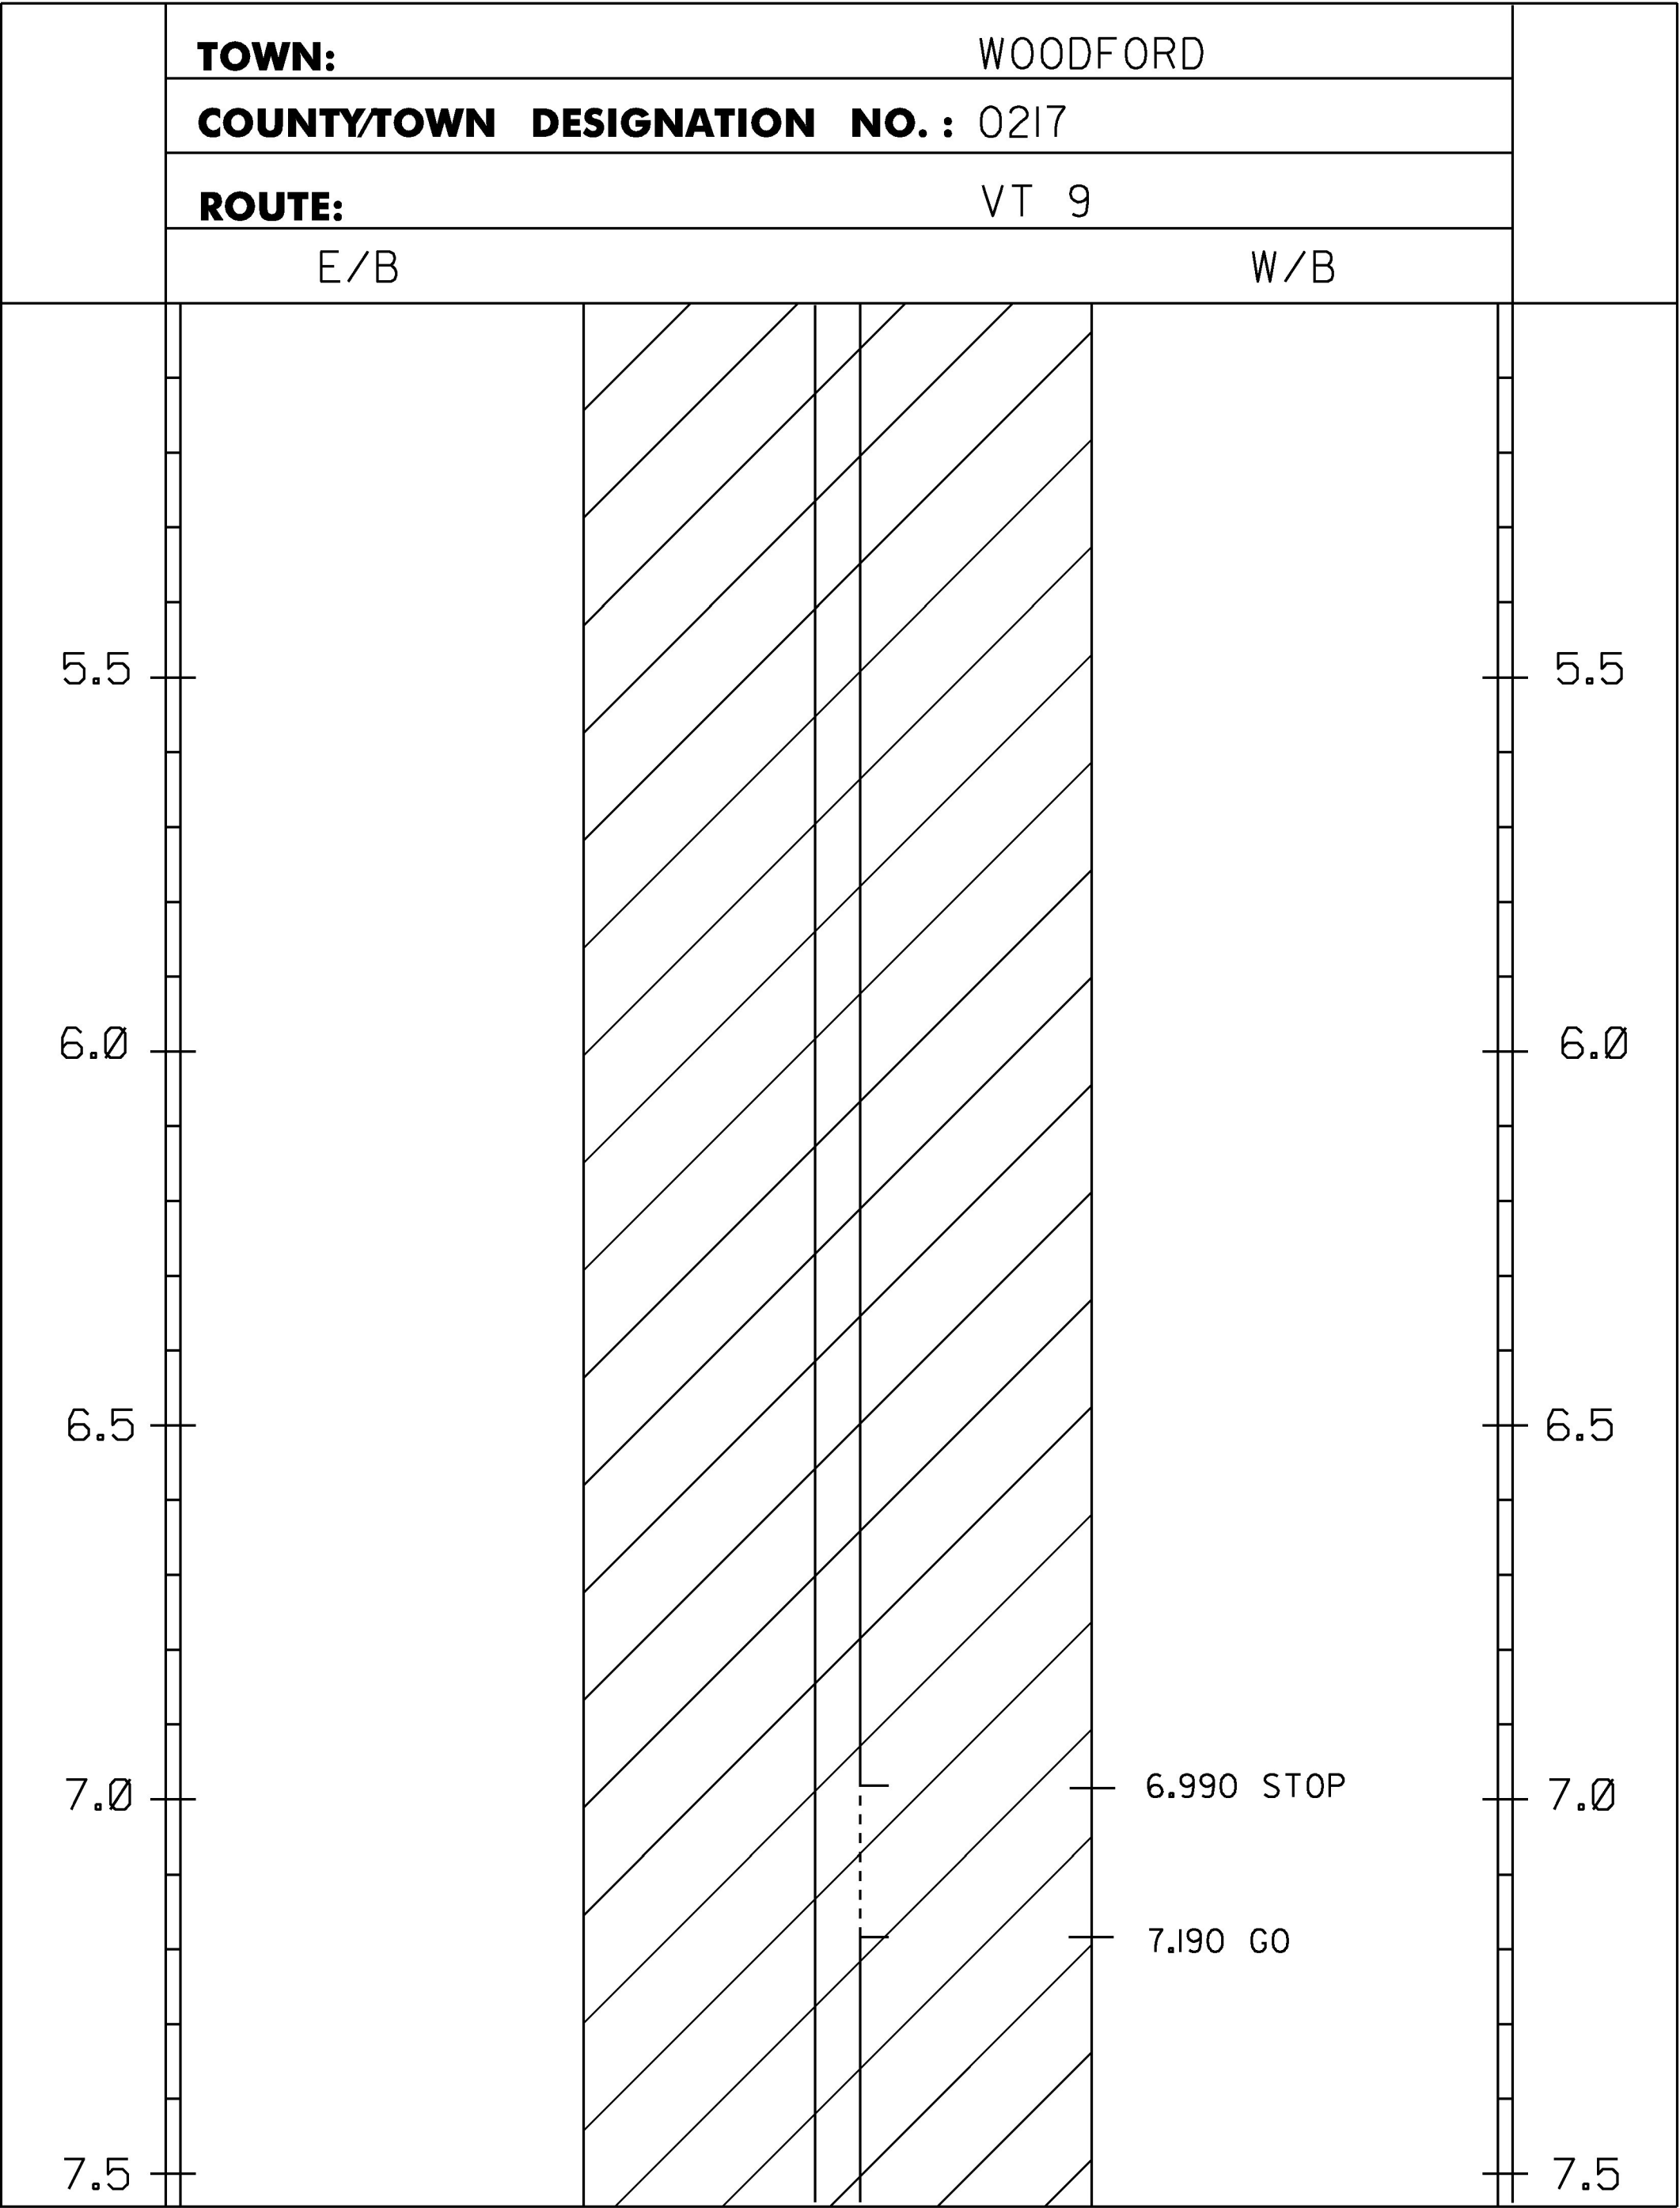

LEGEND
TWBH-THROUGHWAY BEGINS HERE
TWEH-THROUGHWAY ENDS HERE
SHB-STATE HIGHWAY BEGINS
SHE-STATE HIGHWAY ENDS
SL-SPEED LIMIT
T/L-TOWN LINE

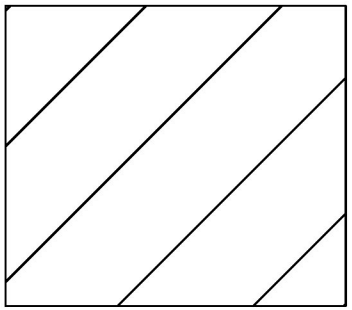

PROJECT AREA

NOTES:
1. THIS SHEET TO BE USED FOR THE LAYOUT OF ALL CENTERLINE PAVEMENT MARKINGS.
THE ENGINEER MAY CONTACT KEITH SWEET, PAVEMENT MARKING SUPERVISOR AT
(802) 828-5573 FOR ASSISTANCE LAYING OUT THE CENTERLINE DURING CONSTRUCTION.

NOT TO SCALE

PROJECT NAME:	BENNINGTON-WILMINGTON		
PROJECT NUMBER:	NH SURF (5I)		
FILE NAME:	pl4v201Bennington-Wilmington.dg	PLLOT DATE:	28-MAR-2017
PROJECT LEADER:	M. FOWLER	DRAWN BY:	N. PAPPAS
DESIGNED BY:	N. PAPPAS	CHECKED BY:	M. FOWLER
LAYOUT SHEET 2		SHEET 21	OF 64