


CHANGING ELEVATION OF SEWER MANHOLES
(ELEVATION ADJUSTMENT BY OTHERS)
BENNINGTON:
MM 5.959 LT
MM 5.988 LT
MM 6.022 LT

629.20 ADJUST ELEVATION OF VALVE BOX
(ELEVATION ADJUSTMENT BY OTHERS)
BENNINGTON:
MM 5.986 RT
MM 5.989 RT


TEMPORARY 4 INCH WHITE LINE, PAINT &
DURABLE 4 INCH WHITE LINE (OPTION BID ITEM)
(ALL LINES WILL INCLUDE EDGE LINE BREAKS AND
RADIUS FOR TOWN HIGHWAYS)
BENNINGTON:
MM 5.958 - 6.032 SOLID LT & RT

TEMPORARY 4 INCH YELLOW LINE, PAINT &
DURABLE 4 INCH YELLOW LINE (OPTION BID ITEM)
(ALL LINES WILL INCLUDE C/L BREAKS FOR
TOWN HIGHWAYS)
BENNINGTON:
MM 5.958 - 6.032 DOUBLE SOLID C/L
MM 5.987 DOUBLE SOLID RT TH-123

TEMPORARY LETTER OR SYMBOL, PAINT &
DURABLE LETTER OR SYMBOL (OPTION BID ITEM)
BENNINGTON:
MM 5.986 RT - "STOP" (4 EACH)
MM 5.997 LT - "AHEAD" (5 EACH)
MM 6.005 LT - "SIGNAL" (6 EACH)

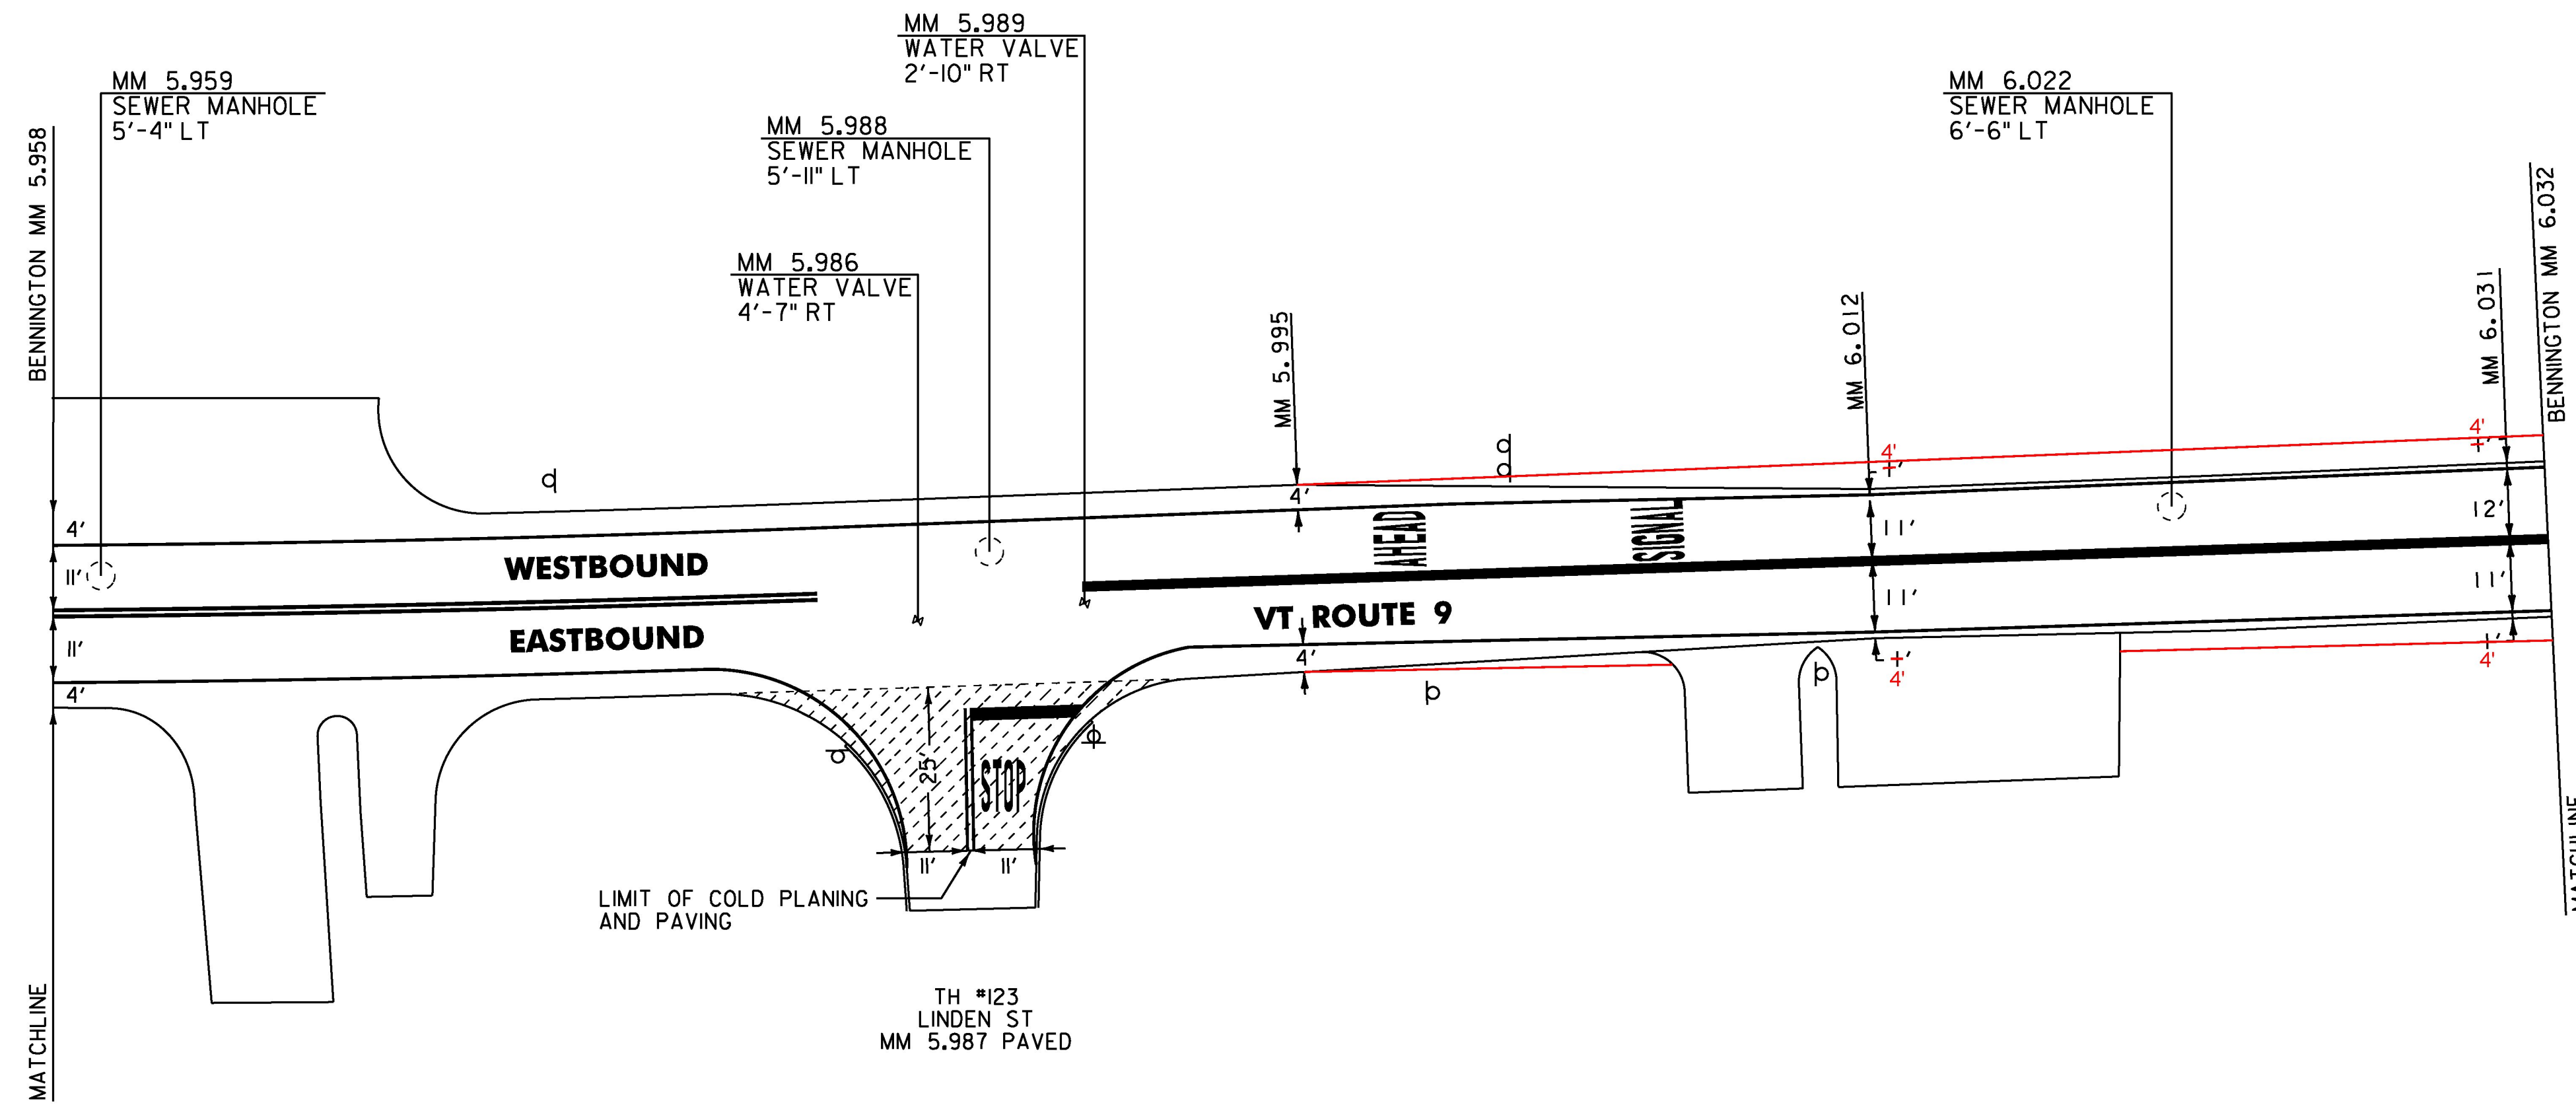

LEGEND: COLD PLANE AREA

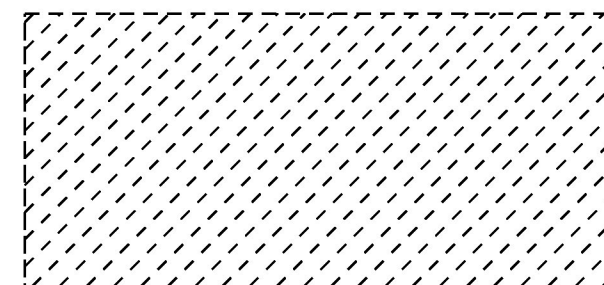

NOT TO SCALE

PROJECT NAME:	BENNINGTON-WILMINGTON
PROJECT NUMBER:	NH SURF (51)
FILE NAME:	p14v201Bennington-Wilmington.dwg
PROJECT LEADER:	M. FOWLER
DESIGNED BY:	N. PAPPAS
LAYOUT SHEET II	
PLOT DATE:	28-MAR-2017
DRAWN BY:	N. PAPPAS
CHECKED BY:	M. FOWLER
SHEET	30 OF 64