

CHANGING ELEVATION OF DROP INLETS,  
CATCH BASINS, OR MANHOLES

WILMINGTON:  
MM 2.371 LT  
MM 2.514 LT  
MM 2.580 LT  
MM 2.617 LT


CHANGING ELEVATION OF SEWER MANHOLES

WILMINGTON:  
MM 2.386 LT  
MM 2.481 LT


TEMPORARY 4 INCH WHITE LINE, PAINT &  
DURABLE 4 INCH WHITE LINE (OPTION BID ITEM)  
(ALL LINES WILL INCLUDE EDGE LINE BREAKS AND  
RADIUS FOR TOWN HIGHWAYS)  
WILMINGTON:  
MM 2.439 - 2.652 EDGE LINE LT & RT

TEMPORARY 4 INCH YELLOW LINE, PAINT &  
DURABLE 4 INCH YELLOW LINE (OPTION BID ITEM)  
(ALL LINES WILL INCLUDE C/L BREAKS FOR  
TOWN HIGHWAYS)  
WILMINGTON:  
MM 2.439 - 2.652 C/L SOLID LT & RT

TEMPORARY 8 INCH WHITE LINE, PAINT &  
DURABLE 8 INCH WHITE LINE (OPTION BID ITEM)  
WILMINGTON:  
MM 2.583 - 2.585 LT NO PARKING FIRE HYDRANT

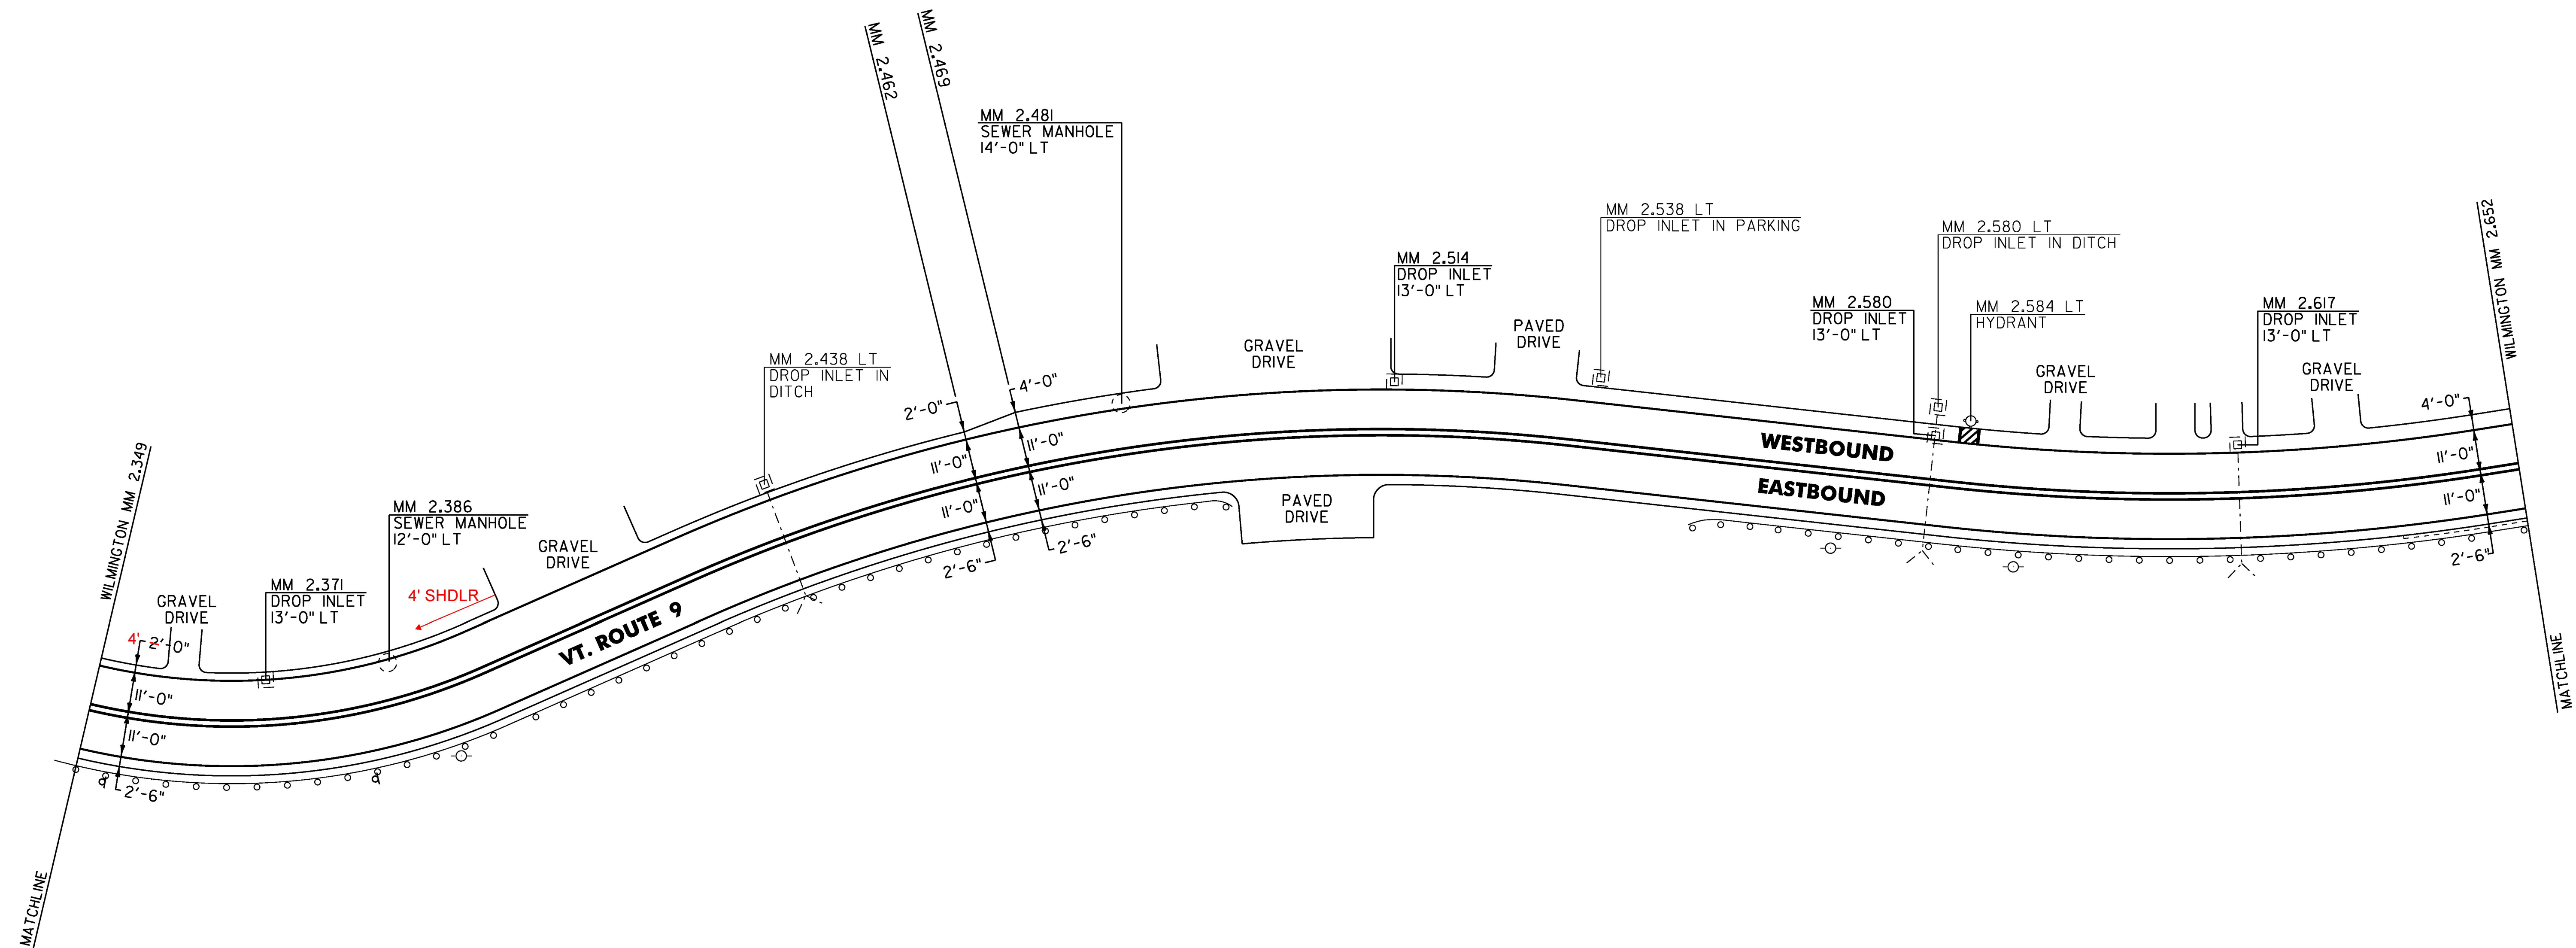

LEGEND: COLD PLANE AREA

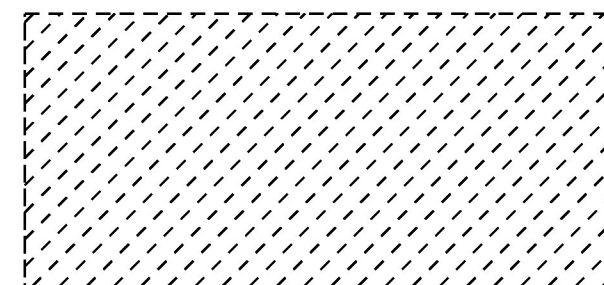

**NOT TO SCALE**

PROJECT NAME:	BENNINGTON-WILMINGTON
PROJECT NUMBER:	NH SURF (51)
FILE NAME: pl4v201Bennington-Wilmington.dg	PLOT DATE: 28-MAR-2017
PROJECT LEADER: M. FOWLER	DRAWN BY: N. PAPPAS
DESIGNED BY: N. PAPPAS	CHECKED BY: M. FOWLER
LAYOUT SHEET 15	SHEET 34 OF 64