

CHANGING ELEVATION OF DROP INLETS, CATCH BASINS, OR MANHOLES
 WILMINGTON:
 MM 2.660 LT
 MM 2.700 LT
 MM 2.670 RT
 MM 2.721 LT
 MM 2.743 LT
 MM 2.764 LT
 MM 2.764 RT
 MM 2.806 LT
 MM 2.843 RT
 MM 2.890 RT
 MM 2.891 LT
 MM 2.923 RT
 MM 2.928 LT



CHANGING ELEVATION OF SEWER MANHOLES
 WILMINGTON:
 MM 2.933 LT
ADJUST ELEVATION OF VALVE BOX
 WILMINGTON:
 MM 2.711 LT
 MM 2.773 LT
 MM 2.821 LT (2)

TEMPORARY 4 INCH WHITE LINE, PAINT & DURABLE 4 INCH WHITE LINE (OPTION BID ITEM)
 (ALL LINES WILL INCLUDE EDGE LINE BREAKS AND RADIUS FOR TOWN HIGHWAYS)
 WILMINGTON:
 MM 2.652 - 2.955 EDGE LINE LT & RT

TEMPORARY 4 INCH YELLOW LINE, PAINT & DURABLE 4 INCH YELLOW LINE (OPTION BID ITEM)
 (ALL LINES WILL INCLUDE C/L BREAKS FOR TOWN HIGHWAYS)
 WILMINGTON:
 MM 2.652 - 2.955 C/L SOLID LT & RT

TEMPORARY 8 INCH WHITE LINE, PAINT & DURABLE 8 INCH WHITE LINE (OPTION BID ITEM)
 WILMINGTON:
 MM 2.722 - 2.724 LT NO PARKING FIRE HYDRANT
 MM 2.820 - 2.822 LT NO PARKING FIRE HYDRANT
 MM 2.886 - 2.888 LT NO PARKING FIRE HYDRANT

DURABLE CROSSWALK MARKING:
 MM 2.900 C/L

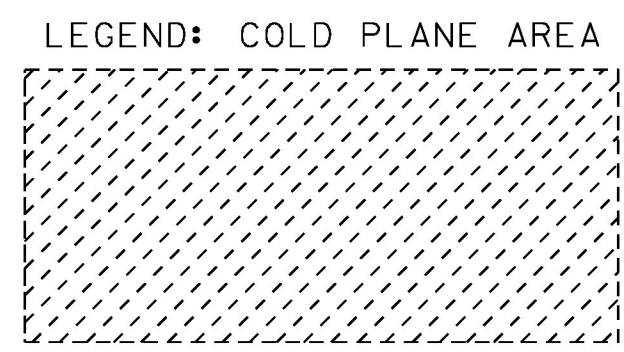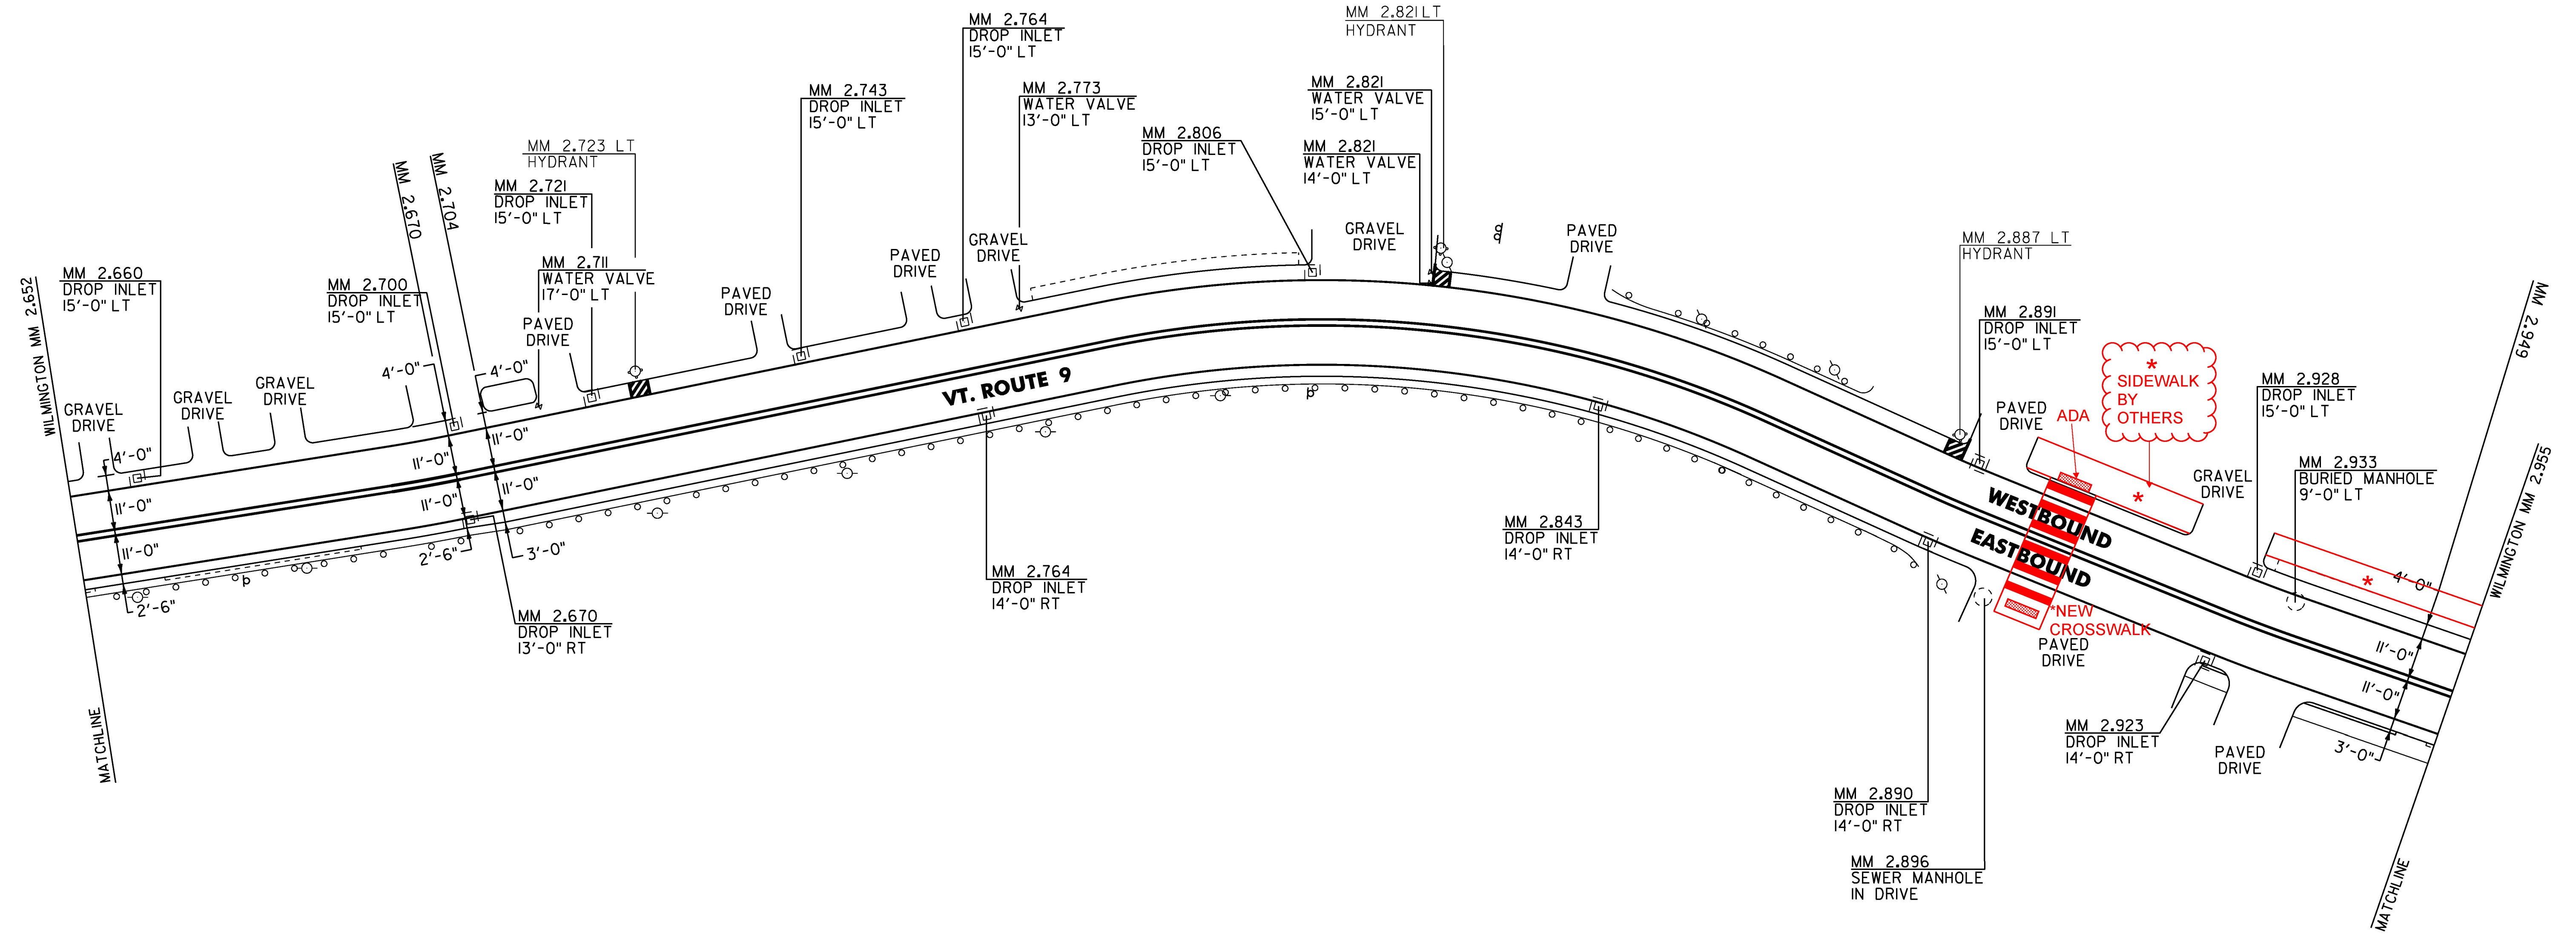

NOT TO SCALE

PROJECT NAME:	BENNINGTON-WILMINGTON
PROJECT NUMBER:	NH SURF (51)
FILE NAME:	p14v201Bennington-Wilmington.dg
PROJECT LEADER:	M. FOWLER
DESIGNED BY:	N. PAPPAS
LAYOUT SHEET 16	
DATE:	28-MAR-2017
DRAWN BY:	N. PAPPAS
CHECKED BY:	M. FOWLER
SHEET 35 OF 64	