

CHANGING ELEVATION OF DROP INLETS,
CATCH BASINS, OR MANHOLES

WILMINGTON:
MM 2.960 LT
MM 2.968 RT
MM 2.968 LT
MM 3.006 RT
MM 3.010 LT

CHANGING ELEVATION OF SEWER MANHOLES

WILMINGTON:
MM 2.960 LT
MM 2.965 LT

ADJUST ELEVATION OF VALVE BOX

WILMINGTON:
MM 3.040 RT
MM 3.018 RT

TEMPORARY 4 INCH WHITE LINE, PAINT &
DURABLE 4 INCH WHITE LINE (OPTION BID ITEM)
(ALL LINES WILL INCLUDE EDGE LINE BREAKS AND
RADIUS FOR TOWN HIGHWAYS)

WILMINGTON:
MM 2.955 - 3.049 EDGE LINE LT & RT

TEMPORARY 4 INCH YELLOW LINE, PAINT &
DURABLE 4 INCH YELLOW LINE (OPTION BID ITEM)
(ALL LINES WILL INCLUDE C/L BREAKS FOR
TOWN HIGHWAYS)

WILMINGTON:
MM 2.955 - 3.049 C/L SOLID LT & RT

TEMPORARY 8 INCH WHITE LINE, PAINT &
DURABLE 8 INCH WHITE LINE (OPTION BID ITEM)


WILMINGTON:
MM 2.957 - 2.960 RT NO PARKING FIRE HYDRANT
MM 3.011 - 3.015 LT NO PARKING
MM 3.017 - 3.023 RT NO PARKING / FIRE HYDRANT
MM 3.031 RT (2)
MM 3.033 RT
MM 3.048 LT

TEMPORARY LETTER OR SYMBOL, PAINT &
DURABLE LETTER OR SYMBOL (OPTION BID ITEM)


WILMINGTON:
MM 3.032 RT - "♿" (1 EACH)

TEMPORARY CROSSWALK MARKING, PAINT &
DURABLE CROSSWALK MARKING (OPTION BID ITEM)

WILMINGTON:
MM 3.016

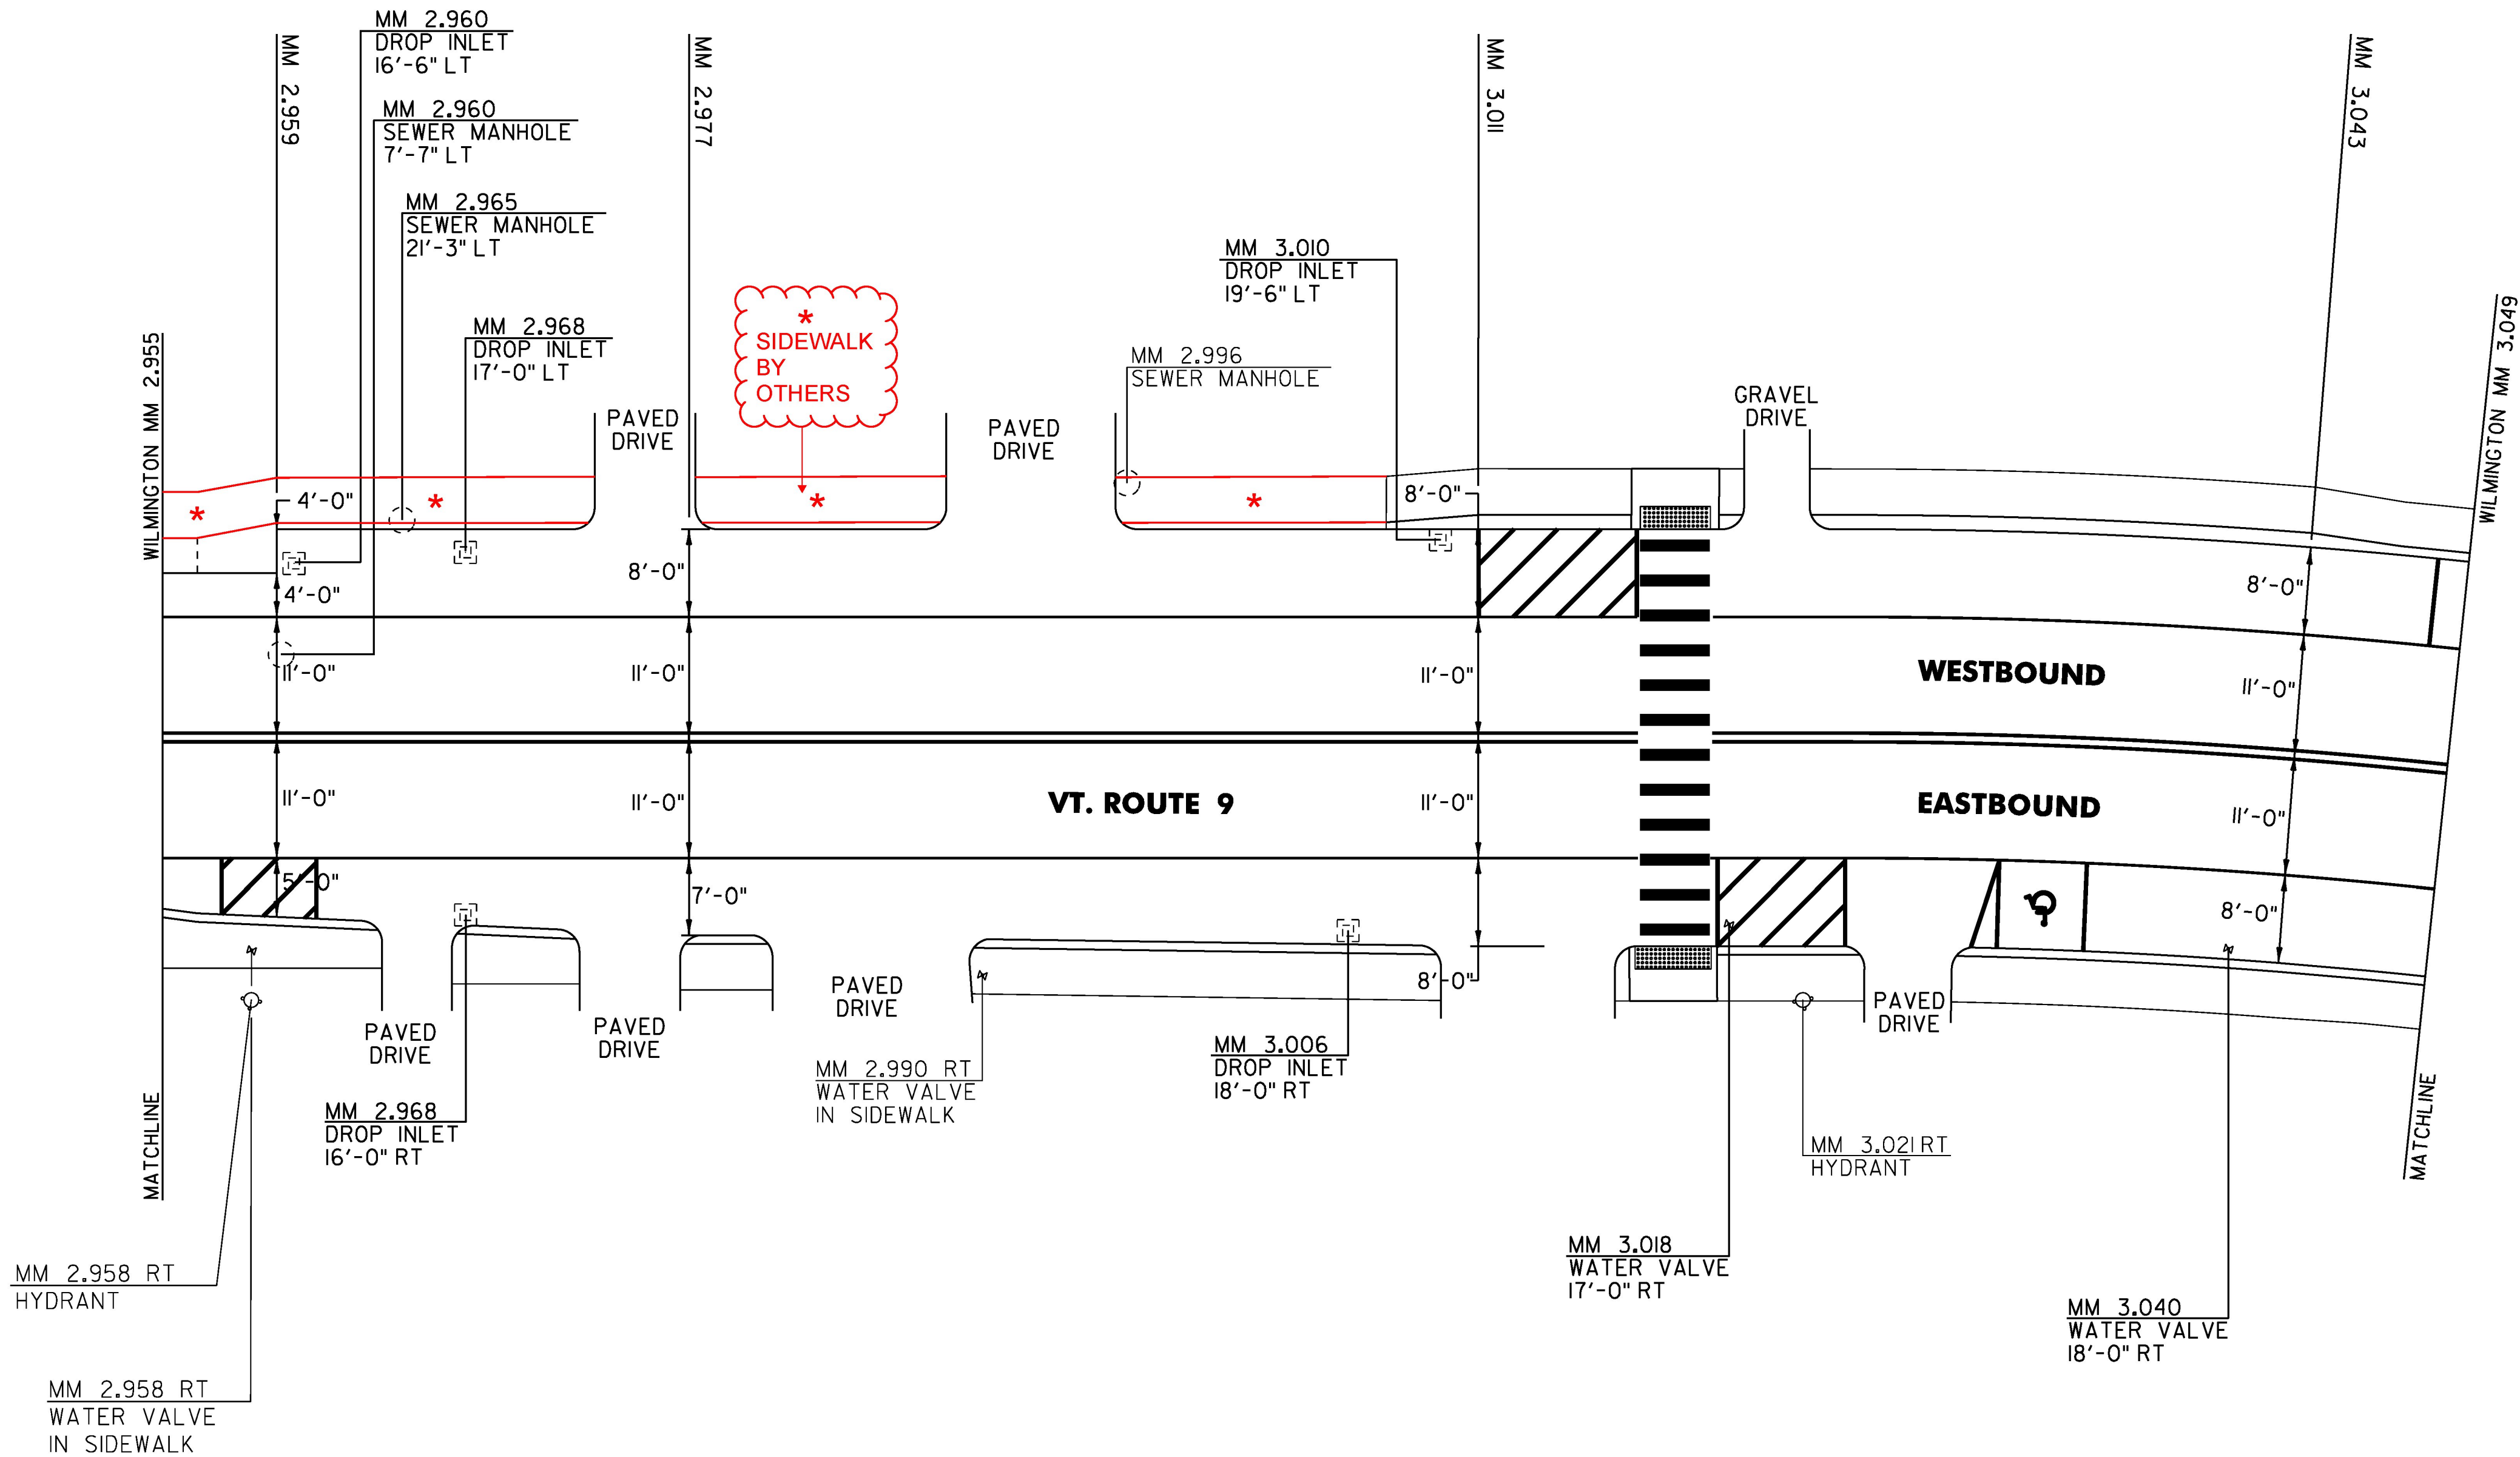

LEGEND: COLD PLANE AREA

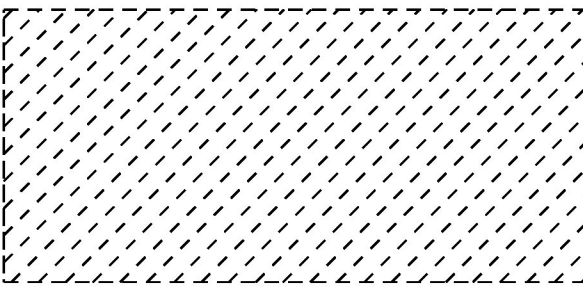

NOT TO SCALE

PROJECT NAME: BENNINGTON-WILMINGTON

PROJECT NUMBER: NH SURF (51)

FILE NAME: pl4v201Bennington-Wilmington.dgn PLOT DATE: 28-MAR-2017

PROJECT LEADER: M. FOWLER

DRAWN BY: N. PAPPAS

DESIGNED BY: N. PAPPAS

CHECKED BY: M. FOWLER

LAYOUT SHEET 17

SHEET 36 OF 64