


WOODFORD
TRUCK LANE MM 2.470 TO MM 4.787

↑
EB

NOT TO SCALE

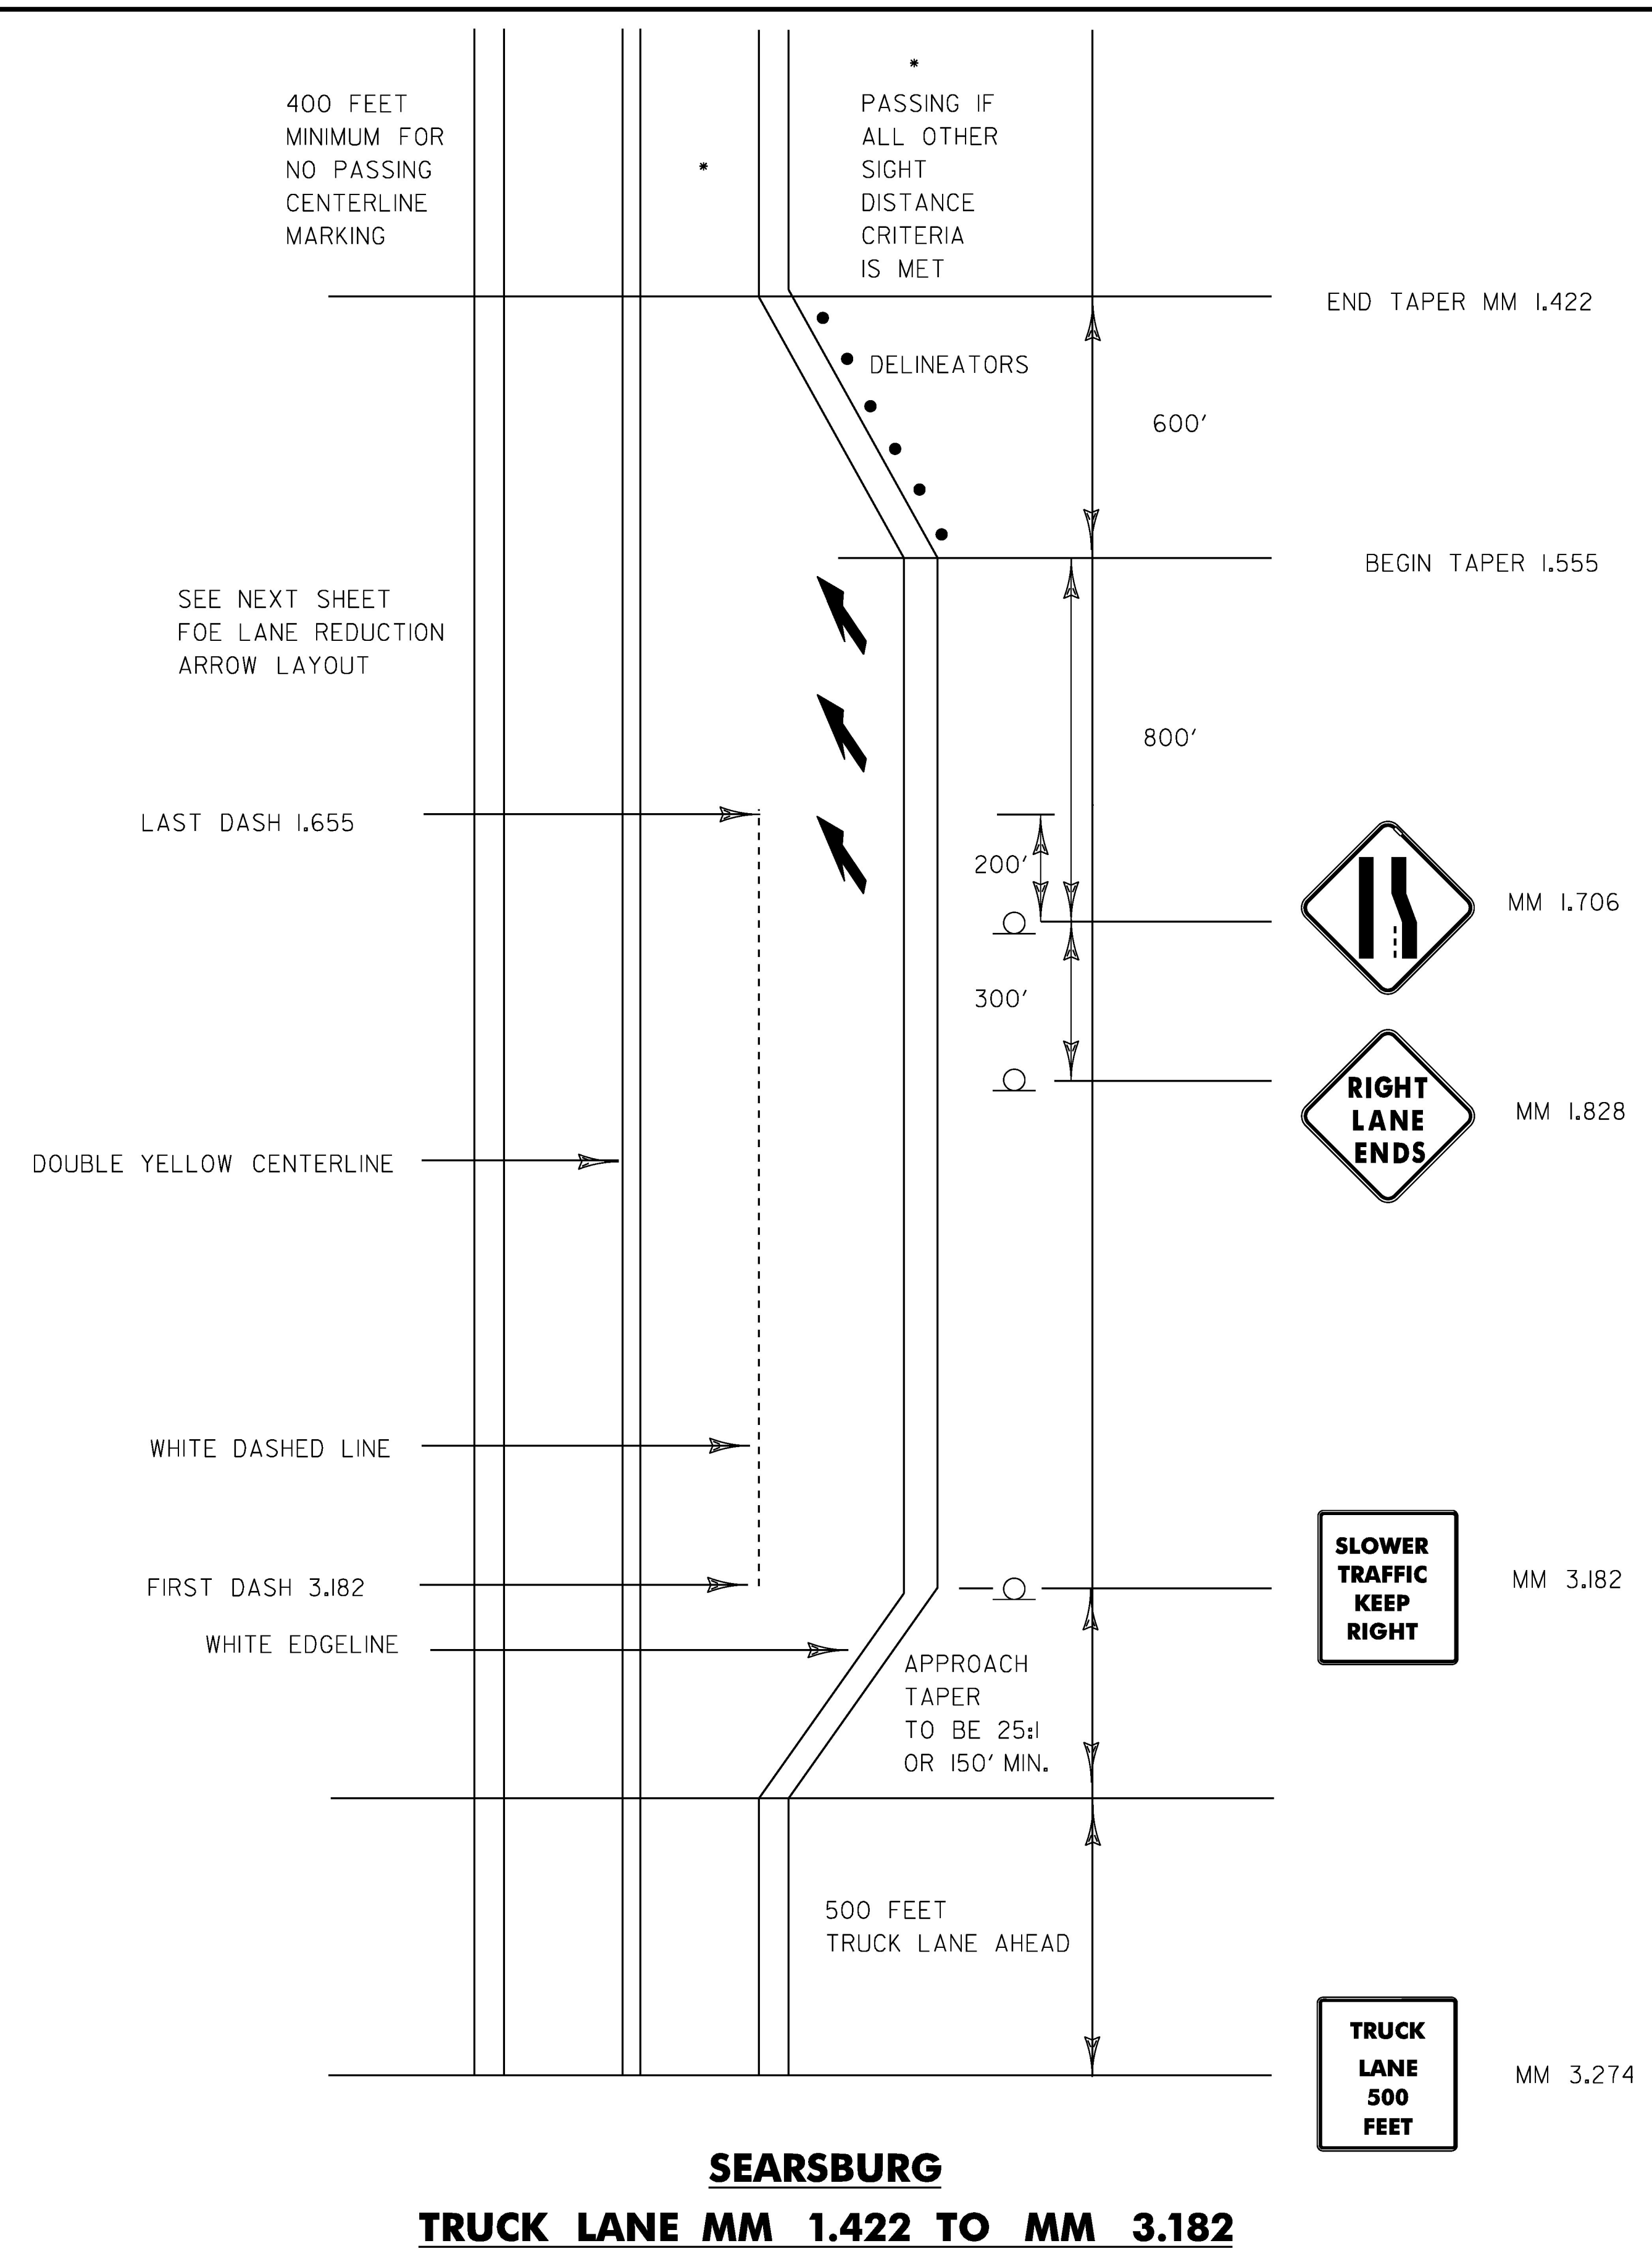

SEARSBURG
TRUCK LANE MM 1.422 TO MM 3.182

↑
WB

PROJECT NAME:	BENNINGTON-WILMINGTON
PROJECT NUMBER:	NH SURF (51)
FILE NAME:	p14v201Bennington-Wilmington.dg
PROJECT LEADER:	M. FOWLER
DESIGNED BY:	N. PAPPAS
LAYOUT SHEET 35	CHECKED BY: M. FOWLER
	DATE: 28-MAR-2017
	DRAWN BY: N. PAPPAS
	SHEET 54 OF 64