

CONTROLLER TIMING CHART

PHASE	1	2	3	4	5	6	7	8	9
IN USE	X	X		X		X		X	X
TRAFFIC MOVEMENT	EBL	WB		SB		EBTHRU		NB	PED
MIN. GREEN	5	9		9		9		9	
WALK									7
PED CLEARANCE									12
MAX 1 - GREEN (OFF)	8	25		25		25		25	
MAX 2 - GREEN (AM)	8	25		25		25		25	
MAX 3 - GREEN (PM)	8	25		25		25		25	
YELLOW CLEARANCE	4	4		4		4		4	
ALL RED CLEARANCE	0	2.5		2.5		2.5		2.5	
VEHICLE EXTENSION	0	3		3		3		3	
DYNAMIC MAX*				48*					
DYNAMIC STEP*				8*					

*TIMING PLAN 1 WITHOUT DYNAMIC MAX.
TIMING PLAN 2 USES SAME TIMINGS WITH DYNAMIC MAX ON PH 4.

TIME OF DAY PLAN

PLAN	EVENT	FLASH	REFERENCE	START TIME
1	1	NO	MAX 1	12:00 AM
1	2	NO	MAX 2	6:00 AM
1	3	NO	MAX 1	10:00 AM
1	4	NO	MAX 3	3:00 PM
1	5	NO	MAX 1	7:00 PM
2	1	NO	MAX 1	12:00 AM

TIMING PLAN

TIMING PLAN	WEEK OF YEAR
1	16-21, 24-45
2	1-15, 22-23, 46-53

AM	OFF	PM
21	19	12
13	15	203
29	41	58

AM	OFF	PM
11	18	17
20	27	34
13	21	20

AM	OFF	PM
8	17	12
151	168	194
103	145	140

AM	OFF	PM
41	48	34
35	31	41
96	146	160

PEAK HOURLY VOLUMES


FROM 2013 COUNT

LIST OF MAJOR EQUIPMENT

EQUIPMENT ITEMS 678J5 - (VT ROUTE 9 & VT ROUTE 100)	QUANTITY	REMARKS
POWER METER WITH BYPASS AND DISCONNECT	1	MOUNTED ON STRAIN POLE
NEMA M TS2 POLE MOUNTED CONTROLLER CABINET WITH ANCILLARY EQUIPMENT	1	ALUMINUM FINISH
NEMA TS2 TRAFFIC SIGNAL CONTROLLER	1	ECONOLITE COBALT TS2, TYPE 2
MALFUNCTION MANAGEMENT UNIT (MMU)	1	ECONOLITE SMARTMONITOR MMU216-LE
ACCESSIBLE PEDESTRIAN PUSH BUTTON ASSEMBLIES	4	WITH RIO-3e SIGN AND INCLUDING WIRING
LED COUNTDOWN PEDESTRIAN SIGNAL HEADS INCLUDING MOUNTING HARDWARE AND WIRING	8	MOUNTING CONFIGURATION TO MATCH EXISTING CONDITION
STOP BAR DETECTOR ASSEMBLY	5	WITH CABLE, MOUNTING BRACKETS AND CABINET INTERFACE
NEW 12-INCH LED SIGNAL HEADS - 3-SECTION WITH VISORS, BACKPLATES AND MOUNTING HDW.	9	MOUNTING CONFIGURATION TO MATCH EXISTING CONDITION
NEW 12-INCH LED SIGNAL HEADS - 5-SECTION WITH VISORS, BACKPLATE AND MOUNTING HDW.	1	MOUNTING LOCATION TO MATCH EXISTING CONDITION
NEW 24" LED BLANKOUT NO RIGHT TURN ON RED SIGNS, INCLUDING MOUNTING HARDWARE AND WIRING	4	MOUNTING LOCATIONS TO MATCH EXISTING CONDITION
SIGNAL WIRING	650 LF	ESTIMATED QTY - AS REQUIRED
SPAN WIRE	75 LF	ESTIMATED QTY - AS REQUIRED

EXISTING AERIAL SIGNAL WIRE AND DETECTION WIRE TO BE REPLACED IN SAME LOCATION. RUN NEW DETECTOR WIRE FOR SPARE IF NOT USED.



PEDESTRIAN COUNTDOWN HEAD AND RIO-3e SIGN

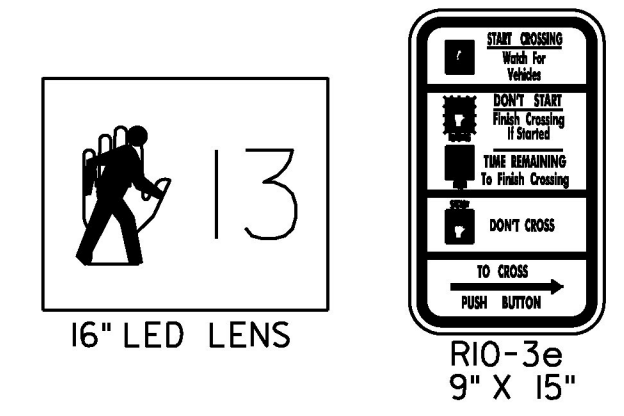

LEGEND

- CC MAST ARM & POLE CONTROLLER CABINET
- JB/PB JUNCTION BOX / PULLBOX
- DPB DOUBLE PULLBOX OR JUNCTION BOX
- PP PEDESTAL POST
- Signal Head with Phase No. SIGNAL HEAD WITH PHASE NO.
- PEDESTRIAN SIGNAL HEAD PEDESTRIAN SIGNAL HEAD
- WIRED CONDUIT WIRED CONDUIT IN ELECTRICAL CONDUIT SLEEVE
- MAST ARM-MOUNTED SIGN MAST ARM-MOUNTED SIGN
- STOP BAR DETECTOR STOP BAR DETECTOR
- STOP BAR DETECTION AREA STOP BAR DETECTION AREA

PHASING DIAGRAM

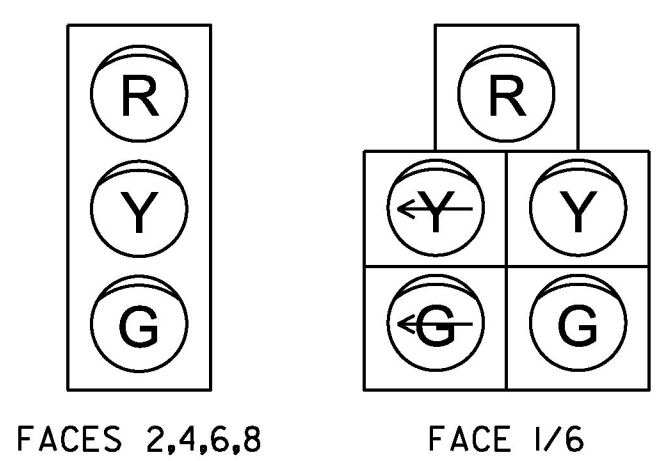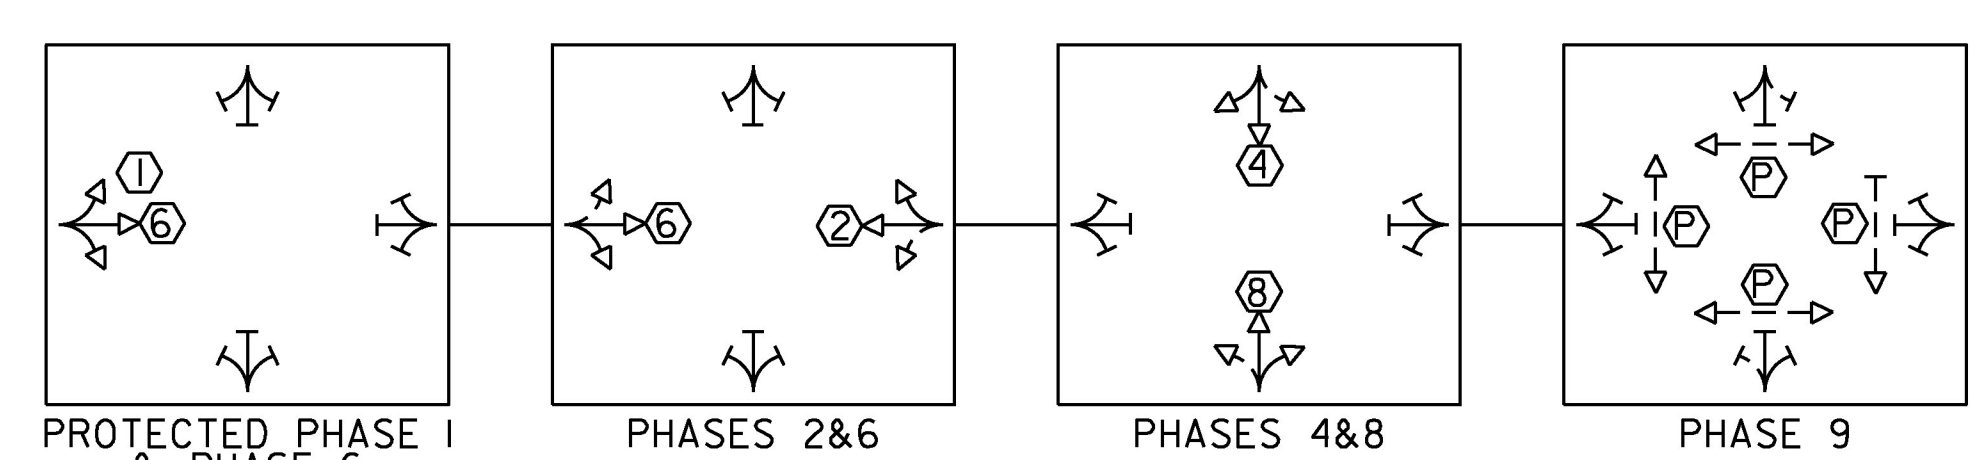

FACES 2,4,6,8

FACE 1/6



PROJECT NAME:	BENNINGTON-WILMINGTON
PROJECT NUMBER:	NH SURF(51)
FILE NAME: t14v20inu1.dgn	PLOT DATE: 28-MAR-2017
PROJECT LEADER: M. FOWLER	DRAWN BY: K. RECORD
DESIGNED BY: K. RECORD	CHECKED BY: M. LACROIX
TRAFFIC SIGNAL SYSTEM SHEET	SHEET 56 OF 64