

STATE OF VERMONT AGENCY OF TRANSPORTATION



PROPOSED IMPROVEMENT TOWNS OF POWNAL, BENNINGTON, WOODFORD, SEARSBURG AND WILMINGTON COUNTIES OF BENNINGTON & WINDHAM US ROUTE 7 & VT ROUTE 9 PRINCIPAL ARTERIAL (NHS)

BEGINNING IN THE TOWN OF POWNAL AT MILE MARKER 0.000 (VT/MA STATE LINE) AND EXTENDING NORTHERLY ALONG US ROUTE 7 FOR A DISTANCE OF 52,625.76 FT (9.967 MILES) TO MILE MARKER 1.967 IN THE TOWN OF BENNINGTON.


LENGTH OF ROADWAY = 52,625.76 FT = (9.967 MILES)
LENGTH OF PROJECT = 52,625.76 FT = (9.967 MILES)

ALSO, BEGINNING IN THE TOWN OF BENNINGTON AT MM 5.672 AND EXTENDING EASTERLY ALONG VT ROUTE 9 FOR A DISTANCE OF 123,921.60 FEET (23.470 MILES) TO A POINT IN WILMINGTON AT MM 7.160.

LENGTH OF ROADWAY 123,921.60 FT (23.470 MILES)
LENGTH OF PROJECT 123,921.60 FT (23.470 MILES)

TOTAL LENGTH OF PROJECT 176,547.36 FT (33.437 MILES)

WORK TO BE PERFORMED UNDER THIS PROJECT INCLUDES RUMBLE STRIPS, SURFACE PREPARATION INVOLVING PATCHING, POT HOLE REPAIR, CRACK SEALING, COLD PLANING & OVERLAYING WITH A THIN BITUMINOUS CONCRETE WEARING SURFACE ON THE EXISTING TYPICAL, PAVEMENT MARKINGS AND OTHER HIGHWAY RELATED ITEMS.

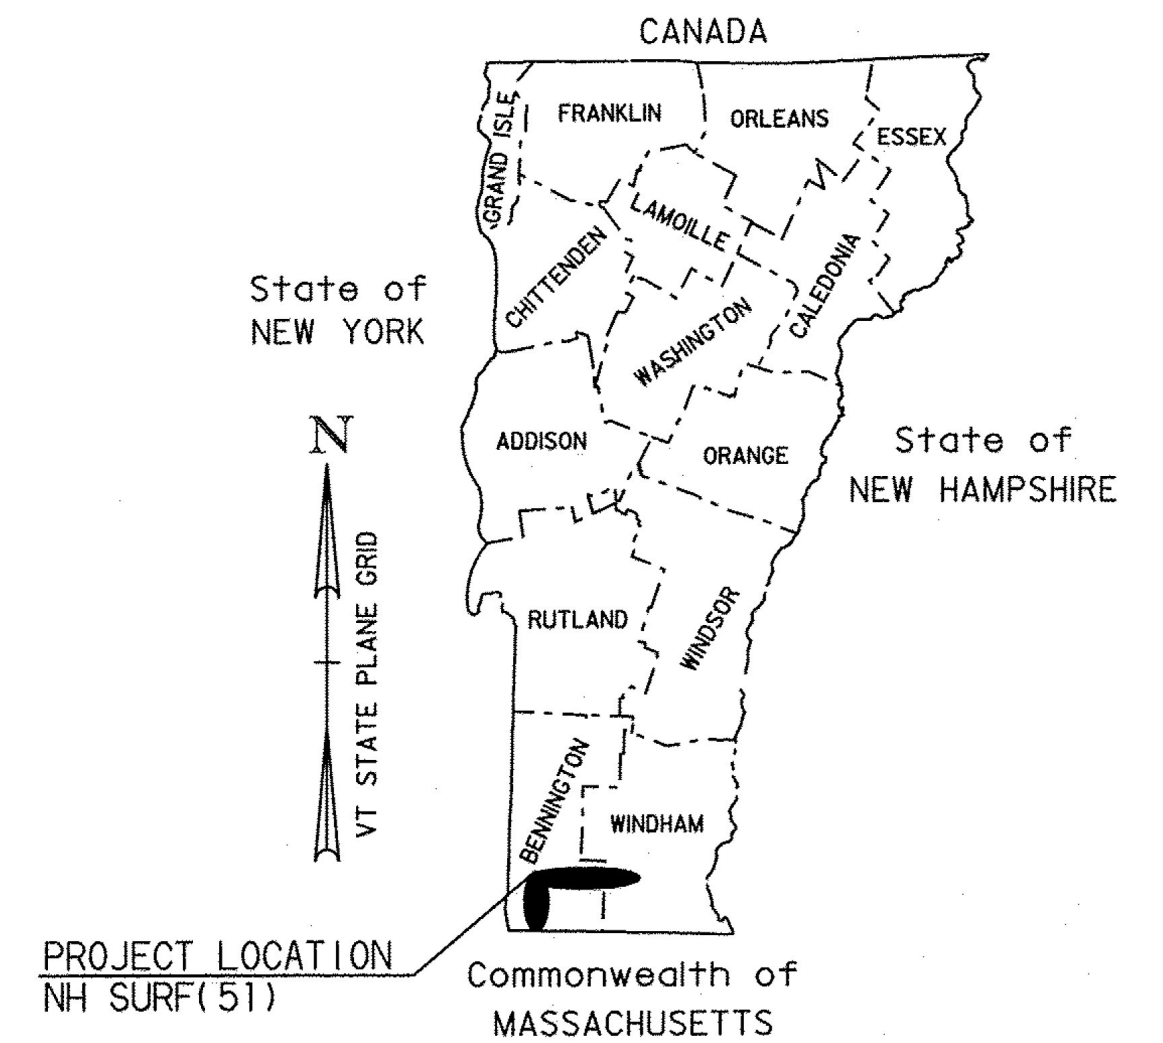


Record Plans
Contractor: PECKHAM ROAD CORPORATION
Resident Engineer: CHAD GREENWOOD
Construction Began: AUGUST 3, 2017
Construction Complete: AUGUST 31, 2018
Record Plans By: CHAD GREENWOOD & RYAN GREENE

I hereby certify that all construction required by this set of drawings has been accomplished as indicated herein.

DocuSigned by:
Chad Greenwood Resident Engineer
BB91D1D9E4CE4CA

Date: 8/17/2022

NOTE: Any further information concerning final quantities, amounts or other details relative to this project may be found at Central Files in the electronic archives.

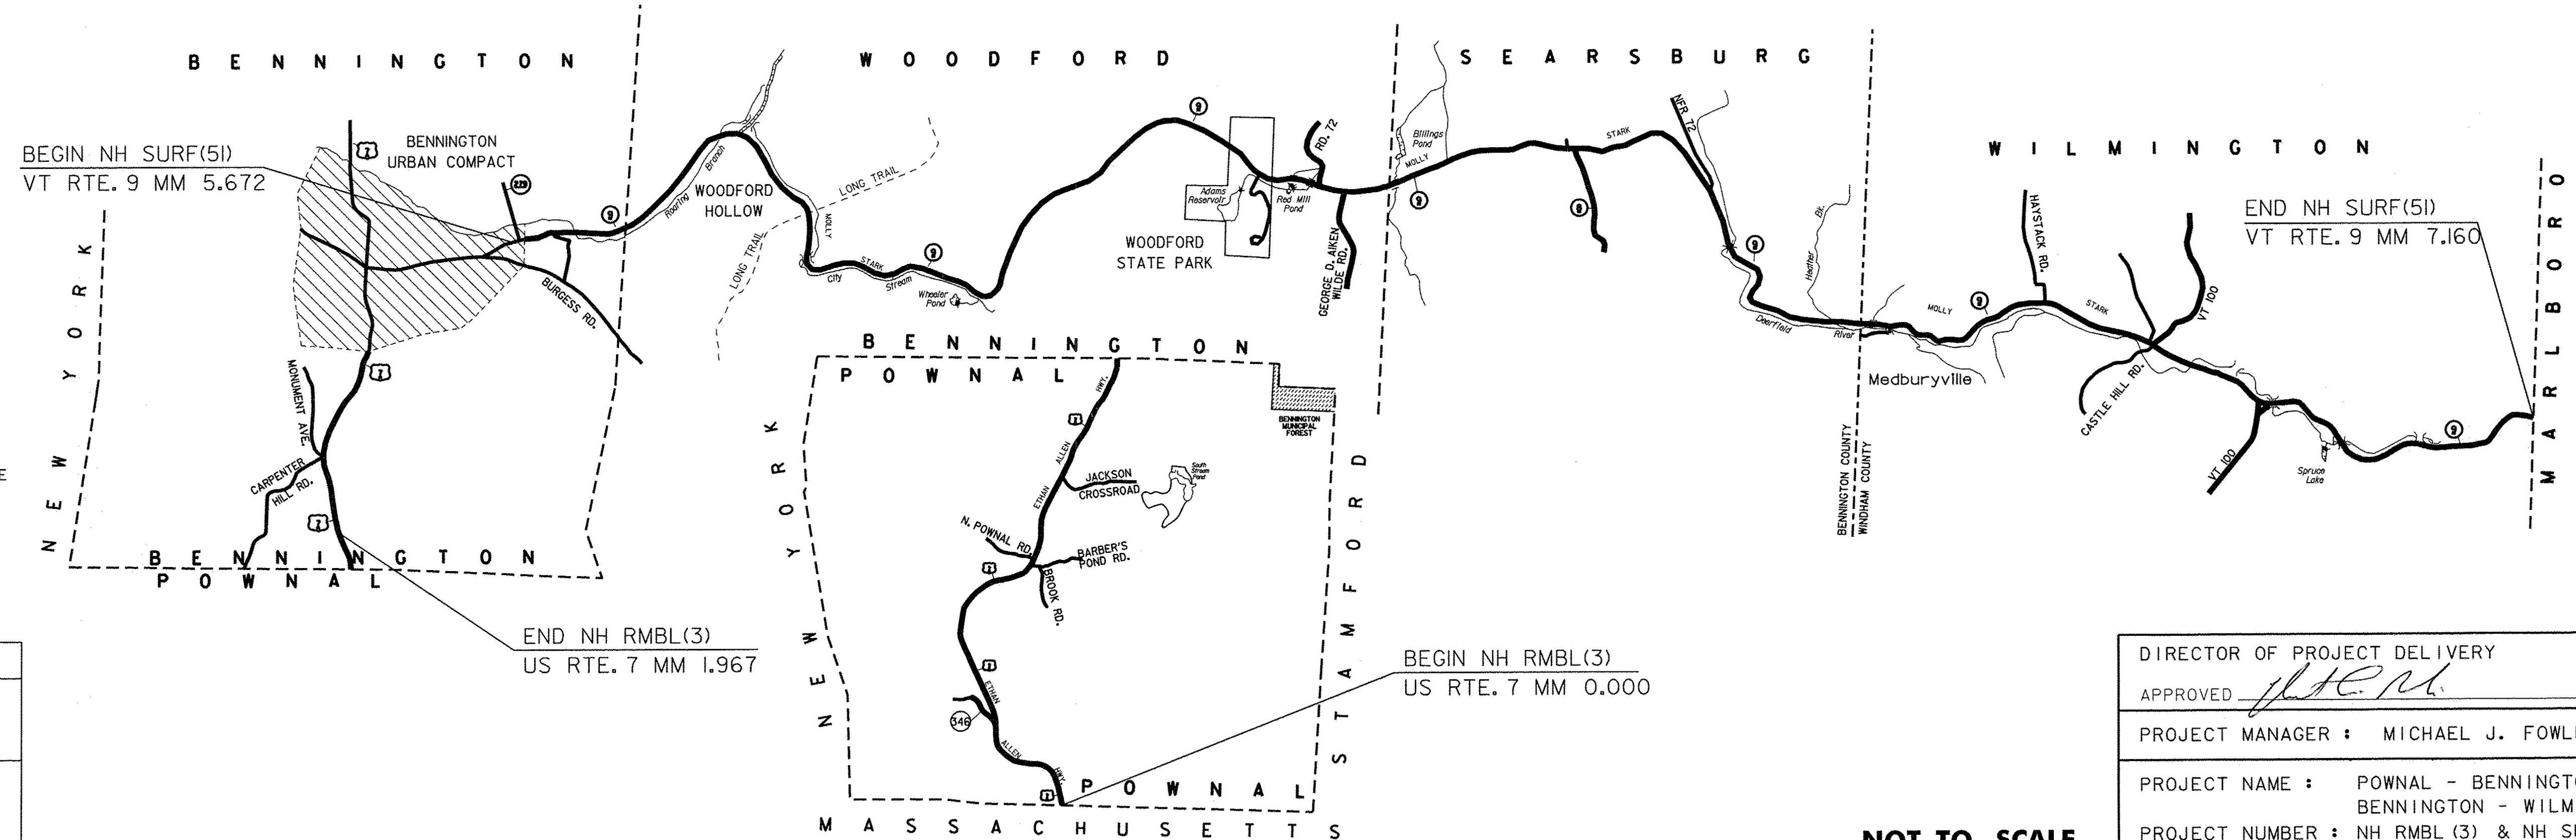

CONSTRUCTION IS TO BE CARRIED ON IN ACCORDANCE WITH THESE PLANS AND THE STANDARD SPECIFICATIONS FOR CONSTRUCTION DATED 2011, AS APPROVED BY THE FEDERAL HIGHWAY ADMINISTRATION ON JULY 20, 2011 FOR USE ON THIS PROJECT, INCLUDING ALL SUBSEQUENT REVISIONS AND SUCH REVISED SPECIFICATIONS AND SPECIAL PROVISIONS AS ARE INCORPORATED IN THESE PLANS.

QUALITY ASSURANCE PROGRAM : LEVEL I
SURVEYED BY : N/A
SURVEYED DATE : N/A
DATUM
VERTICAL: N/A
HORIZONTAL: N/A

NOT TO SCALE

DIRECTOR OF PROJECT DELIVERY	APPROVED: <i>[Signature]</i> DATE 3/8/2017
PROJECT MANAGER : MICHAEL J. FOWLER, P.E.	
PROJECT NAME : POWNAL - BENNINGTON & BENNINGTON - WILMINGTON	
PROJECT NUMBER : NH RMBL (3) & NH SURF (51)	
SHEET 1 OF 63 SHEETS	