
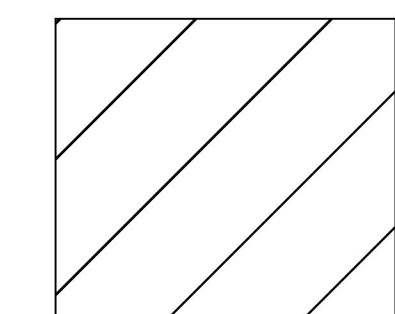


DURABLE 4 INCH WHITE LINE (OPTION BID ITEM)  
 (ALL LINES WILL INCLUDE EDGE LINE BREAKS AND RADIUS FOR TOWN HIGHWAYS)  
 MM 2.500 - MM 7.500 LT & RT  
 MM 2.500 - 4.787 DASHED RT

DURABLE 4 INCH YELLOW LINE (OPTION BID ITEM)  
 (ALL LINES WILL INCLUDE C/L BREAKS FOR TOWN HIGHWAYS)  
 MM 2.500 - MM 6.990 SOLID LT & RT  
 MM 6.990 - MM 7.500 SOLID LT & RT

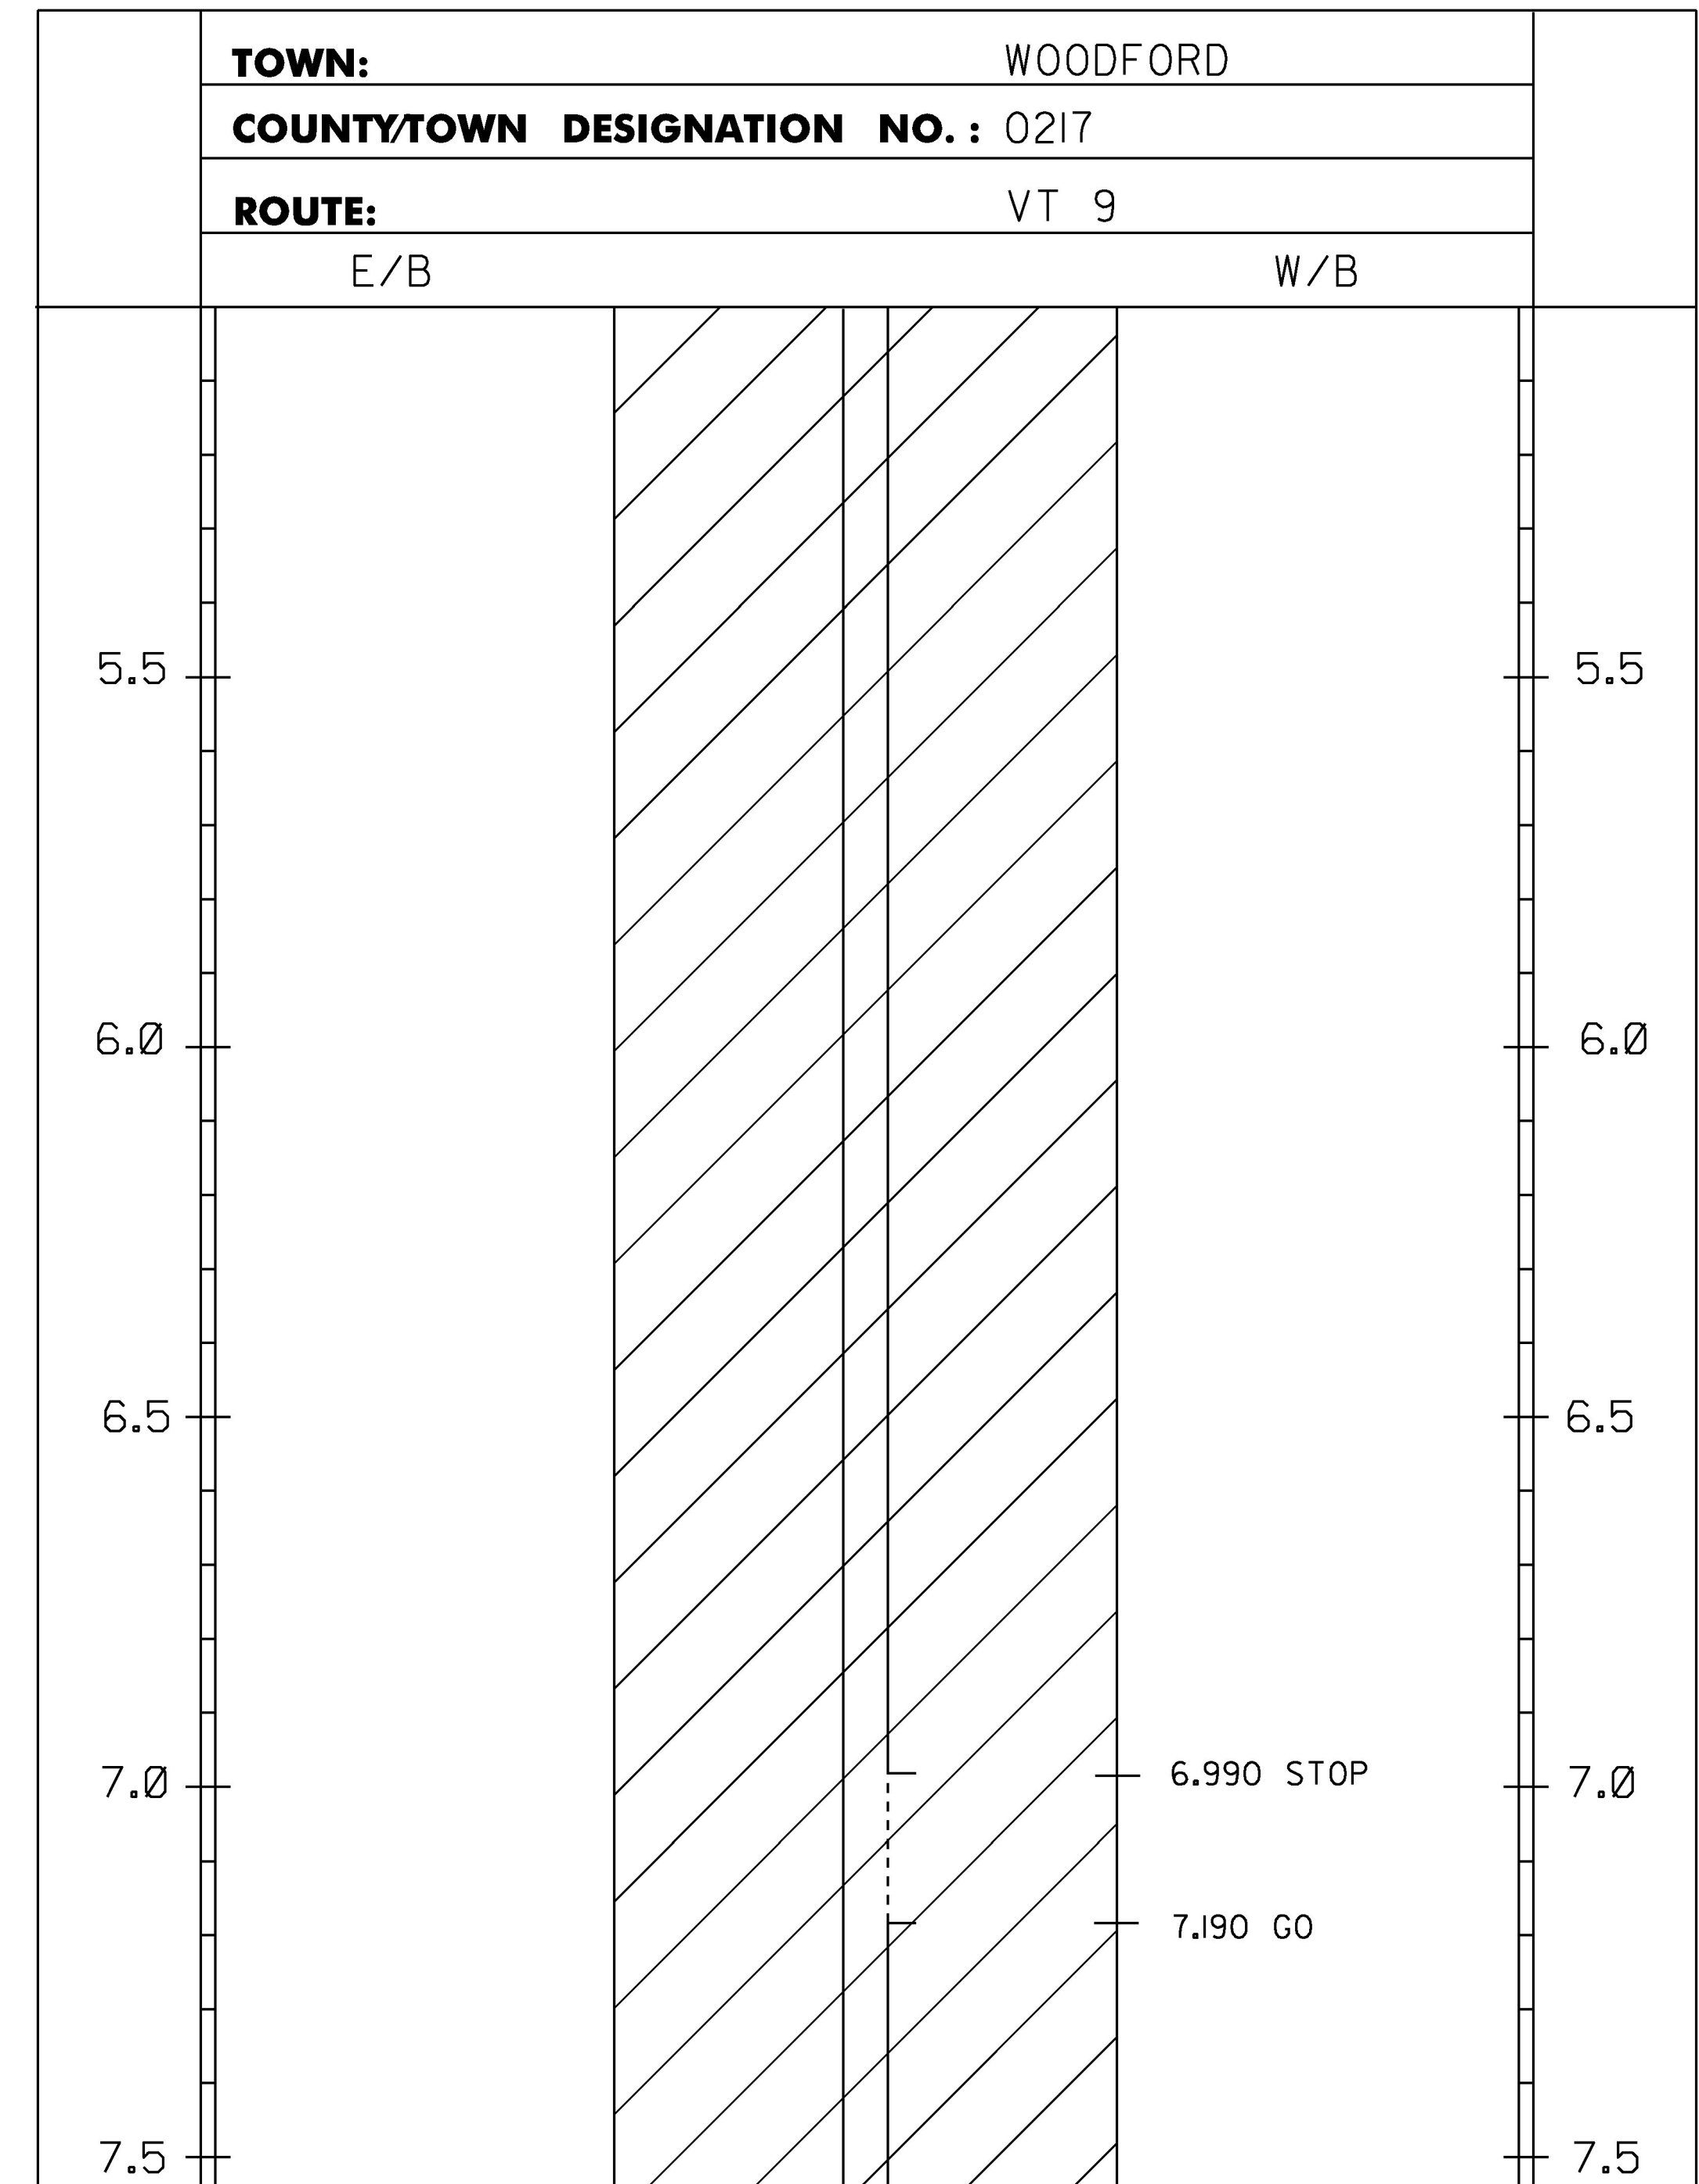

PROJECT AREA

LEGEND  
 TWBH-THROUGHWAY BEGINS HERE  
 TWEH-THROUGHWAY ENDS HERE  
 SHB-STATE HIGHWAY BEGINS  
 SHE-STATE HIGHWAY ENDS  
 SL-SPEED LIMIT  
 T/L-TOWN LINE

NOTES:  
 1. THIS SHEET TO BE USED FOR THE LAYOUT OF ALL CENTERLINE PAVEMENT MARKINGS.  
 THE ENGINEER MAY CONTACT KEITH SWEET, PAVEMENT MARKING SUPERVISOR AT  
 (802) 828-5573 FOR ASSISTANCE LAYING OUT THE CENTERLINE DURING CONSTRUCTION.

**NOT TO SCALE**

PROJECT NAME:	BENNINGTON-WILMINGTON
PROJECT NUMBER:	NH SURF (5I)
FILE NAME: p14v201Bennington-Wilmington.dg	PLOT DATE: 28-MAR-2017
PROJECT LEADER: M. FOWLER	DRAWN BY: N. PAPPAS
DESIGNED BY: N. PAPPAS	CHECKED BY: M. FOWLER
LAYOUT SHEET 2	SHEET 21 OF 64