


CHANGING ELEVATION OF SEWER MANHOLES  
 WILMINGTON:  
 MM 2.042 LT

TEMPORARY 4 INCH WHITE LINE, PAINT &  
 DURABLE 4 INCH WHITE LINE (OPTION BID ITEM)  
 (ALL LINES WILL INCLUDE EDGE LINE BREAKS AND  
 RADIUS FOR TOWN HIGHWAYS)  
 WILMINGTON:  
 MM 1.761 - 2.046 EDGE LINE LT & RT


TEMPORARY 4 INCH YELLOW LINE, PAINT &  
 DURABLE 4 INCH YELLOW LINE (OPTION BID ITEM)  
 (ALL LINES WILL INCLUDE C/L BREAKS FOR  
 TOWN HIGHWAYS)  
 WILMINGTON:  
 MM 1.761 - 2.046 DOUBLE SOLID C/L  
 MM 1.901 DOUBLE SOLID LT TH-5

TEMPORARY 24 INCH STOP BAR, PAINT &  
 DURABLE 24 INCH STOP BAR (OPTION BID ITEM)  
 WILMINGTON:  
 MM 1.090 LT TH-5

TEMPORARY LETTER OR SYMBOL, PAINT &  
 DURABLE LETTER OR SYMBOL (OPTION BID ITEM)  
 WILMINGTON:  
 MM 1.091 LT - "STOP" (4 EACH)

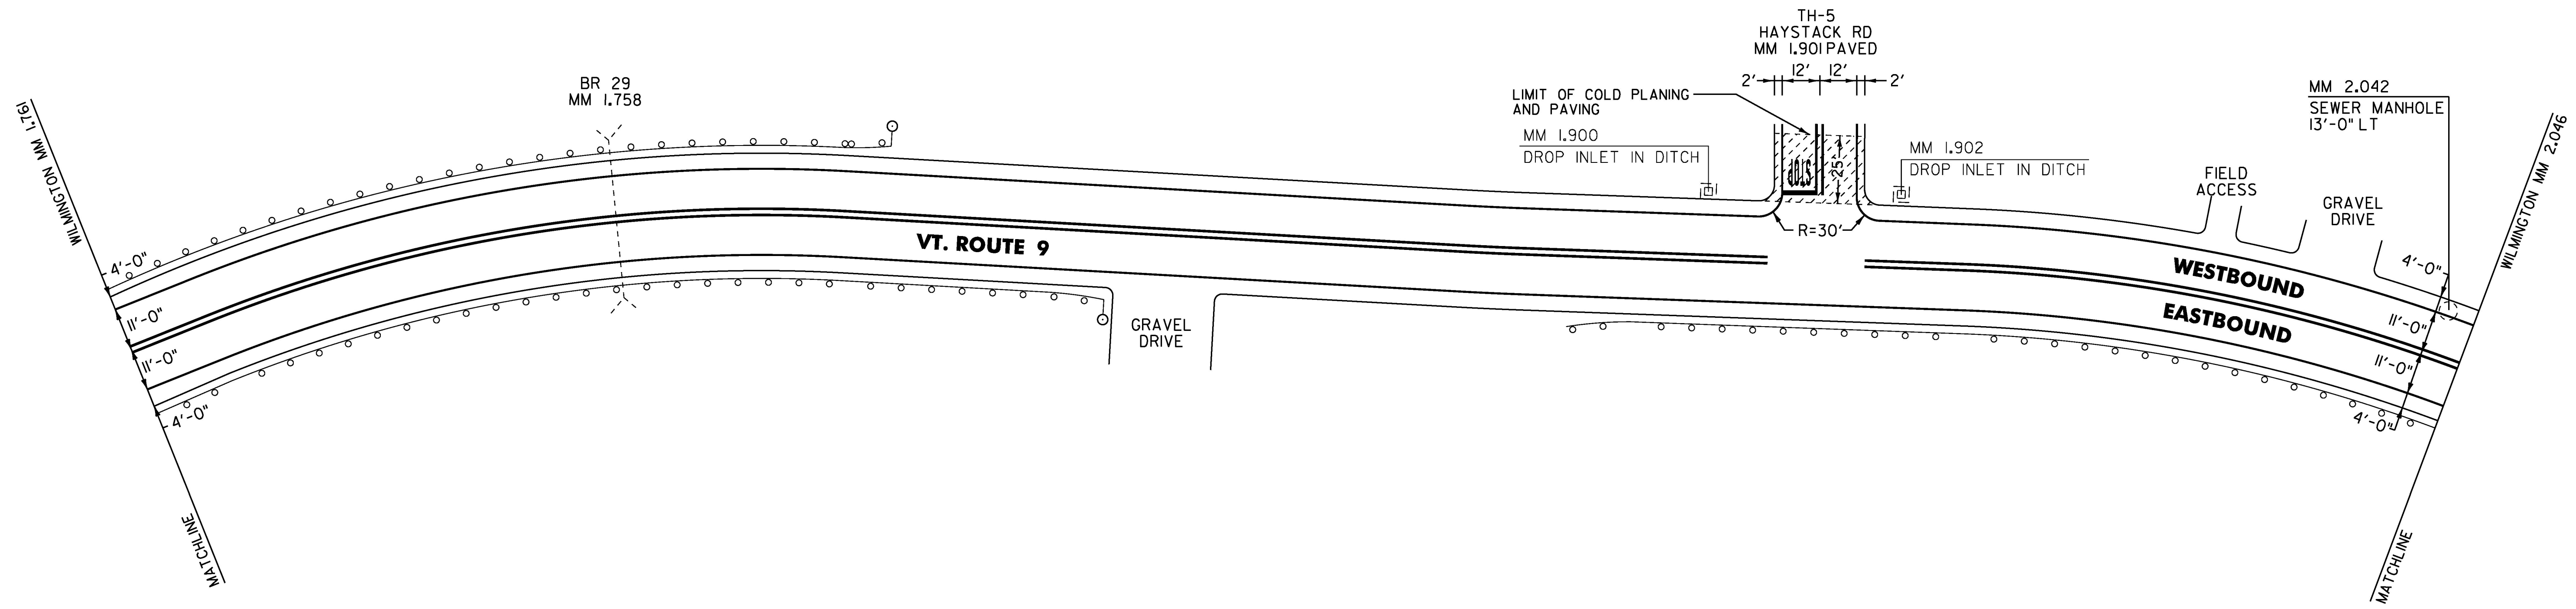

LEGEND: COLD PLANE AREA

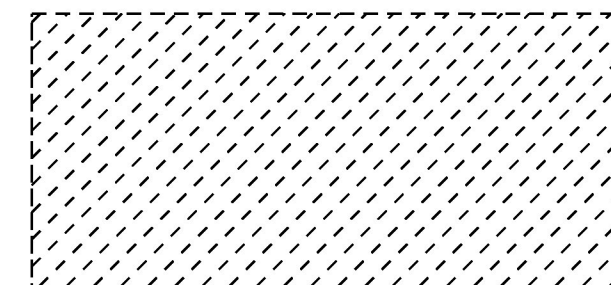

NOT TO SCALE

PROJECT NAME:	BENNINGTON-WILMINGTON
PROJECT NUMBER:	NH SURF (51)
FILE NAME:	p14v201Bennington-Wilmington.dwg
PROJECT LEADER:	M. FOWLER
DESIGNED BY:	N. PAPPAS
LAYOUT SHEET:	13
DATE:	28-MAR-2017
DRAWN BY:	N. PAPPAS
CHECKED BY:	M. FOWLER
SHEET:	32 OF 64