
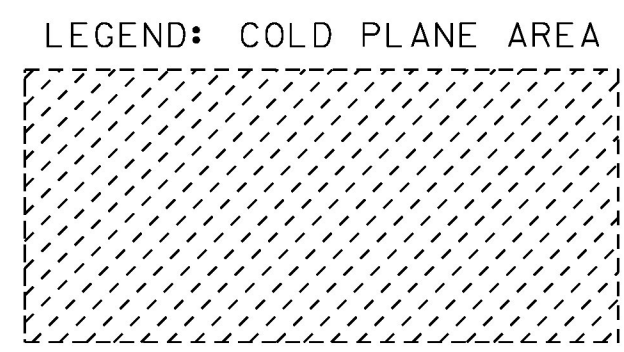


CHANGING ELEVATION OF SEWER MANHOLES
 WILMINGTON:
 MM 2.178 LT
 MM 2.228 LT
 MM 2.311 LT
 MM 2.344 LT

TEMPORARY 4 INCH WHITE LINE, PAINT &
 DURABLE 4 INCH WHITE LINE (OPTION BID ITEM)
 (ALL LINES WILL INCLUDE EDGE LINE BREAKS AND
 RADIUS FOR TOWN HIGHWAYS)
 WILMINGTON:
 MM 2.046 - 2.349 EDGE LINE LT & RT

TEMPORARY 4 INCH YELLOW LINE, PAINT &
 DURABLE 4 INCH YELLOW LINE (OPTION BID ITEM)
 (ALL LINES WILL INCLUDE C/L BREAKS FOR
 TOWN HIGHWAYS)
 WILMINGTON:
 MM 2.046 - 2.349 DOUBLE SOLID C/L

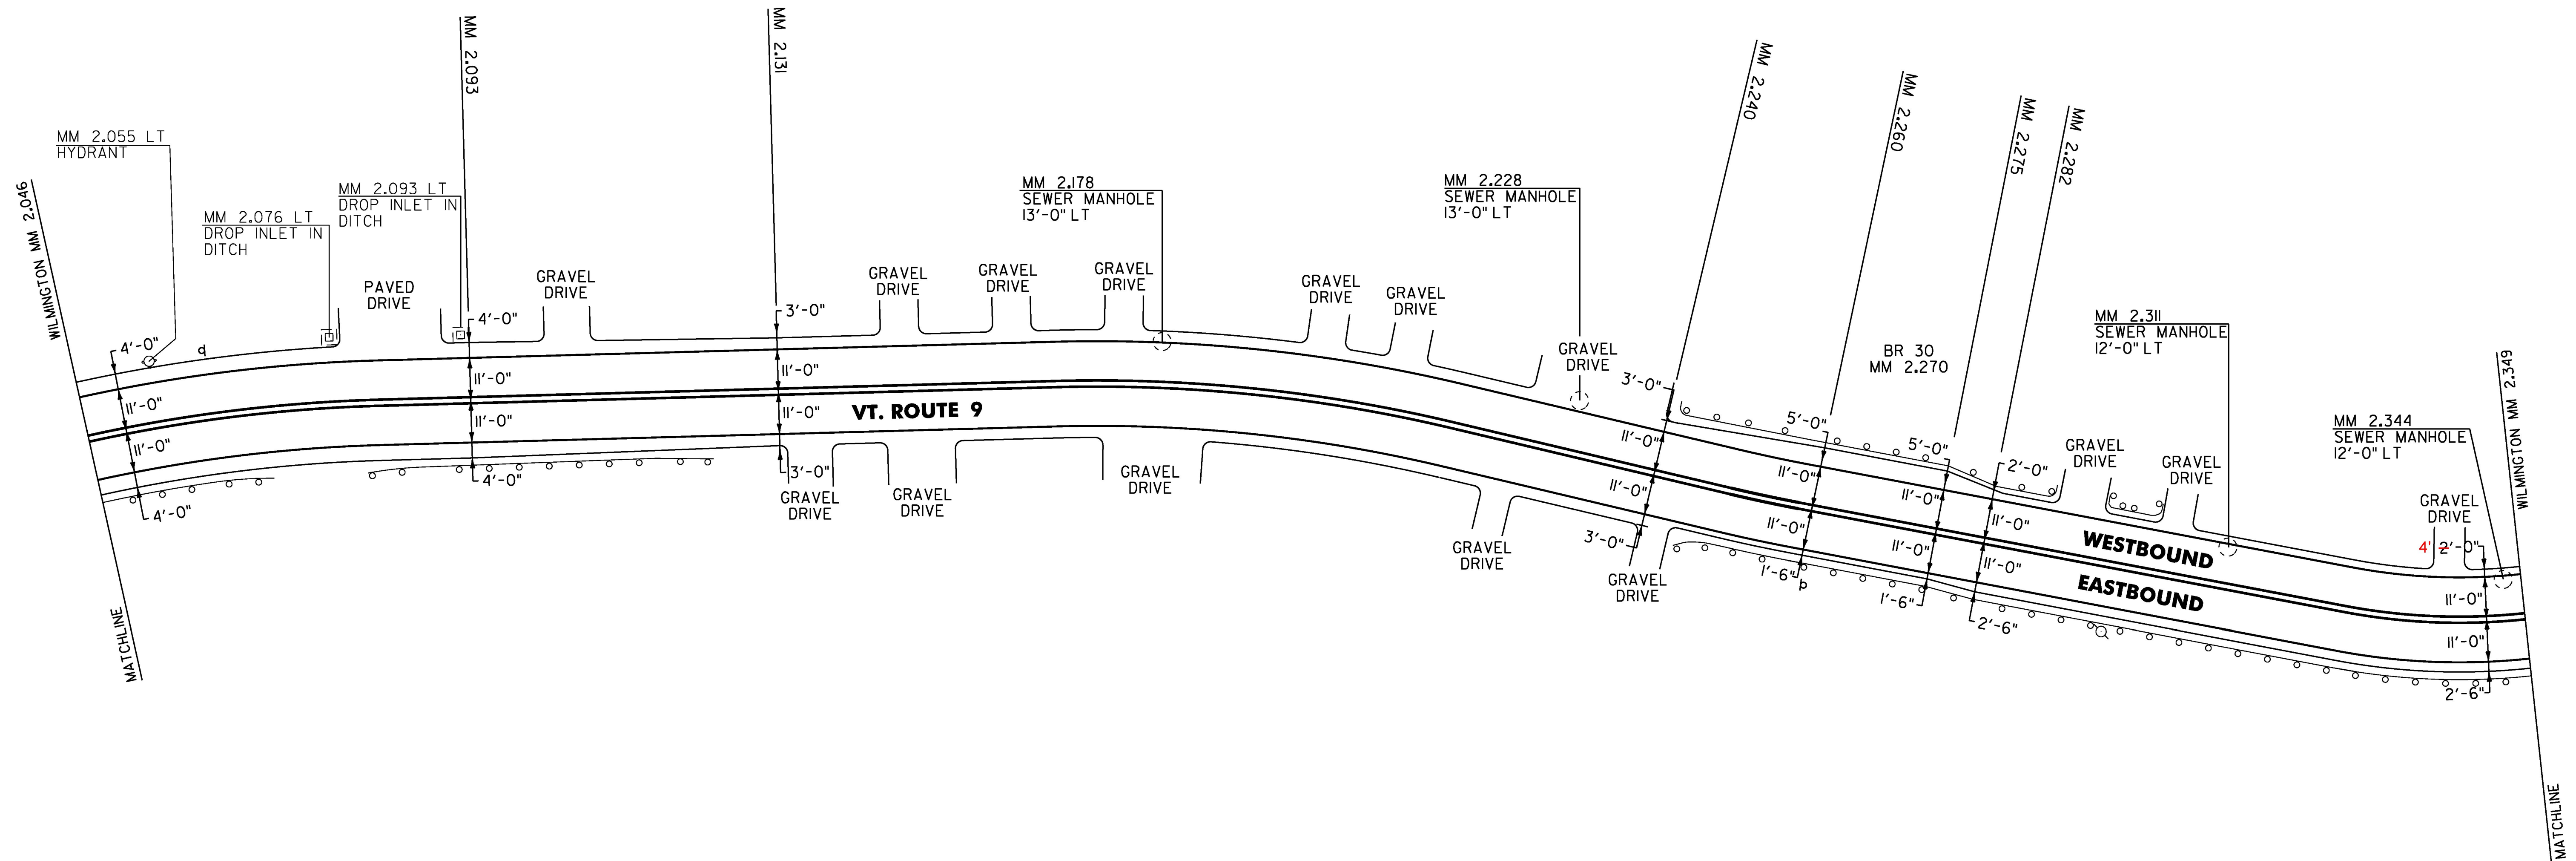

NOT TO SCALE

PROJECT NAME:	BENNINGTON-WILMINGTON
PROJECT NUMBER:	NH SURF (51)
FILE NAME: p14v201Bennington-Wilmington.dg	PLOT DATE: 28-MAR-2017
PROJECT LEADER: M. FOWLER	DRAWN BY: N. PAPPAS
DESIGNED BY: N. PAPPAS	CHECKED BY: M. FOWLER
LAYOUT SHEET 14	SHEET 33 OF 64