

CHANGING ELEVATION OF DROP INLETS,
CATCH BASINS, OR MANHOLES

WILMINGTON:
MM 2.371 LT
MM 2.514 LT
MM 2.580 LT
MM 2.617 LT

CHANGING ELEVATION OF SEWER MANHOLES

WILMINGTON:
MM 2.386 LT
MM 2.481 LT

TEMPORARY 4 INCH WHITE LINE, PAINT &
DURABLE 4 INCH WHITE LINE (OPTION BID ITEM)
(ALL LINES WILL INCLUDE EDGE LINE BREAKS AND
RADIUS FOR TOWN HIGHWAYS)


WILMINGTON:
MM 2.439 - 2.652 EDGE LINE LT & RT

TEMPORARY 4 INCH YELLOW LINE, PAINT &
DURABLE 4 INCH YELLOW LINE (OPTION BID ITEM)
(ALL LINES WILL INCLUDE C/L BREAKS FOR
TOWN HIGHWAYS)


WILMINGTON:
MM 2.439 - 2.652 C/L SOLID LT & RT

TEMPORARY 8 INCH WHITE LINE, PAINT &
DURABLE 8 INCH WHITE LINE (OPTION BID ITEM)

WILMINGTON:
MM 2.583 - 2.585 LT NO PARKING FIRE HYDRANT

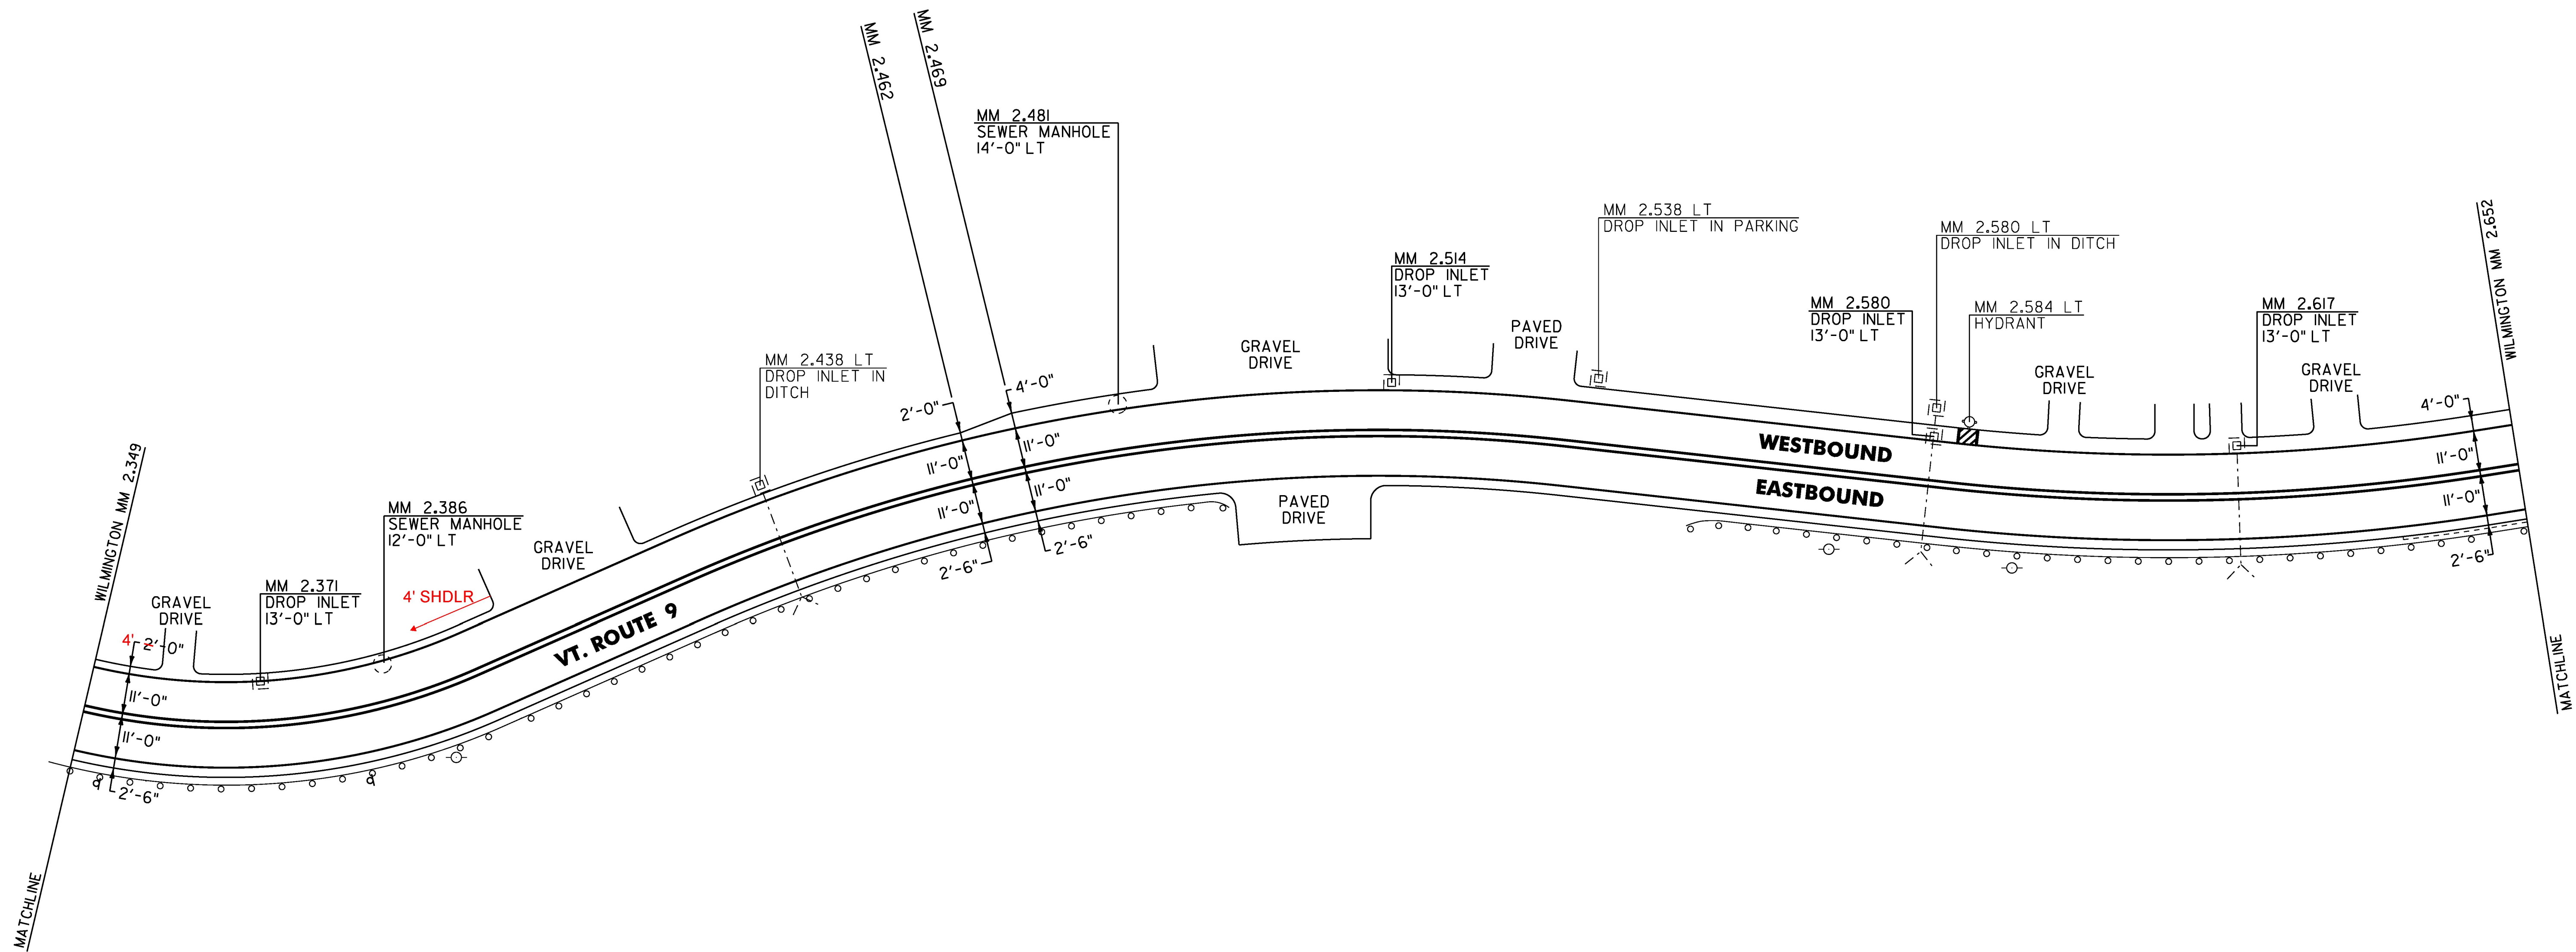

LEGEND: COLD PLANE AREA

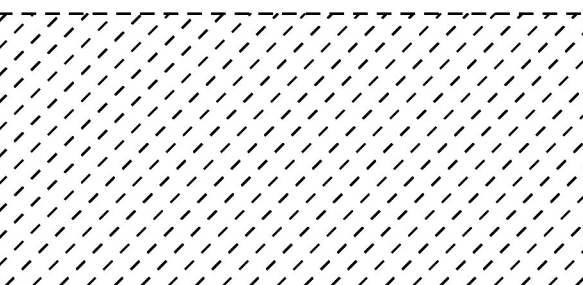

NOT TO SCALE

PROJECT NAME:	BENNINGTON-WILMINGTON
PROJECT NUMBER:	NH SURF (5I)
FILE NAME:	pl4v201Bennington-Wilmington.dgn
PROJECT LEADER:	M. FOWLER
DESIGNED BY:	N. PAPPAS
LAYOUT SHEET	15
DATE:	28-MAR-2017
DRAWN BY:	N. PAPPAS
CHECKED BY:	M. FOWLER
SHEET	34 OF 64