

CHANGING ELEVATION OF DROP INLETS, CATCH BASINS, OR MANHOLES

WILMINGTON:
MM 2.960 LT
MM 2.968 RT
MM 2.968 LT
MM 3.006 RT
MM 3.010 LT

CHANGING ELEVATION OF SEWER MANHOLES

WILMINGTON:
MM 2.960 LT
MM 2.965 LT

ADJUST ELEVATION OF VALVE BOX

WILMINGTON:
MM 3.040 RT
MM 3.018 RT

TEMPORARY 4 INCH WHITE LINE, PAINT & DURABLE 4 INCH WHITE LINE (OPTION BID ITEM) (ALL LINES WILL INCLUDE EDGE LINE BREAKS AND RADIUS FOR TOWN HIGHWAYS)

WILMINGTON:
MM 2.955 - 3.049 EDGE LINE LT & RT

TEMPORARY 4 INCH YELLOW LINE, PAINT & DURABLE 4 INCH YELLOW LINE (OPTION BID ITEM) (ALL LINES WILL INCLUDE C/L BREAKS FOR TOWN HIGHWAYS)

WILMINGTON:
MM 2.955 - 3.049 C/L SOLID LT & RT

TEMPORARY 8 INCH WHITE LINE, PAINT & DURABLE 8 INCH WHITE LINE (OPTION BID ITEM)


WILMINGTON:
MM 2.957 - 2.960 RT NO PARKING FIRE HYDRANT
MM 3.011 - 3.015 LT NO PARKING
MM 3.017 - 3.023 RT NO PARKING / FIRE HYDRANT
MM 3.031 RT (2)
MM 3.033 RT
MM 3.048 LT

TEMPORARY LETTER OR SYMBOL, PAINT & DURABLE LETTER OR SYMBOL (OPTION BID ITEM)


WILMINGTON:
MM 3.032 RT - "♿" (1 EACH)

TEMPORARY CROSSWALK MARKING, PAINT & DURABLE CROSSWALK MARKING (OPTION BID ITEM)

WILMINGTON:
MM 3.016

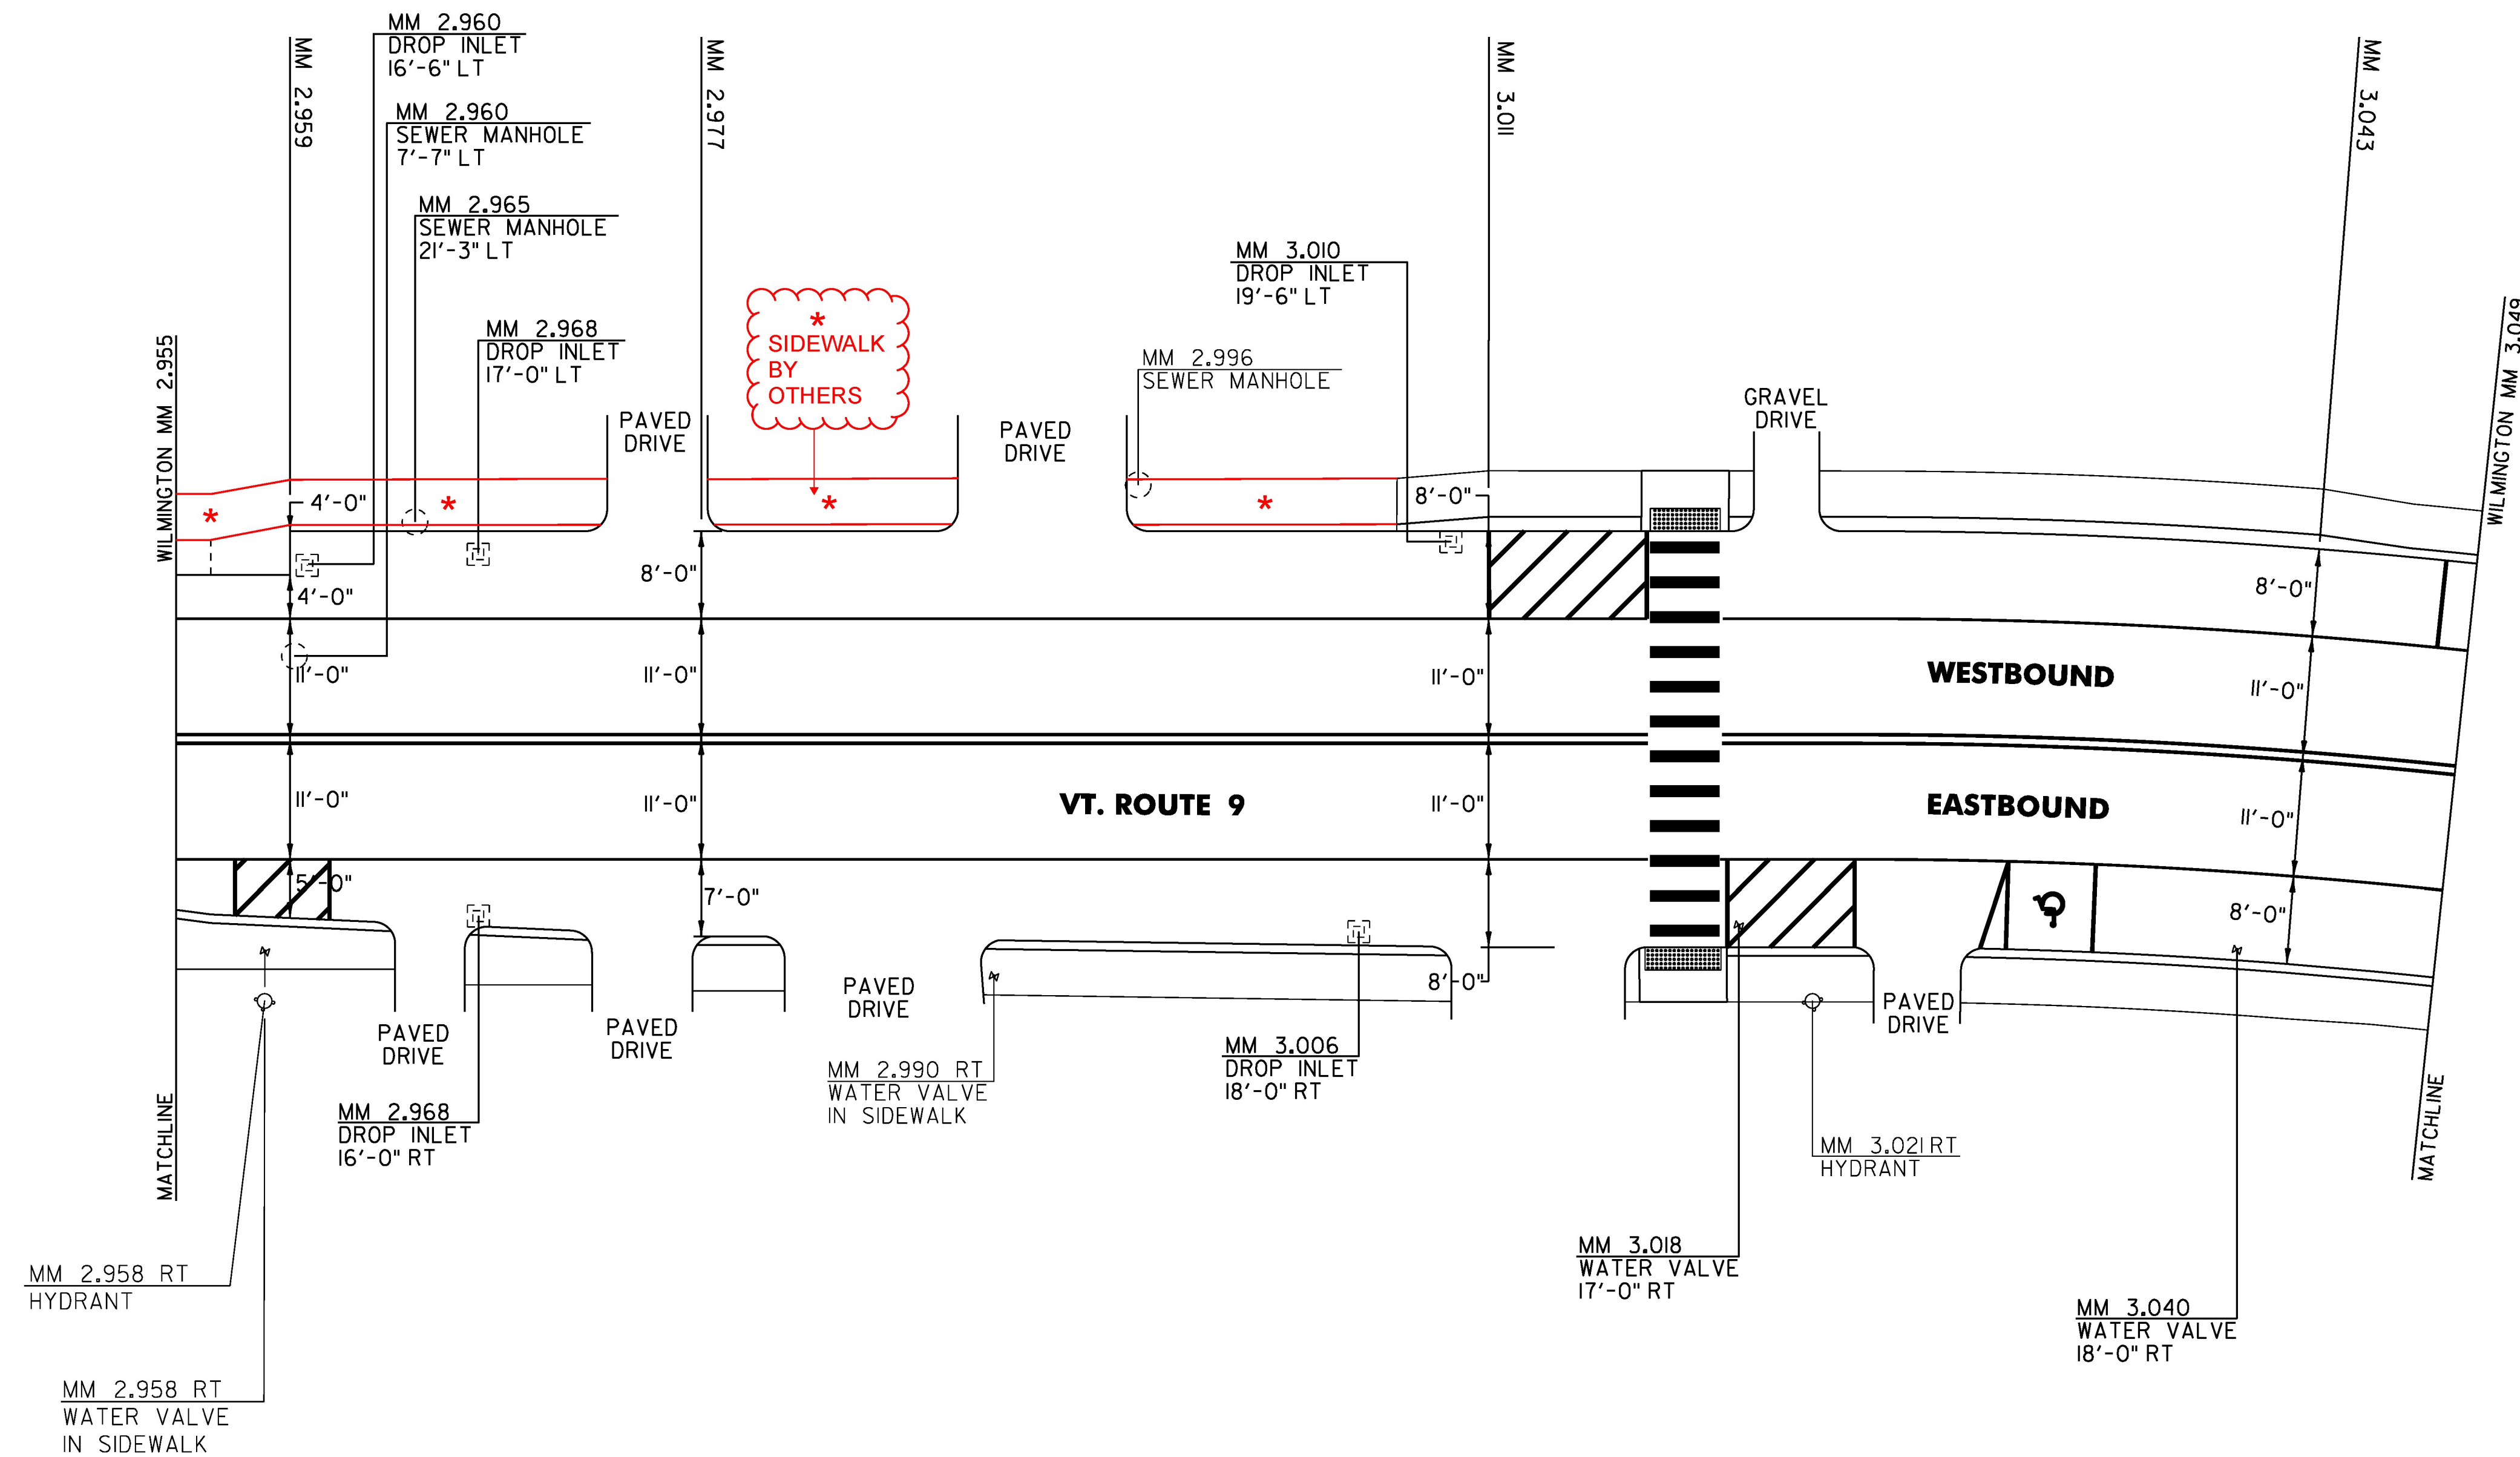

LEGEND: COLD PLANE AREA

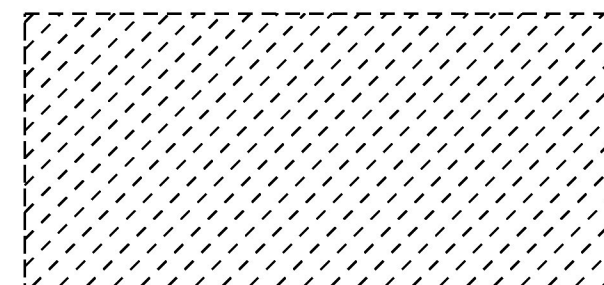

NOT TO SCALE

PROJECT NAME:	BENNINGTON-WILMINGTON
PROJECT NUMBER:	NH SURF (51)
FILE NAME:	p14v201Bennington-Wilmington.dg
PROJECT LEADER:	M. FOWLER
DESIGNED BY:	N. PAPPAS
LAYOUT SHEET 17	
DATE:	28-MAR-2017
DRAWN BY:	N. PAPPAS
CHECKED BY:	M. FOWLER
SHEET	36 OF 64