

CHANGING ELEVATION OF DROP INLETS,  
CATCH BASINS, OR MANHOLES

WILMINGTON:

MM 3.569 RT  
MM 3.582 RT  
MM 3.846 RT

CHANGING ELEVATION OF SEWER MANHOLES

WILMINGTON:

MM 3.570 LT  
MM 3.616 LT  
MM 3.648 RT  
MM 3.745 RT

TEMPORARY 4 INCH WHITE LINE, PAINT &  
DURABLE 4 INCH WHITE LINE (OPTION BID ITEM)  
(ALL LINES WILL INCLUDE EDGE LINE BREAKS AND  
RADIUS FOR TOWN HIGHWAYS)

WILMINGTON:

MM 3.561 - 3.864 EDGE LINE LT & RT  
MM 3.562 RT DRIVE

TEMPORARY 4 INCH YELLOW LINE, PAINT &  
DURABLE 4 INCH YELLOW LINE (OPTION BID ITEM)  
(ALL LINES WILL INCLUDE C/L BREAKS FOR  
TOWN HIGHWAYS)

WILMINGTON:

MM 3.561 - 3.864 C/L SOLD LT & RT  
MM 3.562 RT DRIVE  
MM 3.680 DOUBLE SOLID LT TH-23

TEMPORARY 24 INCH STOP BAR, PAINT &  
DURABLE 24 INCH STOP BAR (OPTION BID ITEM)

WILMINGTON:

MM 3.562 RT DRIVE


MM 3.679 LT TH-23

TEMPORARY LETTER OR SYMBOL, PAINT &  
DURABLE LETTER OR SYMBOL (OPTION BID ITEM)


WILMINGTON:

MM 3.679 LT - "STOP" (4 EACH)

MM 3.572 RT - "STOP" (4 EACH)

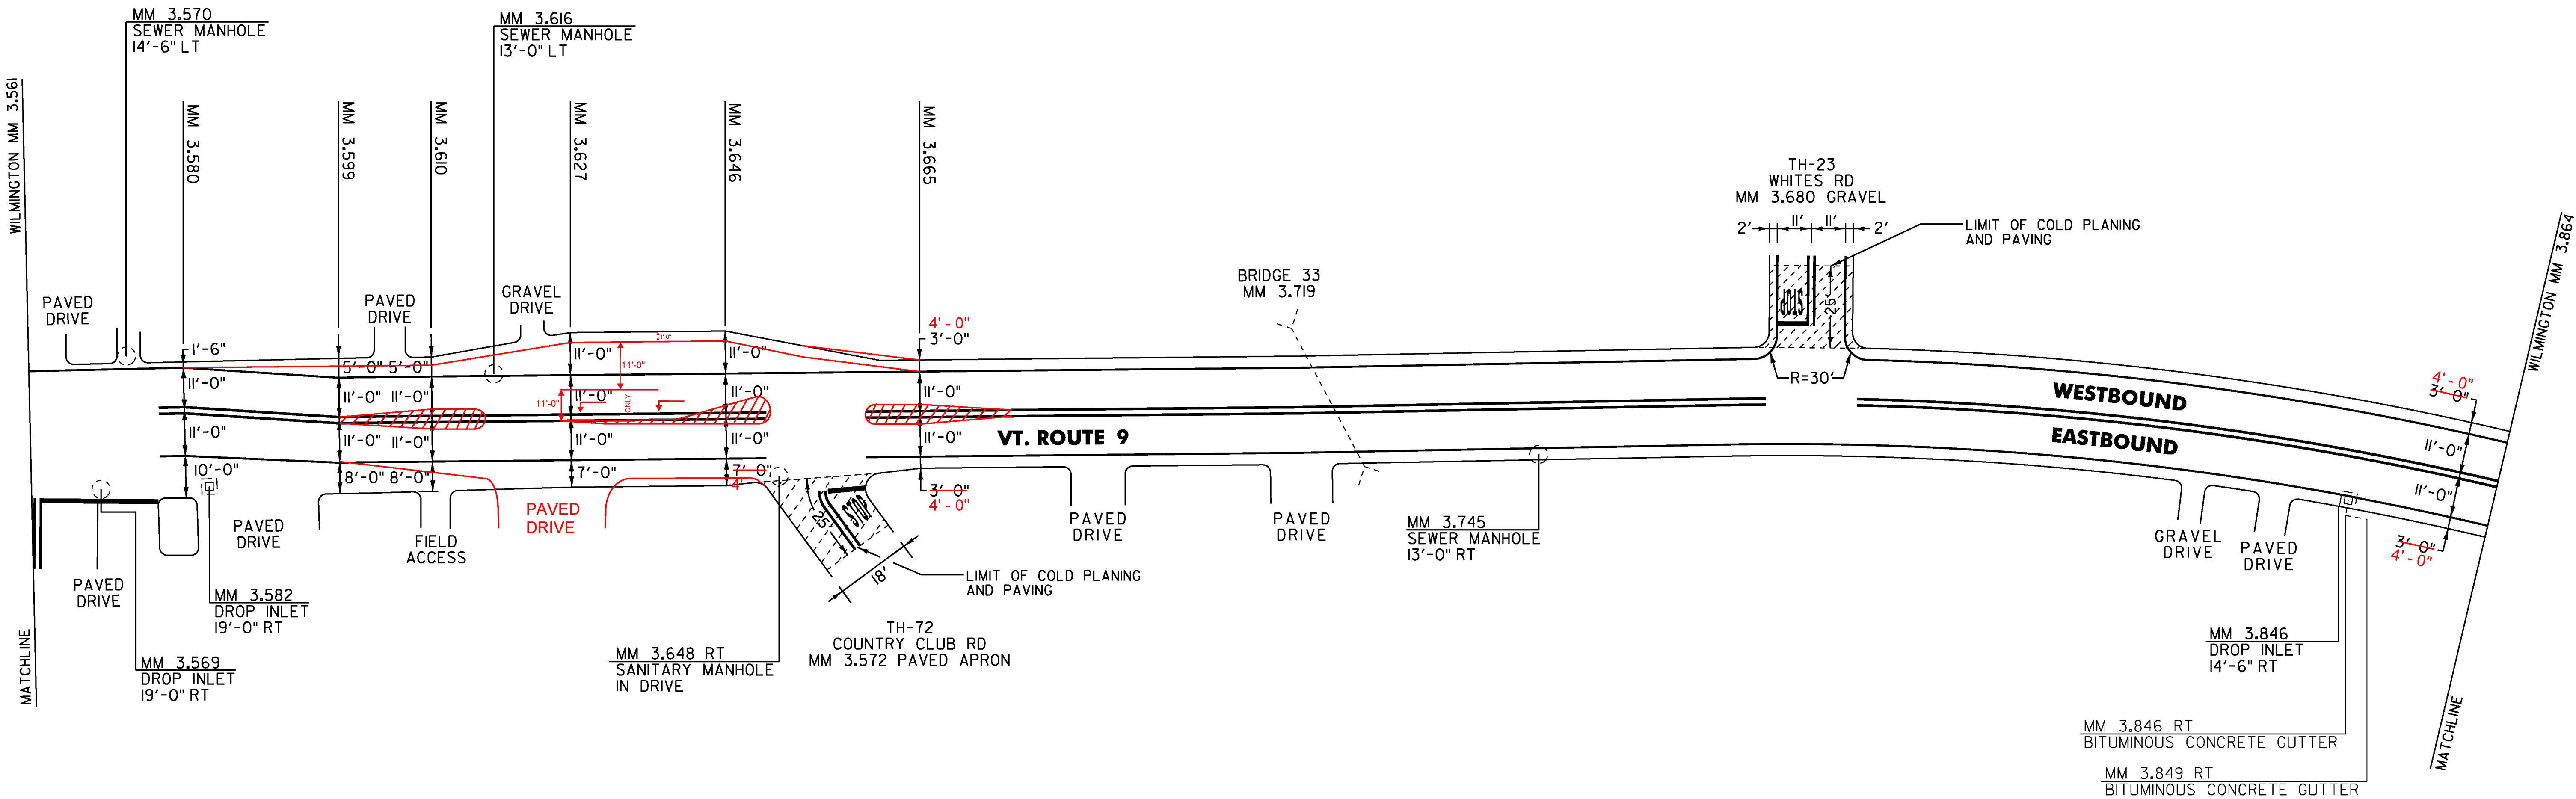

LEGEND: COLD PLANE AREA

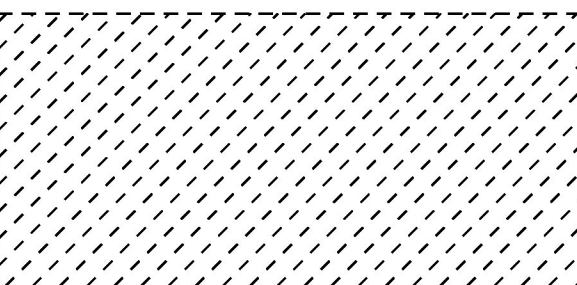

NOT TO SCALE

|                                            |                         |
|--------------------------------------------|-------------------------|
| PROJECT NAME:                              | BENNINGTON-WILMINGTON   |
| PROJECT NUMBER:                            | NH SURF (51)            |
| FILE NAME: pl4v20lBennington-Wilmington.dg | PLLOT DATE: 28-MAR-2017 |
| PROJECT LEADER: M. FOWLER                  | DRAWN BY: N. PAPPAS     |
| DESIGNED BY: N. PAPPAS                     | CHECKED BY: M. FOWLER   |
| LAYOUT SHEET 21                            | SHEET 40 OF 64          |