



CHANGING ELEVATION OF DROP INLETS,
CATCH BASINS, OR MANHOLES
WILMINGTON:
MM 4.635 RT
MM 4.694 RT

TEMPORARY 4 INCH WHITE LINE, PAINT &
DURABLE 4 INCH WHITE LINE (OPTION BID ITEM)
(ALL LINES WILL INCLUDE EDGE LINE BREAKS AND
RADIUS FOR TOWN HIGHWAYS)
WILMINGTON:
MM 4.470 - 4.773 EDGE LINE LT & RT

TEMPORARY 4 INCH YELLOW LINE, PAINT &
DURABLE 4 INCH YELLOW LINE (OPTION BID ITEM)
(ALL LINES WILL INCLUDE C/L BREAKS FOR
TOWN HIGHWAYS)
WILMINGTON:
MM 4.470 - 4.773 C/L SOLD LT & RT
MM 4.537 DOUBLE SOLID LT TH-26

TEMPORARY 24 INCH STOP BAR, PAINT &
DURABLE 24 INCH STOP BAR (OPTION BID ITEM)
WILMINGTON:
MM 4.536 LT TH-26

TEMPORARY LETTER OR SYMBOL, PAINT &
DURABLE LETTER OR SYMBOL (OPTION BID ITEM)
WILMINGTON:
MM 4.536 RT - "STOP" (4 EACH)

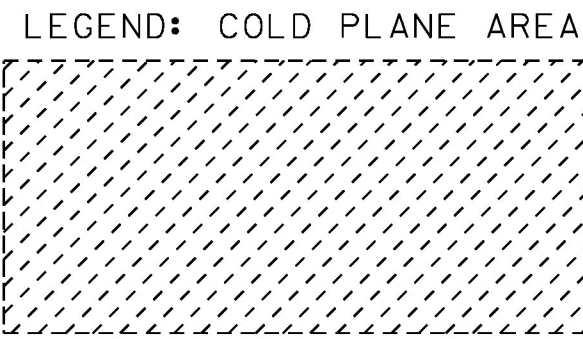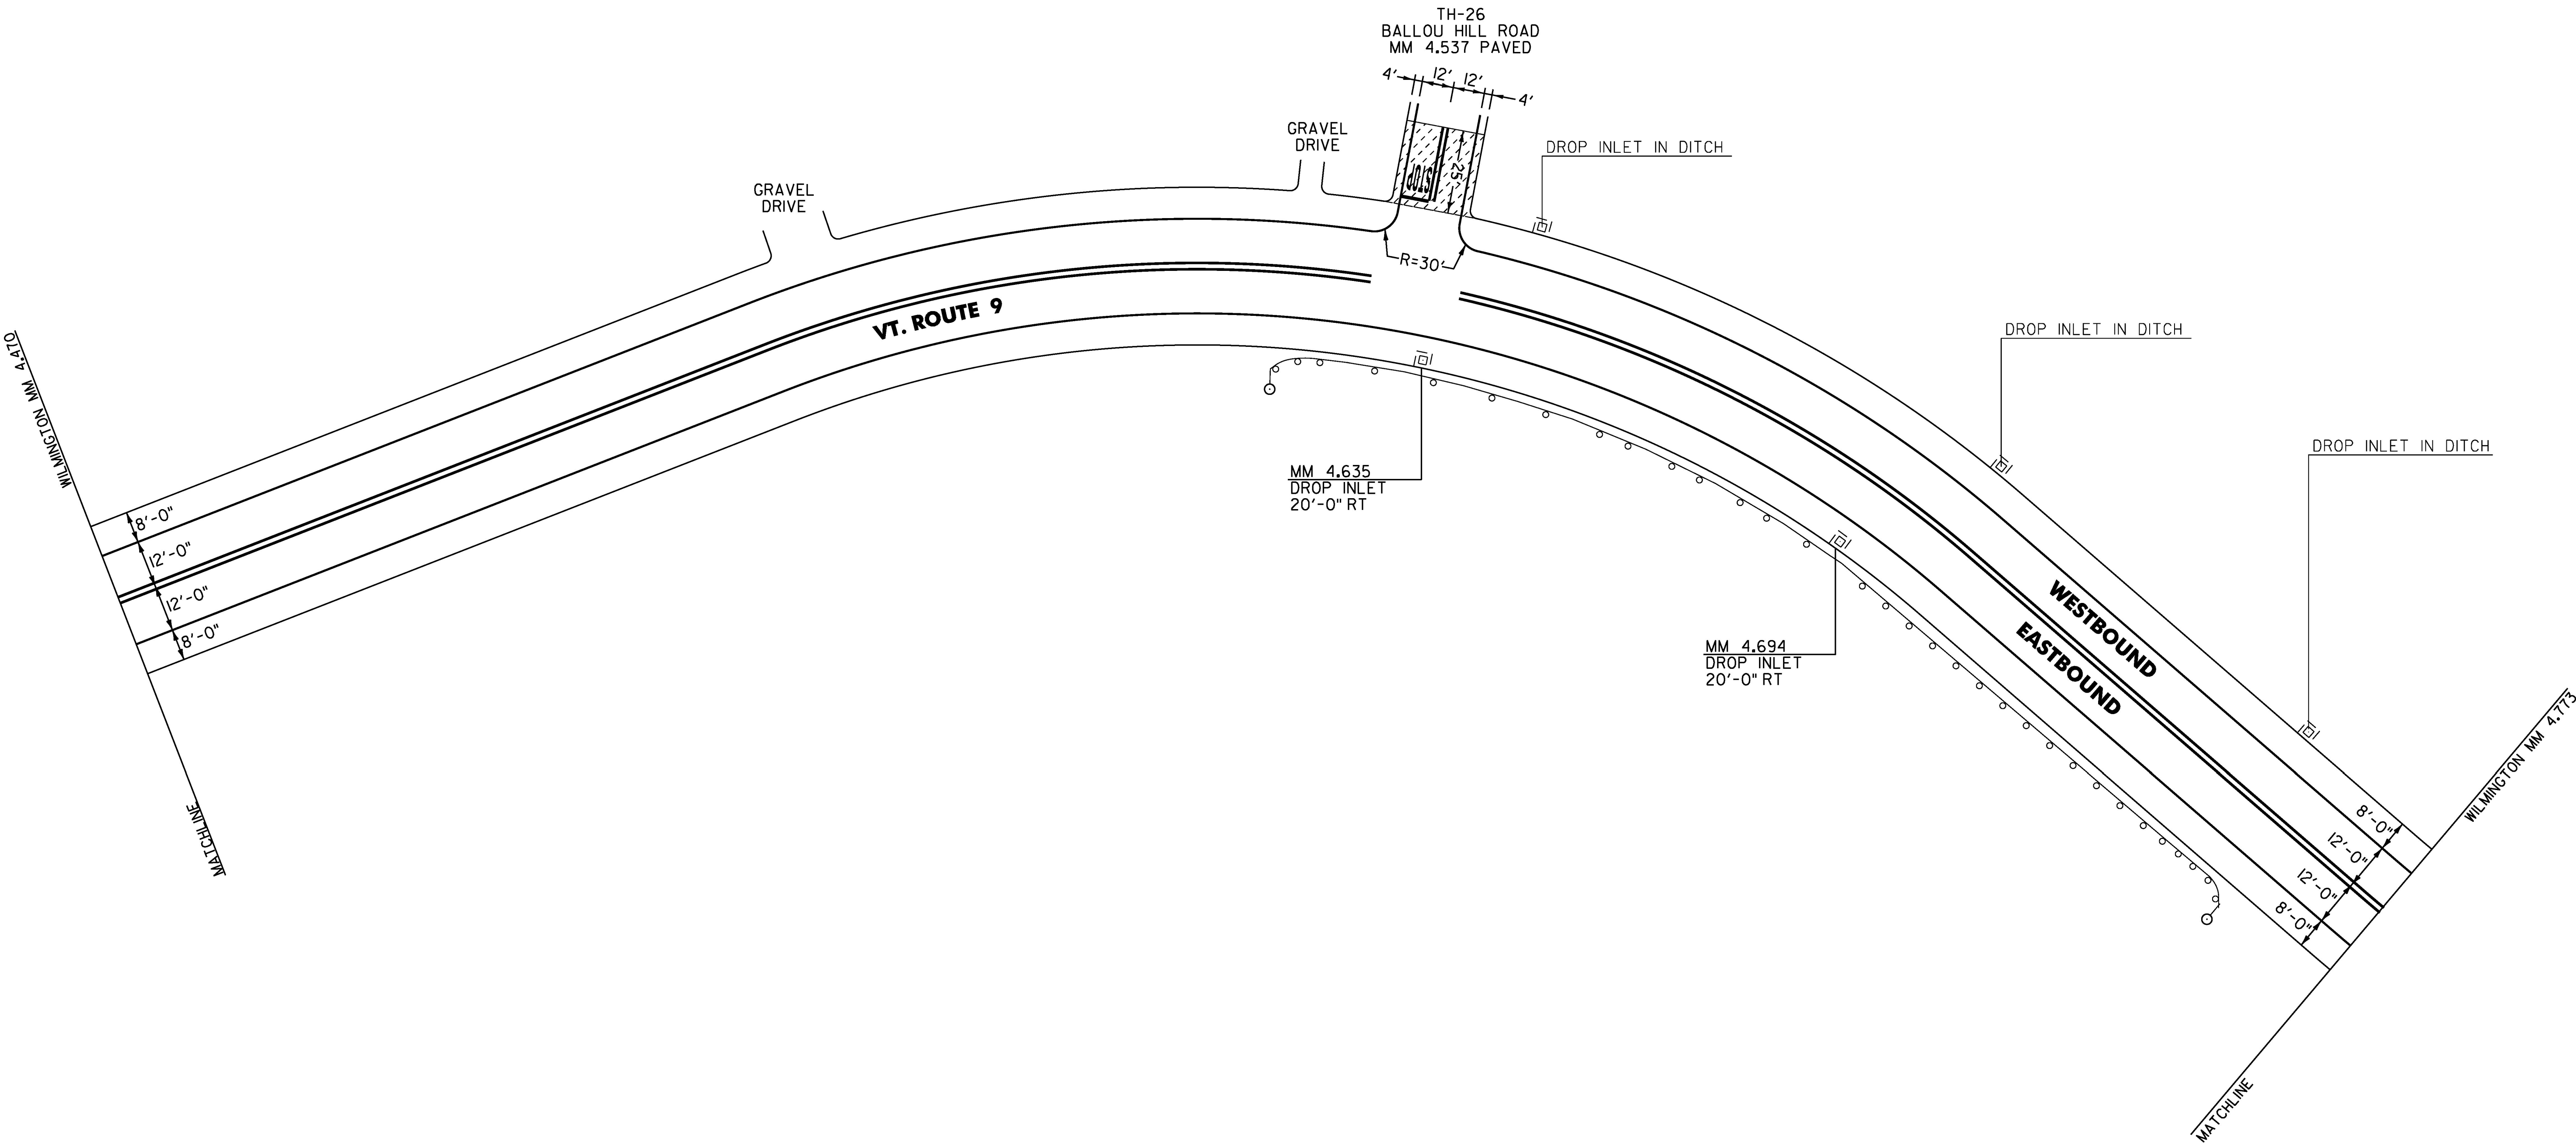

NOT TO SCALE

PROJECT NAME:	BENNINGTON-WILMINGTON
PROJECT NUMBER:	NH SURF (5I)
FILE NAME: pl4v20I Bennington-Wilmington.dgn	DATE: 28-MAR-2017
PROJECT LEADER: M. FOWLER	DRAWN BY: N. PAPPAS
DESIGNED BY: N. PAPPAS	CHECKED BY: M. FOWLER
LAYOUT SHEET 24	SHEET 43 OF 64