



TEMPORARY 4 INCH WHITE LINE, PAINT &  
 DURABLE 4 INCH WHITE LINE (OPTION BID ITEM)  
 (ALL LINES WILL INCLUDE EDGE LINE BREAKS AND  
 RADIUS FOR TOWN HIGHWAYS)  
 WILMINGTON:  
 MM 4.773 - 5.076 EDGE LINE LT & RT

TEMPORARY 4 INCH YELLOW LINE, PAINT &  
 DURABLE 4 INCH YELLOW LINE (OPTION BID ITEM)  
 (ALL LINES WILL INCLUDE C/L BREAKS FOR  
 TOWN HIGHWAYS)  
 WILMINGTON:  
 MM 4.773 - 4.925 C/L SOLD LT & RT  
 MM 4.537 DOUBLE SOLID LT TH-26  
 MM 4.925 - 5.075 SOLID LT & DASHED RT  
 MM 5.075 - 5.076 C/L DASHED

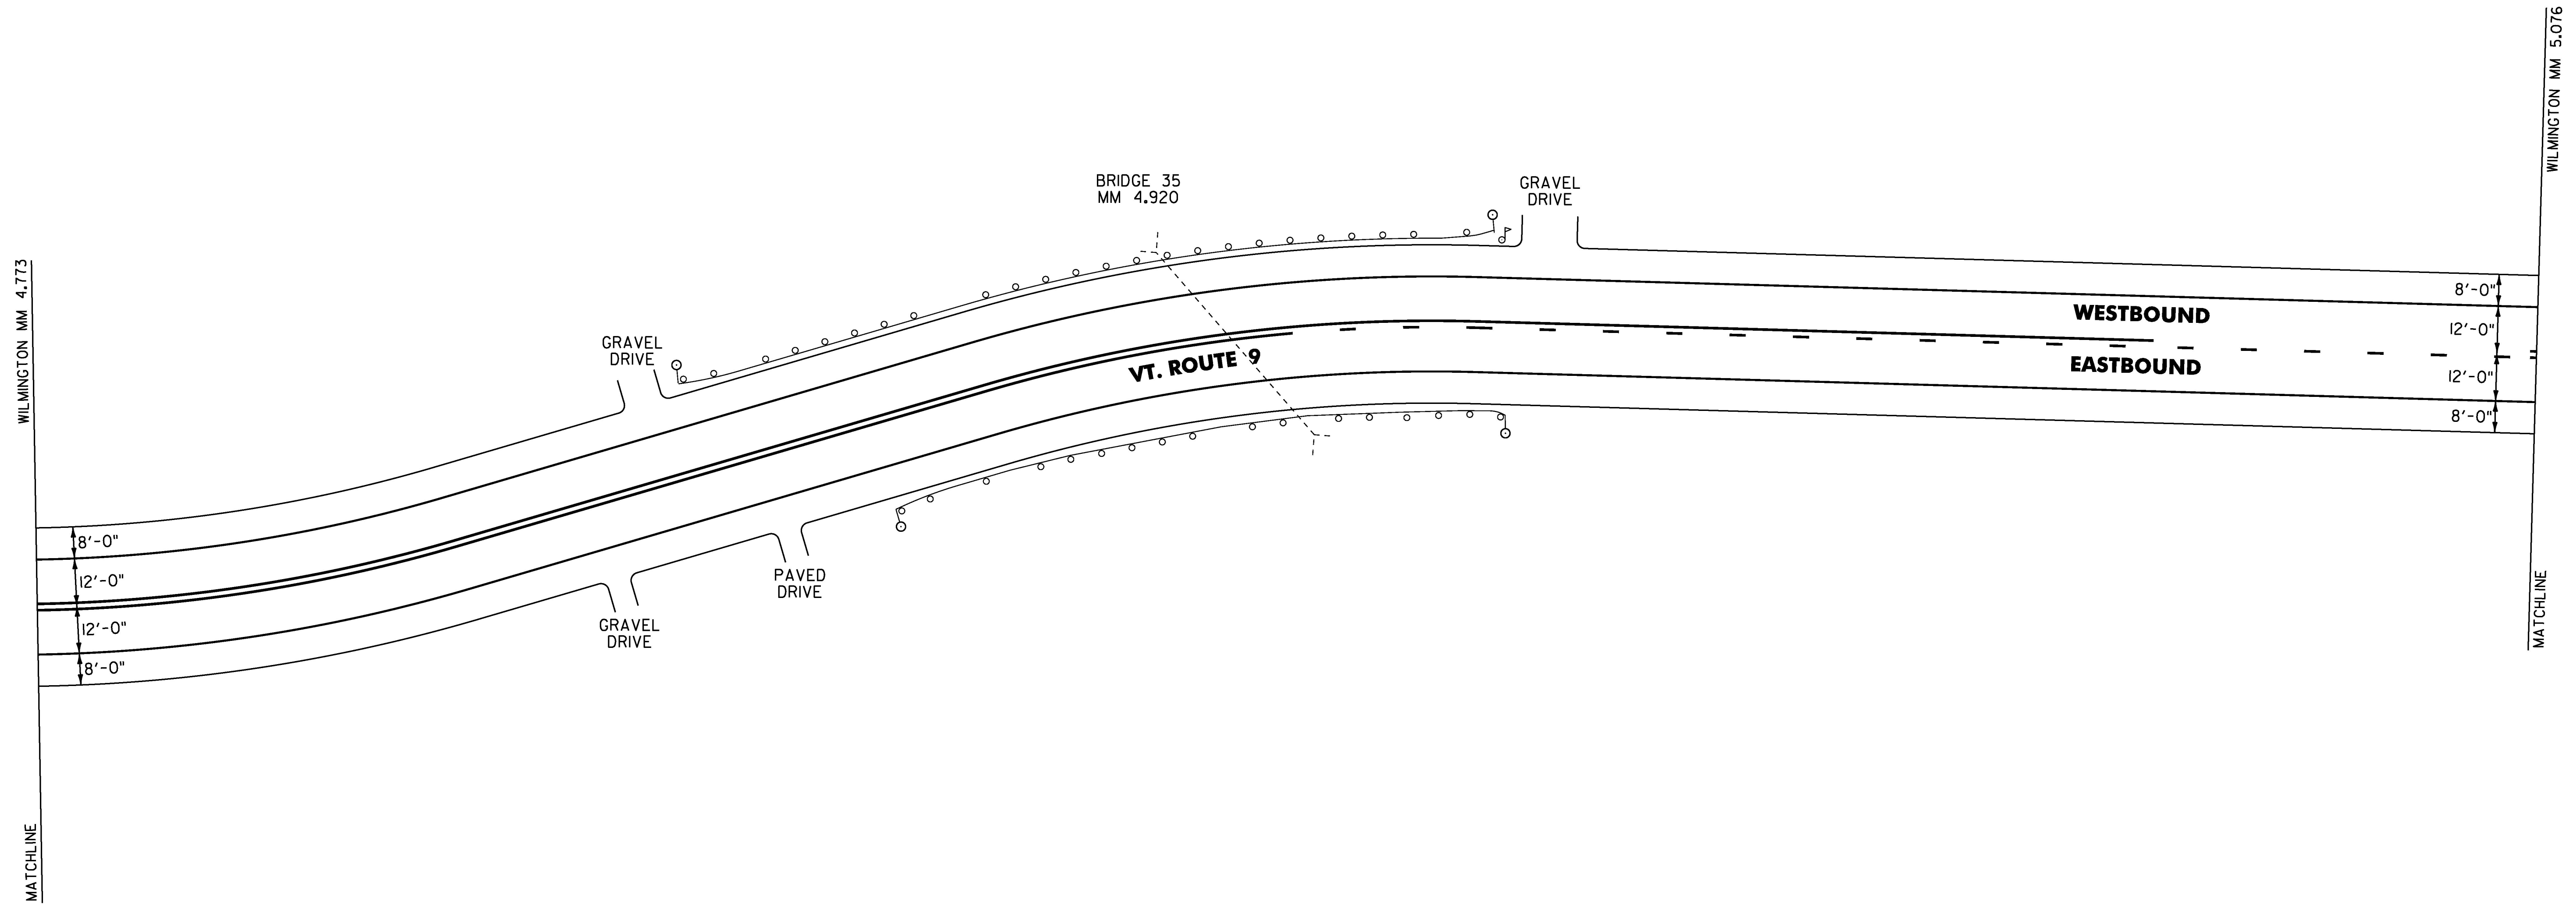

LEGEND: COLD PLANE AREA

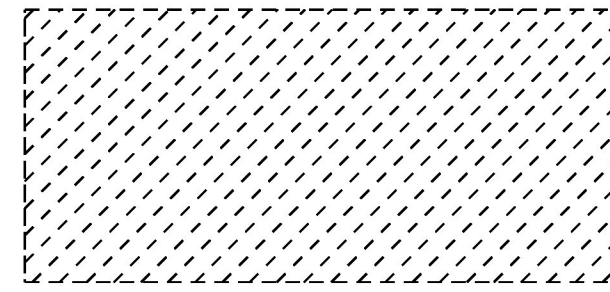

NOT TO SCALE

PROJECT NAME:	BENNINGTON-WILMINGTON
PROJECT NUMBER:	NH SURF (5I)
FILE NAME:	p14v201Bennington-Wilmington.dg
PROJECT LEADER:	M. FOWLER
DESIGNED BY:	N. PAPPAS
LAYOUT SHEET 25	
PLOT DATE:	28-MAR-2017
DRAWN BY:	N. PAPPAS
CHECKED BY:	M. FOWLER
SHEET 44	OF 64