



# STATE OF VERMONT AGENCY OF TRANSPORTATION

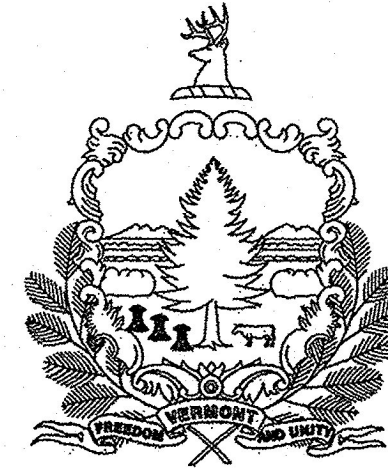




## PROPOSED IMPROVEMENT TOWNS OF JOHNSON & HYDE PARK TOWNS OF BELVIDERE, MONTGOMERY, ENOSBURG & BERKSHIRE COUNTIES OF LAMOILLE & FRANKLIN VT ROUTES 100C & 118 (MAJOR COLLECTORS)

JOHNSON - HYDE PARK  
COUNTY OF LAMOILLE  
STP SURF(52)  
SEE SHEET 11  
FOR ADDITIONAL PROJECT INFORMATION

BELVIDERE - BERKSHIRE  
COUNTIES OF LAMOILLE & FRANKLIN  
STP SURF(53)  
SEE SHEET 24  
FOR ADDITIONAL PROJECT INFORMATION

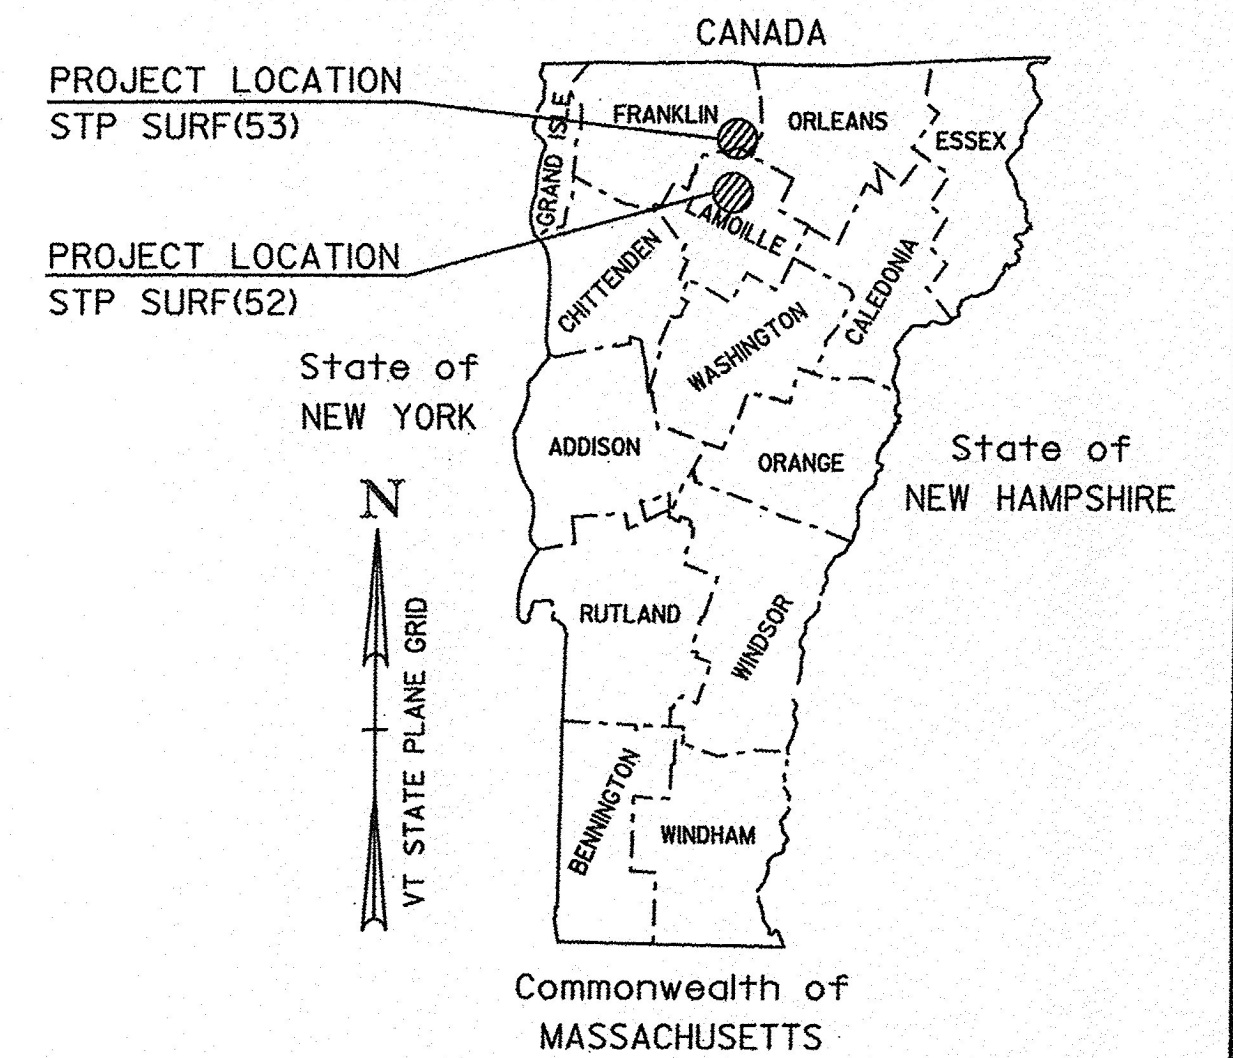

RECORD PLANS	
CONTRACTOR:	ALL STATES ASPHALT, INC. - SUNDERLAND, MA
RESIDENT ENGINEER:	DELVIN WARNER
CONSTRUCTION BEGAN:	MAY 16, 2016
CONSTRUCTION COMPLETE:	AUGUST 11, 2016
RECORD PLANS BY:	DELVIN WARNER & JESSE IVES
I HEREBY CERTIFY THAT ALL THE CONSTRUCTION REQUIRED BY THIS SET OF DRAWINGS HAS BEEN ACCOMPLISHED AS INDICATED HEREIN.	
BY <i>Delvin Warner</i>	RESIDENT ENGINEER
DATE	09-13-2018
NOTE: Any further information concerning final quantities, amounts or other details relative to this project may be found at Central Files in the electronic archives.	

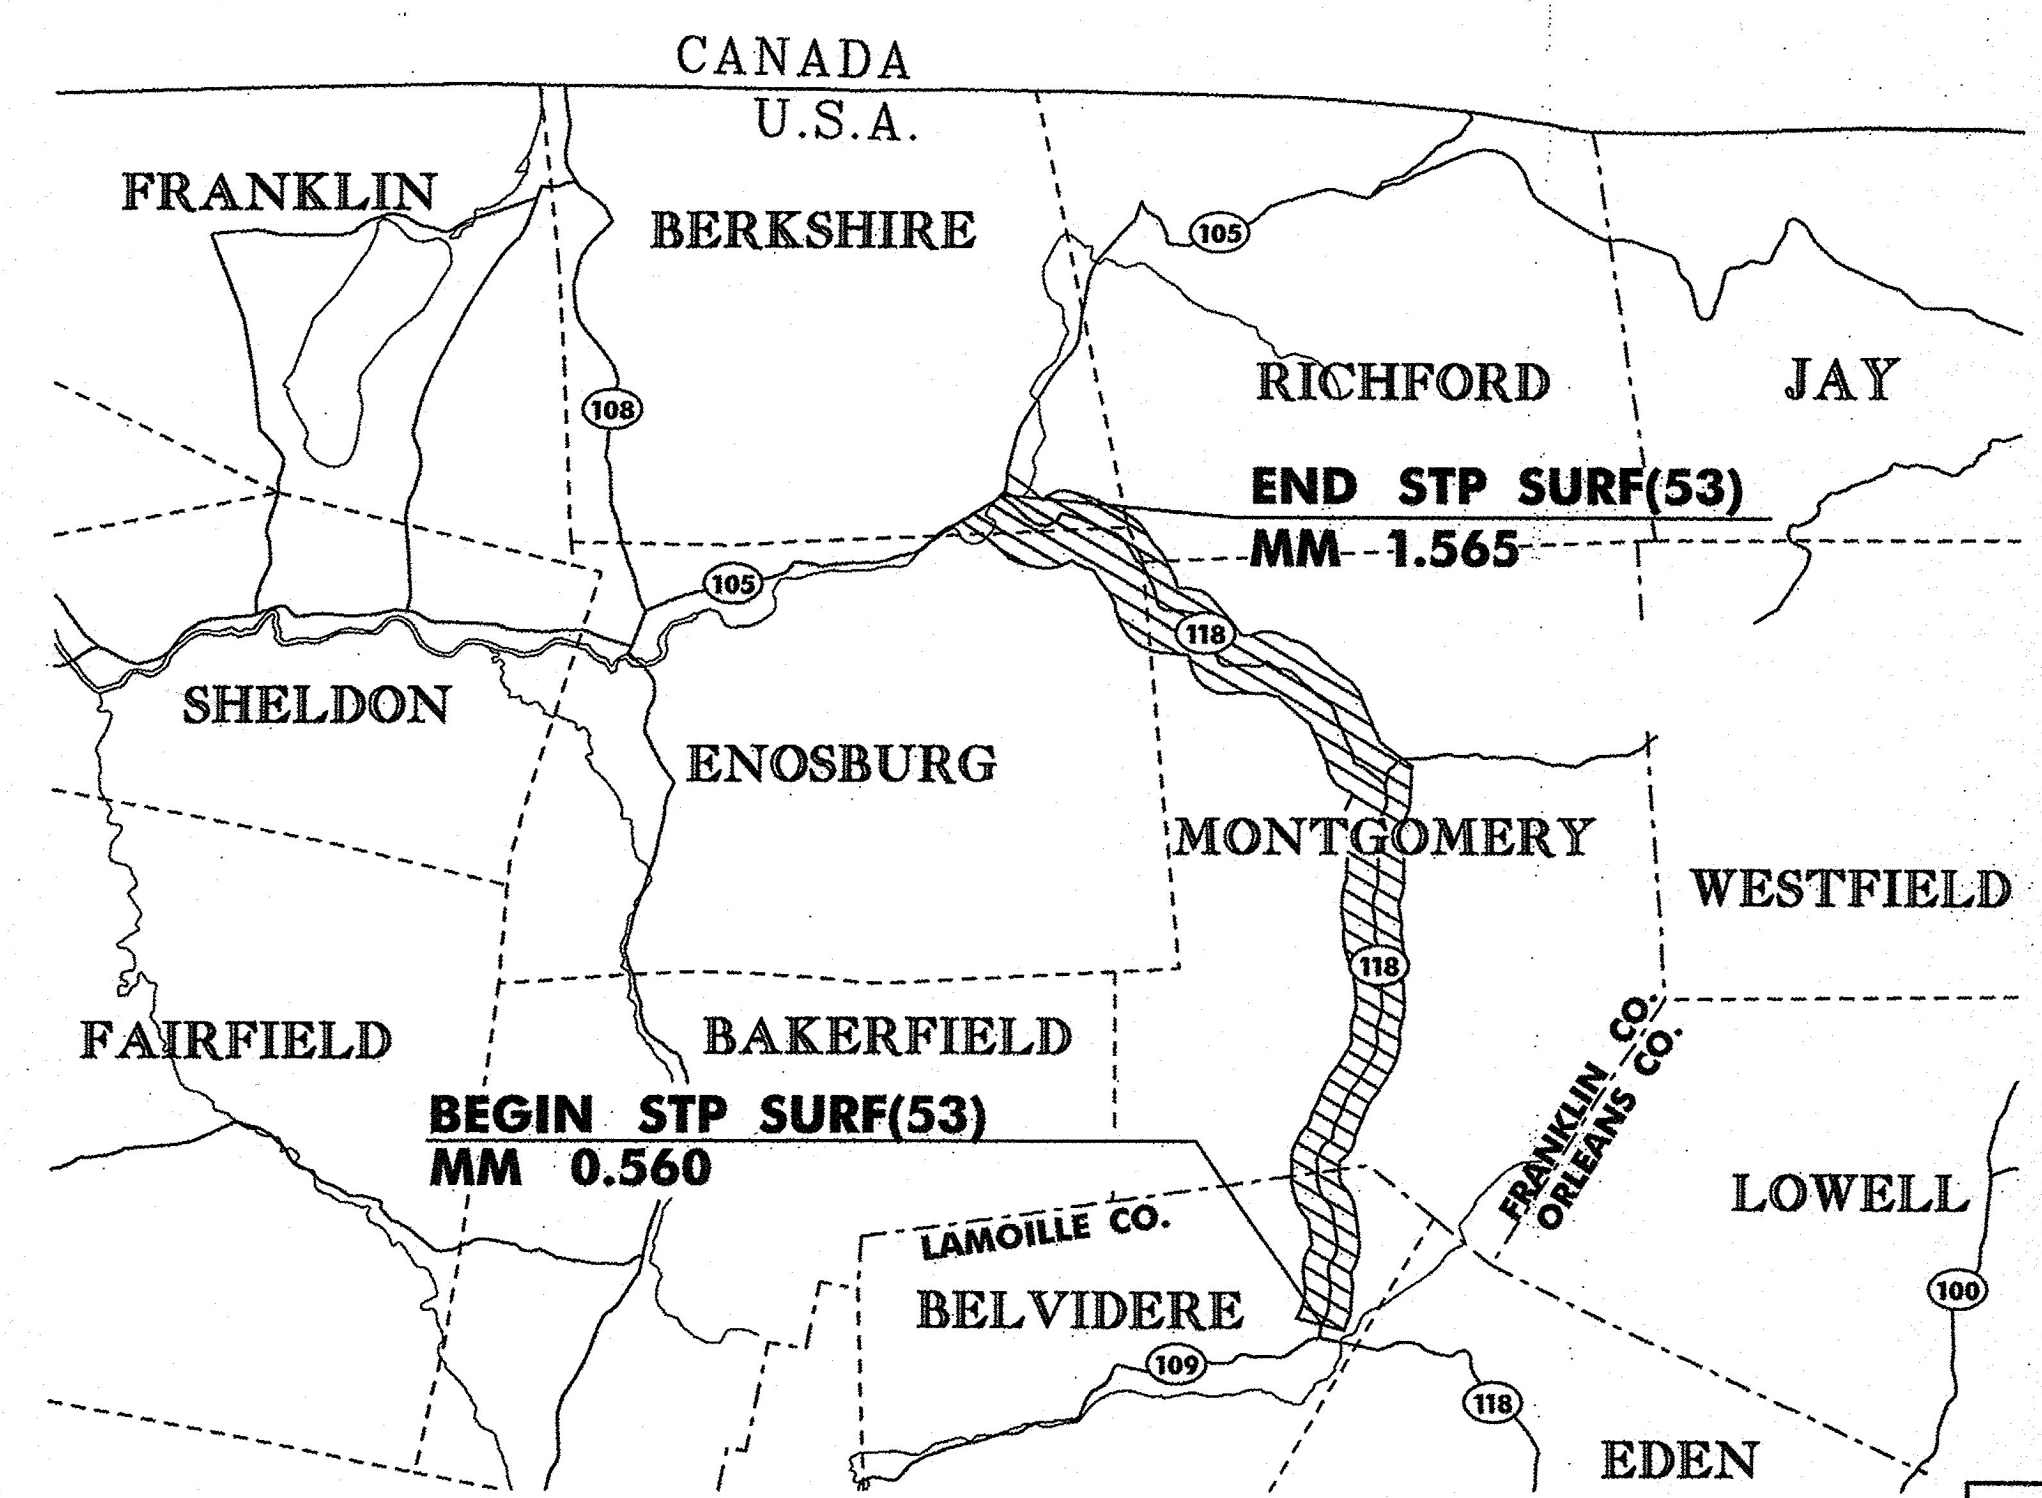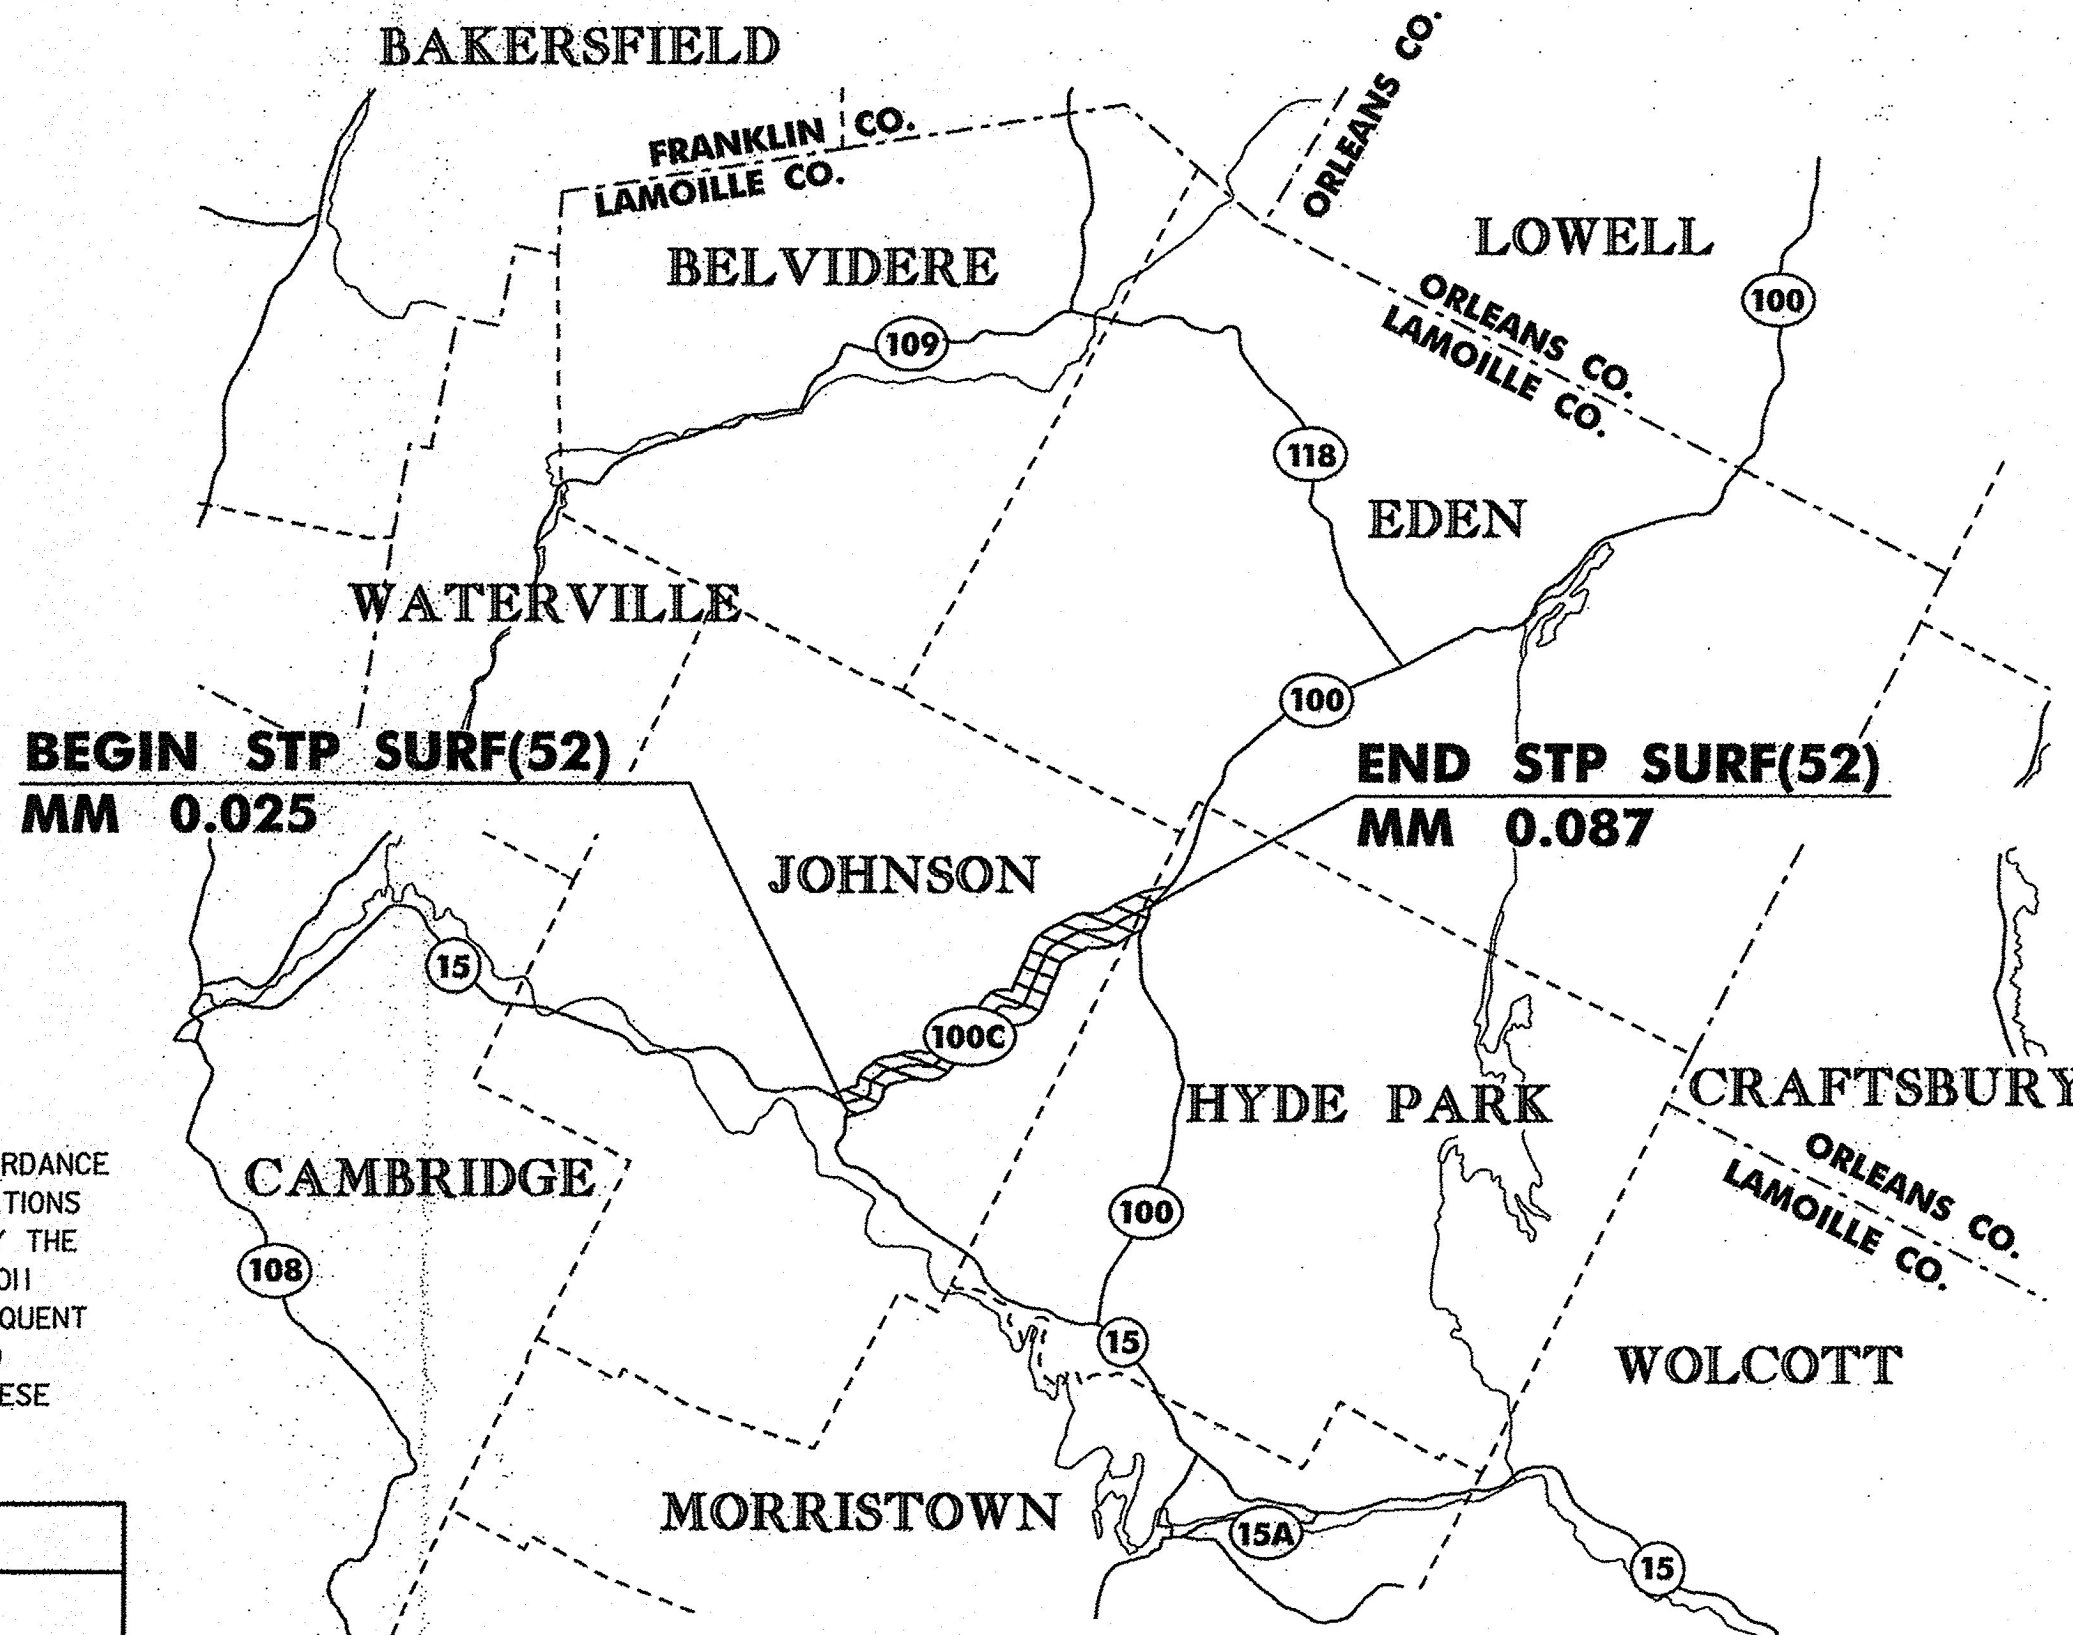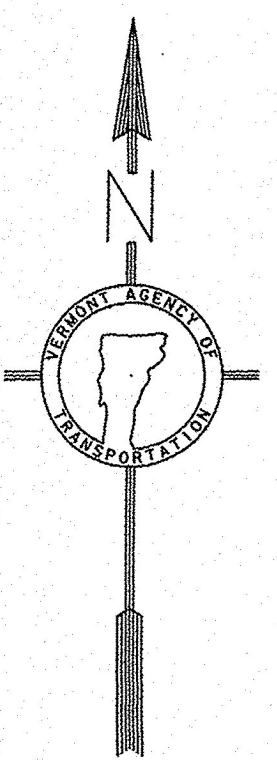

CONSTRUCTION IS TO BE CARRIED ON IN ACCORDANCE WITH THESE PLANS AND THE STANDARD SPECIFICATIONS FOR CONSTRUCTION DATED 2011, AS APPROVED BY THE FEDERAL HIGHWAY ADMINISTRATION ON JULY 20, 2011 FOR USE ON THIS PROJECT, INCLUDING ALL SUBSEQUENT REVISIONS AND SUCH REVISED SPECIFICATIONS AND SPECIAL PROVISIONS AS ARE INCORPORATED IN THESE PLANS.

QUALITY ASSURANCE PROGRAM : LEVEL 3
SURVEYED BY : N/A
SURVEYED DATE : N/A
DATUM
VERTICAL N/A
HORIZONTAL N/A

NOT TO SCALE

DIRECTOR OF PROJECT DELIVERY
APPROVED <i>[Signature]</i> DATE 10/27/2015
PROJECT MANAGER : MICHAEL J. FOWLER, P.E.
PROJECT NAME : JOHNSON - HYDE PARK BELVIDERE - BERKSHIRE
PROJECT NUMBER : STP SURF (52) , STP SURF (53)
SHEET 1 OF 45 SHEETS