



MICRO-MILL DETAIL AT BEGIN/END APPROACH
 VT I18 BELVIDERE MM 0.560
 VT I18 MONTGOMERY MM 5.565 (MIRROR IMAGE)

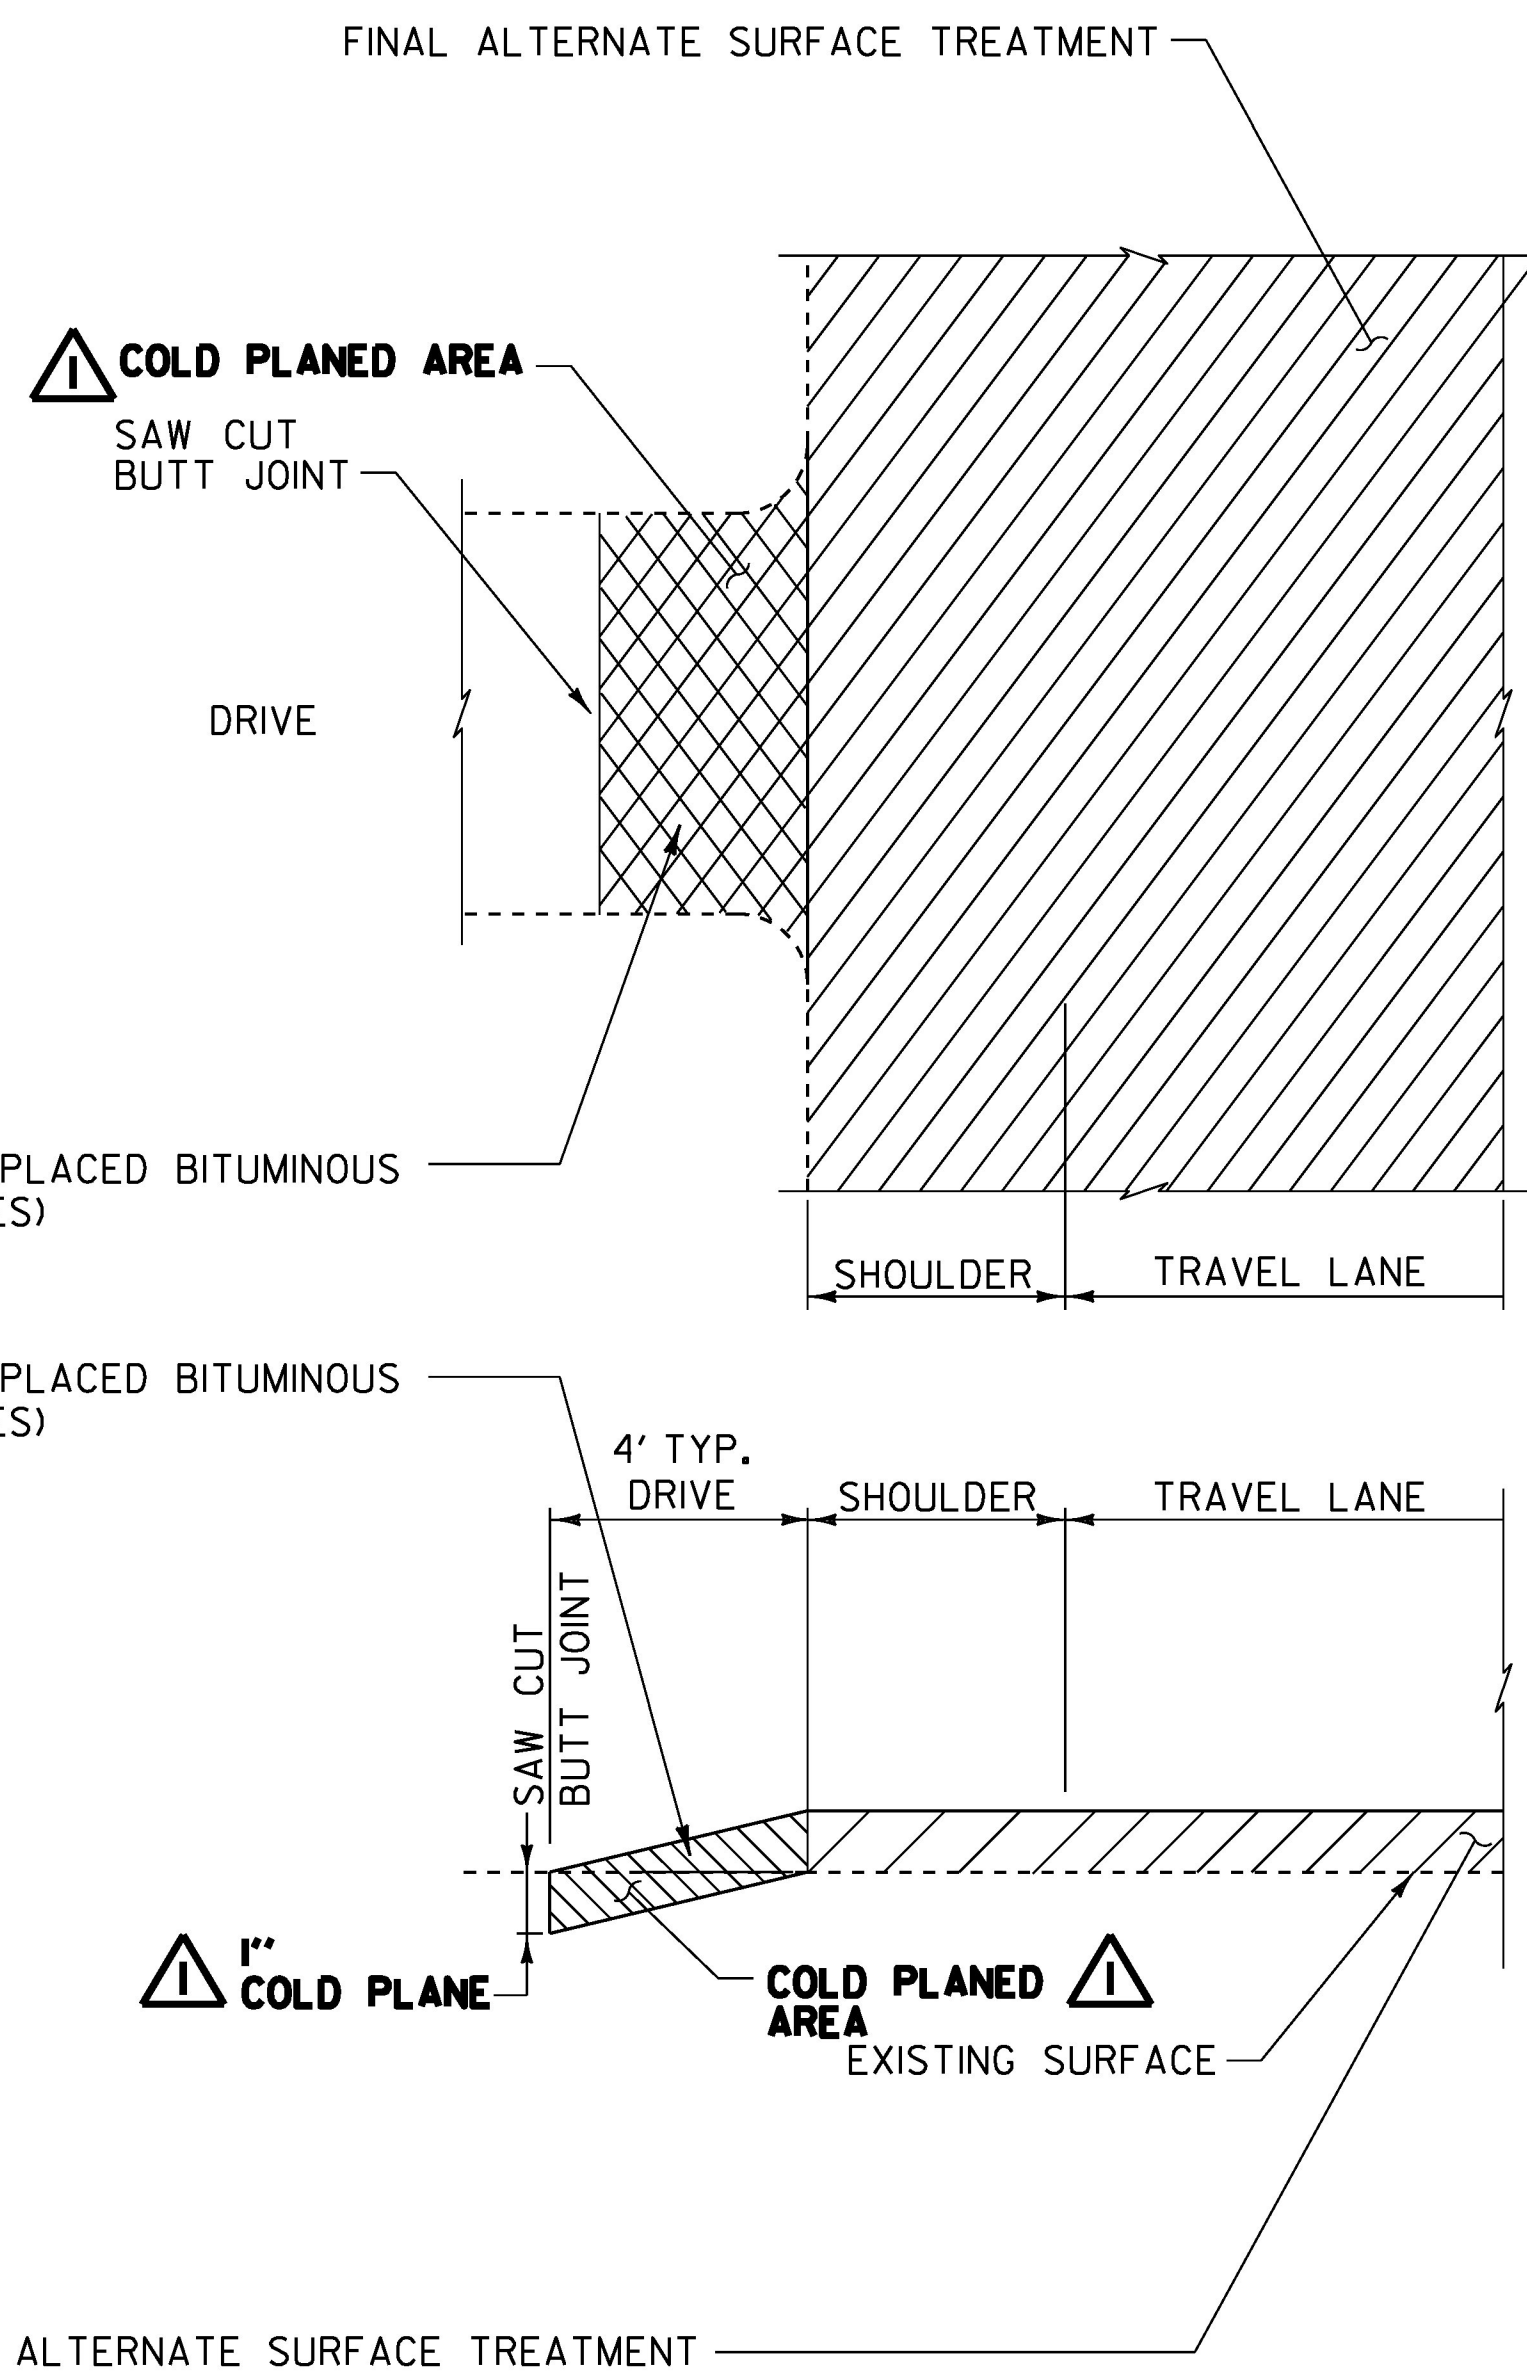

COLD PLANE DETAILS AT DRIVES

- NOTES:**
1. COLD PLANING FOR DRIVES SHALL MEET THE REQUIREMENTS OF SECTION 210 AS APPLICABLE.
 2. PAYMENT FOR COLD PLANED AREA REQUIRED FOR DRIVES SHALL BE CONSIDERED INCIDENTAL TO SPECIAL PROVISION (HAND-PLACED BITUMINOUS CONCRETE MATERIAL, DRIVES).

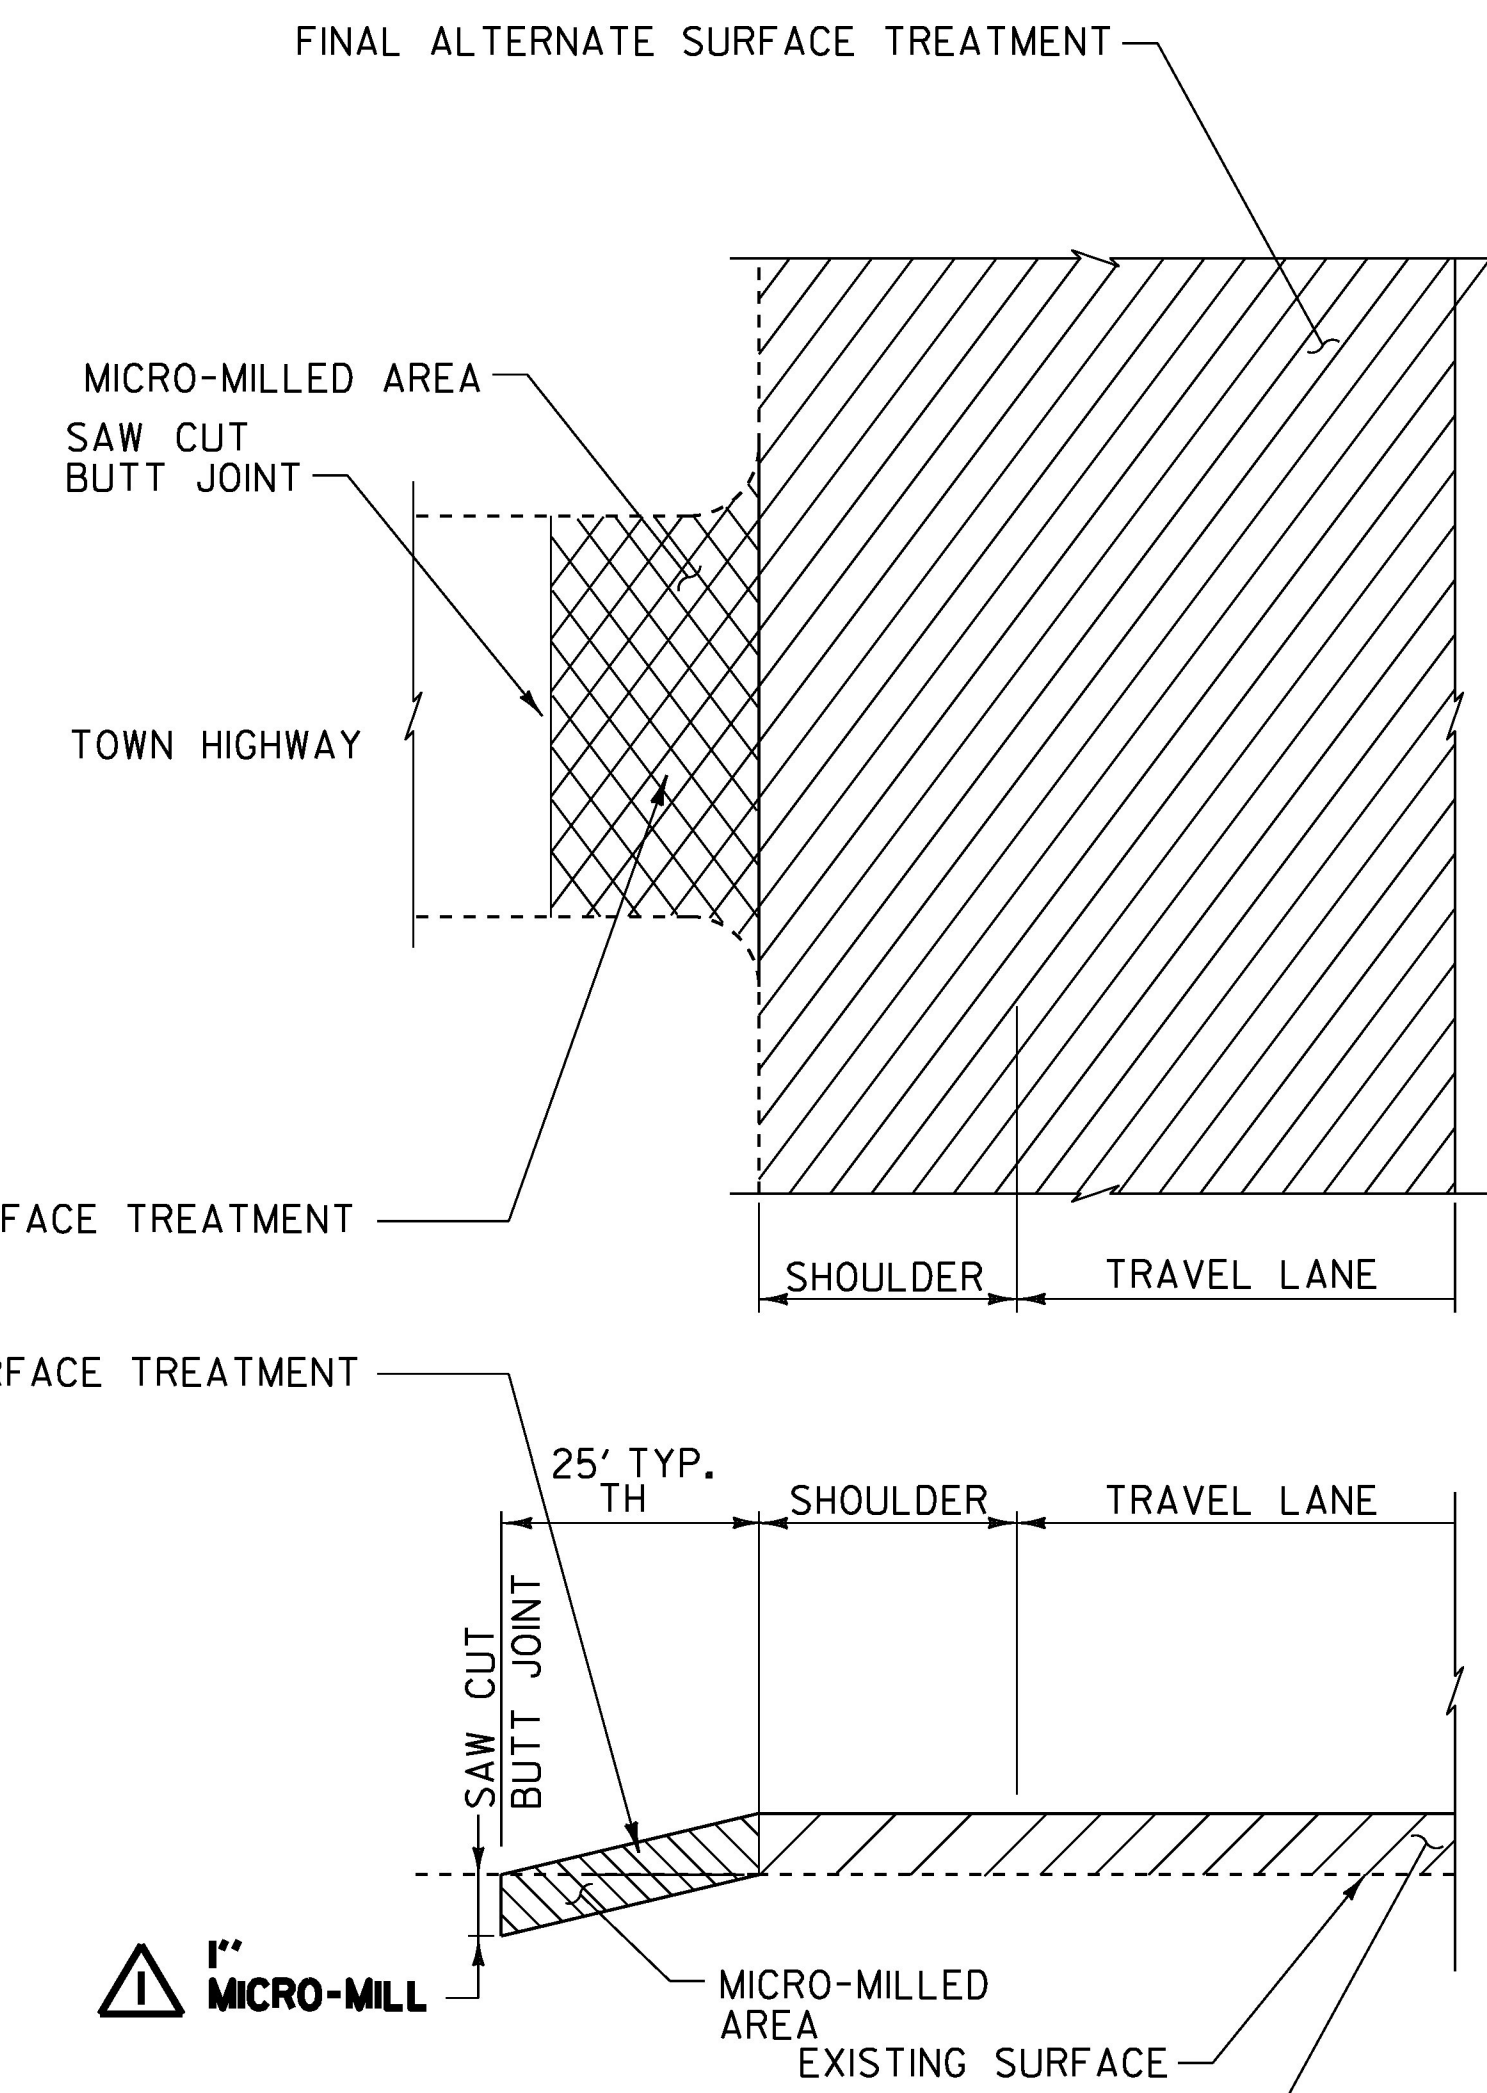

MICRO-MILL DETAILS AT TOWN HIGHWAYS

REVISION	DATE	DESCRIPTION	BY
1	01-27-16	CHANGED MICRO-MILL DEPTH TO 1" FROM 3/4". CHANGED MICRO-MILL DETAILS AT DRIVES TO COLD PLANE DETAILS AT DRIVES AND ADDED ASSOCIATED NOTES.	KML

NOT TO SCALE

PROJECT NAME: JOHNSON - HYDE PARK, BELVIDERE - BERKSHIRE
 PROJECT NUMBER: STP SURF(52), STP SURF(53)
 FILE NAME: I4v204\p14v204.dgn\p14v204_07.1 PLOT DATE: 26-JAN-2016
 PROJECT LEADER: M. FOWLER DRAWN BY: K. LOCKE
 DESIGNED BY: K. LOCKE CHECKED BY: M. FOWLER
 MICRO-MILL DETAILS SHEET 1 SHEET 7 OF 45