


MICRO-MILL DETAIL AT BEGIN/END APPROACH

VT 100C JOHNSON MM 0.025
 VT 100C JOHNSON MM 0.928 (MIRROR IMAGE)
 VT 118 BERKSHIRE MM 1.565 (MIRROR IMAGE)

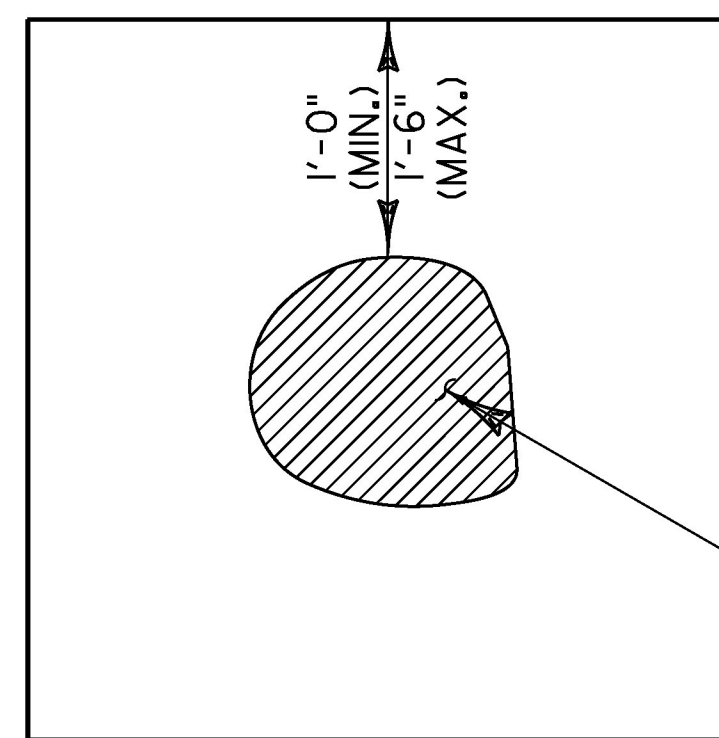

SAW CUT BITUMINOUS CONCRETE PAVEMENT

1.) EMULSIFIED ASPHALT SHALL BE APPLIED AT ALL PATCH INTERFACES AT A RATE OF 0.25 - 0.50 GAL/SY. EMULSIFIED ASPHALT SHALL MEET THE REQUIREMENTS OF SECTION 404 AND WILL BE CONSIDERED INCIDENTAL TO ITEM 900.680 SPECIAL PROVISION (BITUMINOUS CONCRETE PAVEMENT SURFACE PREPARATION, TYPE I)

2.) ALL WORK ASSOCIATED WITH POT HOLE REPAIR WILL BE PAID UNDER ITEM 900.680 SPECIAL PROVISION (BITUMINOUS CONCRETE PAVEMENT SURFACE PREPARATION, TYPE I).

EXISTING POT HOLE 3/4" MIN. DEPTH OR AS DIRECTED BY THE ENGINEER

TYPICAL - POT HOLE REPAIR

REVISION	DATE	DESCRIPTION	BY
1	01-27-16	REVISED DETAIL TO TRANSITION FROM 1" TO 3/4".	KML

NOT TO SCALE

PROJECT NAME:	JOHNSON - HYDE PARK, BELVIDERE - BERKSHIRE
PROJECT NUMBER:	STP SURF(52), STP SURF(53)
FILE NAME:	I4v204\pi4v204.dgn\pi4v204_08.I
PLOT DATE:	26-JAN-2016
PROJECT LEADER:	M. FOWLER
DRAWN BY:	K. LOCKE
DESIGNED BY:	K. LOCKE
CHECKED BY:	M. FOWLER
MICRO-MILL DETAILS SHEET 2	SHEET 8 OF 45