

TEMPORARY 4 INCH WHITE LINE, PAINT  
SPECIAL PROVISION (DURABLE 4 INCH WHITE LINE, POLYUREA)(28 MIL)  
MM 0.000 - MM 0.087 LT & RT (EDGE LINES)  
(WITH BREAKS OR RADIAT TOWN HIGHWAYS)

TEMPORARY 4 INCH YELLOW LINE, PAINT  
SPECIAL PROVISION (DURABLE 4 INCH YELLOW LINE, POLYUREA)(28 MIL)  
MM 0.000 - MM 0.087 SOLID LT & RT  
(WITH CL BREAKS AT TOWN HIGHWAYS)

TEMPORARY LETTER OR SYMBOL, PAINT  
DURABLE LETTER OR SYMBOL, OPTION ITEM  
MM 0.074 RT - "STOP" (4 EACH)  
MM 0.074 RT - "STOP" (4 EACH)


FOR ADDITIONAL LETTERS & SYMBOLS LOCATIONS SEE  
TOWN/STATE HIGHWAY INVENTORY FOR PAVING AND MARKING  
TABLE BELOW.

TEMPORARY 24 INCH STOP BAR, PAINT  
DURABLE 24 INCH STOP BAR, OPTION ITEM  
MM 0.076 RT

DELETED MARKINGS

### TOWN/STATE HIGHWAY INVENTORY FOR PAVING & MARKING

TOWN/STATE HIGHWAY NAME	LOCATION MM	MAINLINE CENTERLINE BREAK	MAINLINE EDGE LINE BREAK	TH CENTERLINE	TH EDGE LINE	TH STOP BAR	TH STOP LETTERS
JOHNSON							
TH 3 SCHOOL RD	0.375 LT	YES	YES	YES	YES	YES	YES
TH 56 GILLEN AVE	0.759 LT	YES	YES	YES	YES	YES	YES
<del>TH 35 SINCLAIR RD</del>	<del>0.942 RT</del>	<del>YES</del>	<del>YES</del>	<del>YES</del>	<del>YES</del>	<del>YES</del>	<del>YES</del>
TH 33 ROCKY RD	1.450 RT	YES	YES	YES	YES	YES	YES
TH 32 HOAG RD	1.502 LT	YES	YES	NO	NO	NO	NO
TH 68	1.881LT	NO	NO	NO	NO	NO	NO
TH 68	2.345 LT	NO	NO	NO	NO	NO	NO
TH 30 WHITCOMB ISL RD	2.686 RT	YES	YES	YES	YES	YES	YES
TH 28 WILSON RD	2.883 RT	YES	YES	YES	YES	YES	YES
TH 5 MINE RD	2.883 LT	YES	YES	YES	YES	YES	YES
TH 26 OBER HILL RD	3.336 LT	YES	YES	YES	YES	YES	YES
TH 64 BRADLEY RD	5.231LT	YES	YES	NO	NO	NO	NO

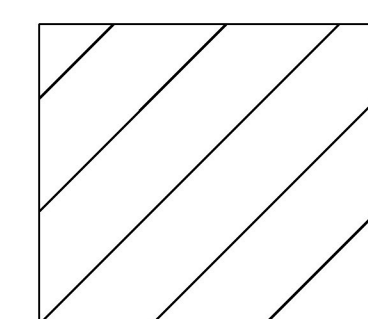

PROJECT AREA

**LEGEND**

- TWBH-THROUGHWAY BEGINS HERE
- TWEH-THROUGHWAY ENDS HERE
- SHB-STATE HIGHWAY BEGINS
- SHE-STATE HIGHWAY ENDS
- SL-SPEED LIMIT
- SA - STATE AID TOWN HIGHWAY
- T/L-TOWN LINE
- C/3 - CLASS 3 TOWN HIGHWAY
- C/4 - CLASS 4 TOWN HIGHWAY

EXTRA  
S,T,O,P

NOTES:  
1. THIS SHEET TO BE USED FOR THE LAYOUT OF ALL CENTERLINE PAVEMENT MARKINGS.  
THE ENGINEER MAY CONTACT KEITH SWEET, PAVEMENT MARKING SUPERVISOR AT  
(802) 828-5573 FOR ASSISTANCE LAYING OUT THE CENTERLINE DURING CONSTRUCTION.

**NOT TO SCALE**

PROJECT NAME: JOHNSON - HYDE PARK
PROJECT NUMBER: STP SURF(52)
FILE NAME: I4v204\pi4v204.dgn\pi4v204_15.I PLOT DATE: 04-NOV-2015
PROJECT LEADER: M. FOWLER DRAWN BY: K. LOCKE
DESIGNED BY: K. LOCKE CHECKED BY: M. FOWLER
CENTERLINE MARKING LAYOUT SHEET 2 SHEET 15 OF 45