


CHANGING ELEVATION OF DI, CB OR MH
MM 0.126 RT (DI)

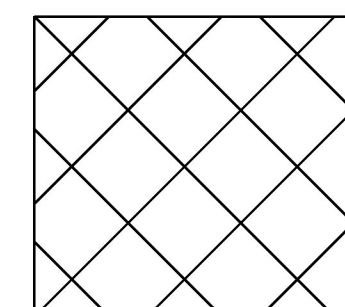

MICRO-MILL AREA

NOTES:
1. ALL GATE VALVES AND MANHOLES WITHIN THE LIMITS OF PAVING NOT IDENTIFIED AS REQUIRING ADJUSTMENT WITH THE PROJECT SHALL BE ADJUSTED BY OTHERS.

NOT TO SCALE

PROJECT NAME: JOHNSON - HYDE PARK	
PROJECT NUMBER: STP SURF(52)	
FILE NAME: I4v204\pi4v204.dgn\pi4v204_16.1	PLOT DATE: 04-NOV-2015
PROJECT LEADER: M. FOWLER	DRAWN BY: K. LOCKE
DESIGNED BY: K. LOCKE	CHECKED BY: M. FOWLER
SPECIAL MICRO-MILLING DETAILS SHEET 1	SHEET 16 OF 45